



CONTRACTOR SHOULD NOTIFY THIS ENGINEER (Jeff Ingram) IN WRITING. OUR OFFICE WILL THEN RECOMMEND THE APPROPRIATE SOLUTIONS. THE WORK WILL BE ADDRESSED IN A TIMELY MANNER BASED ON THE CURRENT WORK LOAD AT SUCH TIME ANY STRUCTURAL FRAMING THAT IS TO BE DEVIATED FROM THE CITY APPROVED PLANS MUST BE APPROVED BY ISE WITH WRITTEN DOCUMENTATION SHIPPED AND SIGNED BY ISE PRIOR TO FURTHER CONSTRUCTION AT SUCH AREA OR AREAS AFFECTED BY SUCH REVISION. FAILURE TO NOTIFY THIS ENGINEER WILL RELEASE THIS ENGINEER OF ANY LIABILITY. BY ACCEPTING THIS WORK, BOTH THE OWNER AND THE CONTRACTOR CONFIRM THE ASSISTANCE OF THEIR RESPONSIBILITIES, AS STATED HEREIN.

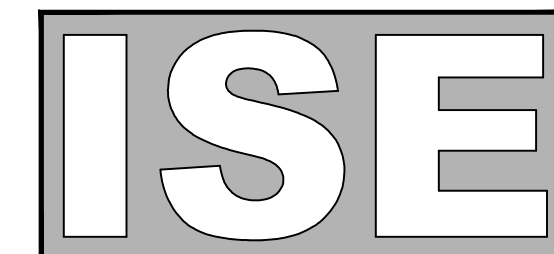

Ingram Structural Engineering
Jeff Ingram, P.E. **Yola Ingram**
 Civil Engineer Architectural Designer
 License No. C 66222 Kitchen and Bath Specialist
 E: Jeff@IngramSE.com E: Yola@IngramSE.com
 C: (408) 836-6602 C: (408) 836-6604

2570 N. First Street
 Suite 200
 San Jose, CA 95131
 www.IngramSE.com
 DesignTeam@IngramSE.com, jeff@IngramSE.com

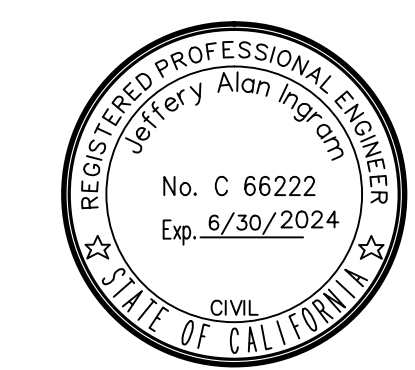

VESA RESIDENCE

Property Owners	OVIDIU VESA
Project Address	684 N Redwood Ave, San Jose, CA 95128
Phone	650-278-2869
Parcel	274-45-086
Site Area	7870 sq'±
Zoning	R-1-8 Single Family Residential City of San Jose
Setbacks	Front: 25'-0" Sides: 5'-0" Rear: 20'-0" Max Height: 35'-0"
Proposed Setbacks	Front: 25'-0" +/- (EXISTING) Right Side: 5'-0" +/- (EXISTING) Left Side: 10'-2" +/- Rear: 66'-2" +/- Blfg Height: 14'-6" +/-
Construction	Type V-B
Occupancy	R-3 & U


DATE ISSUE:

7/6/2022	PER BUILDING DEPARTMENT PLAN CHECK
1/9/2023	PER PERMIT CENTER PLANNING PLAN CHECK
1/26/2023	PER PERMIT CENTER PLANNING PLAN CHECK


THESE STRUCTURAL DRAWINGS WERE PRODUCED BY ISE. THE USE OF THESE PLANS AND SPECIFICATIONS SHALL BE RESTRICTED TO THE ORIGINAL SITE FOR WHICH THEY WERE PREPARED, AND PUBLICATION THEREOF IS EXPRESSLY LIMITED TO SUCH USE. RE-USE, REPRODUCTION, OR PUBLICATION BY ANY METHOD, IN WHOLE OR IN PART, IS PROHIBITED. FURTHERMORE, TITLE TO THE PLANS AND SPECIFICATIONS REMAINS WITH ISE. VISUAL CONTACT WITH THESE PLANS AND SPECIFICATIONS CONSTITUTE PROOF OF ACCEPTANCE OF ALL RESTRICTIONS.

Copyright © 2022 ISE Ingram Structural Engineering

PROJECT #:	21.824	SCALE:	1/4"=1'-0"
DRAWN BY:	JI		
PROJECT MANAGER:	JI		
ENGINEERED BY:	JI		
REVIEWED BY:	JI		

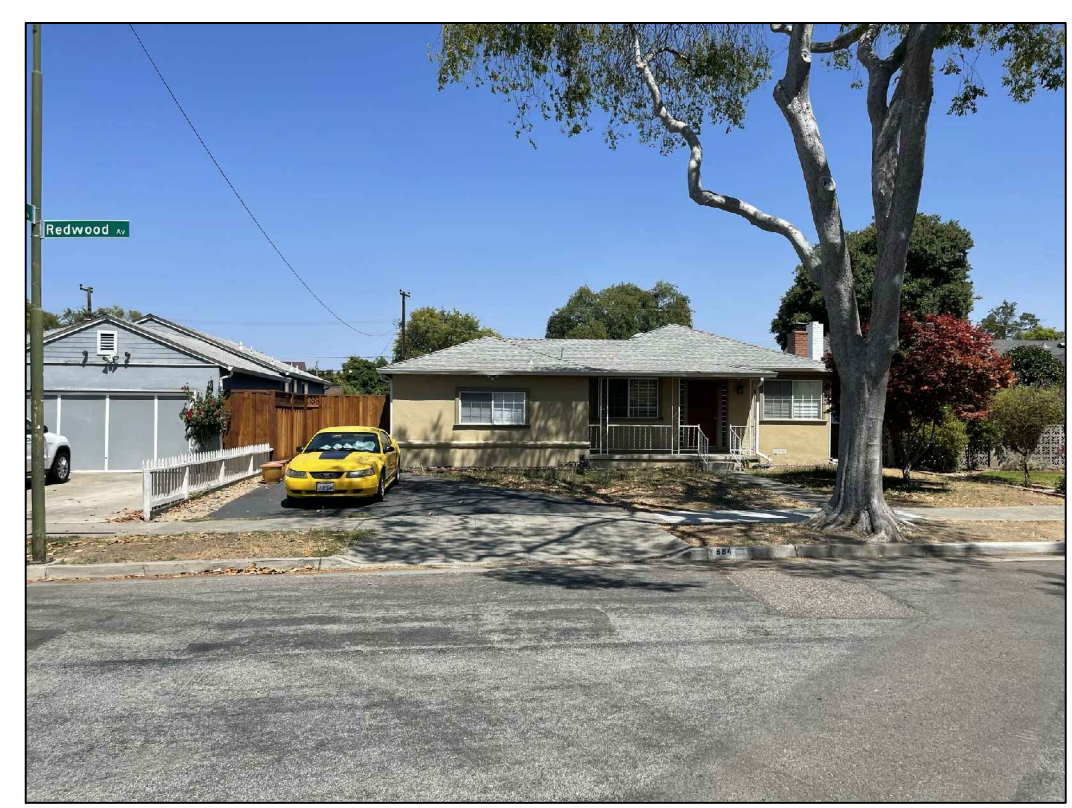



PIC #1
(E) CONDITION

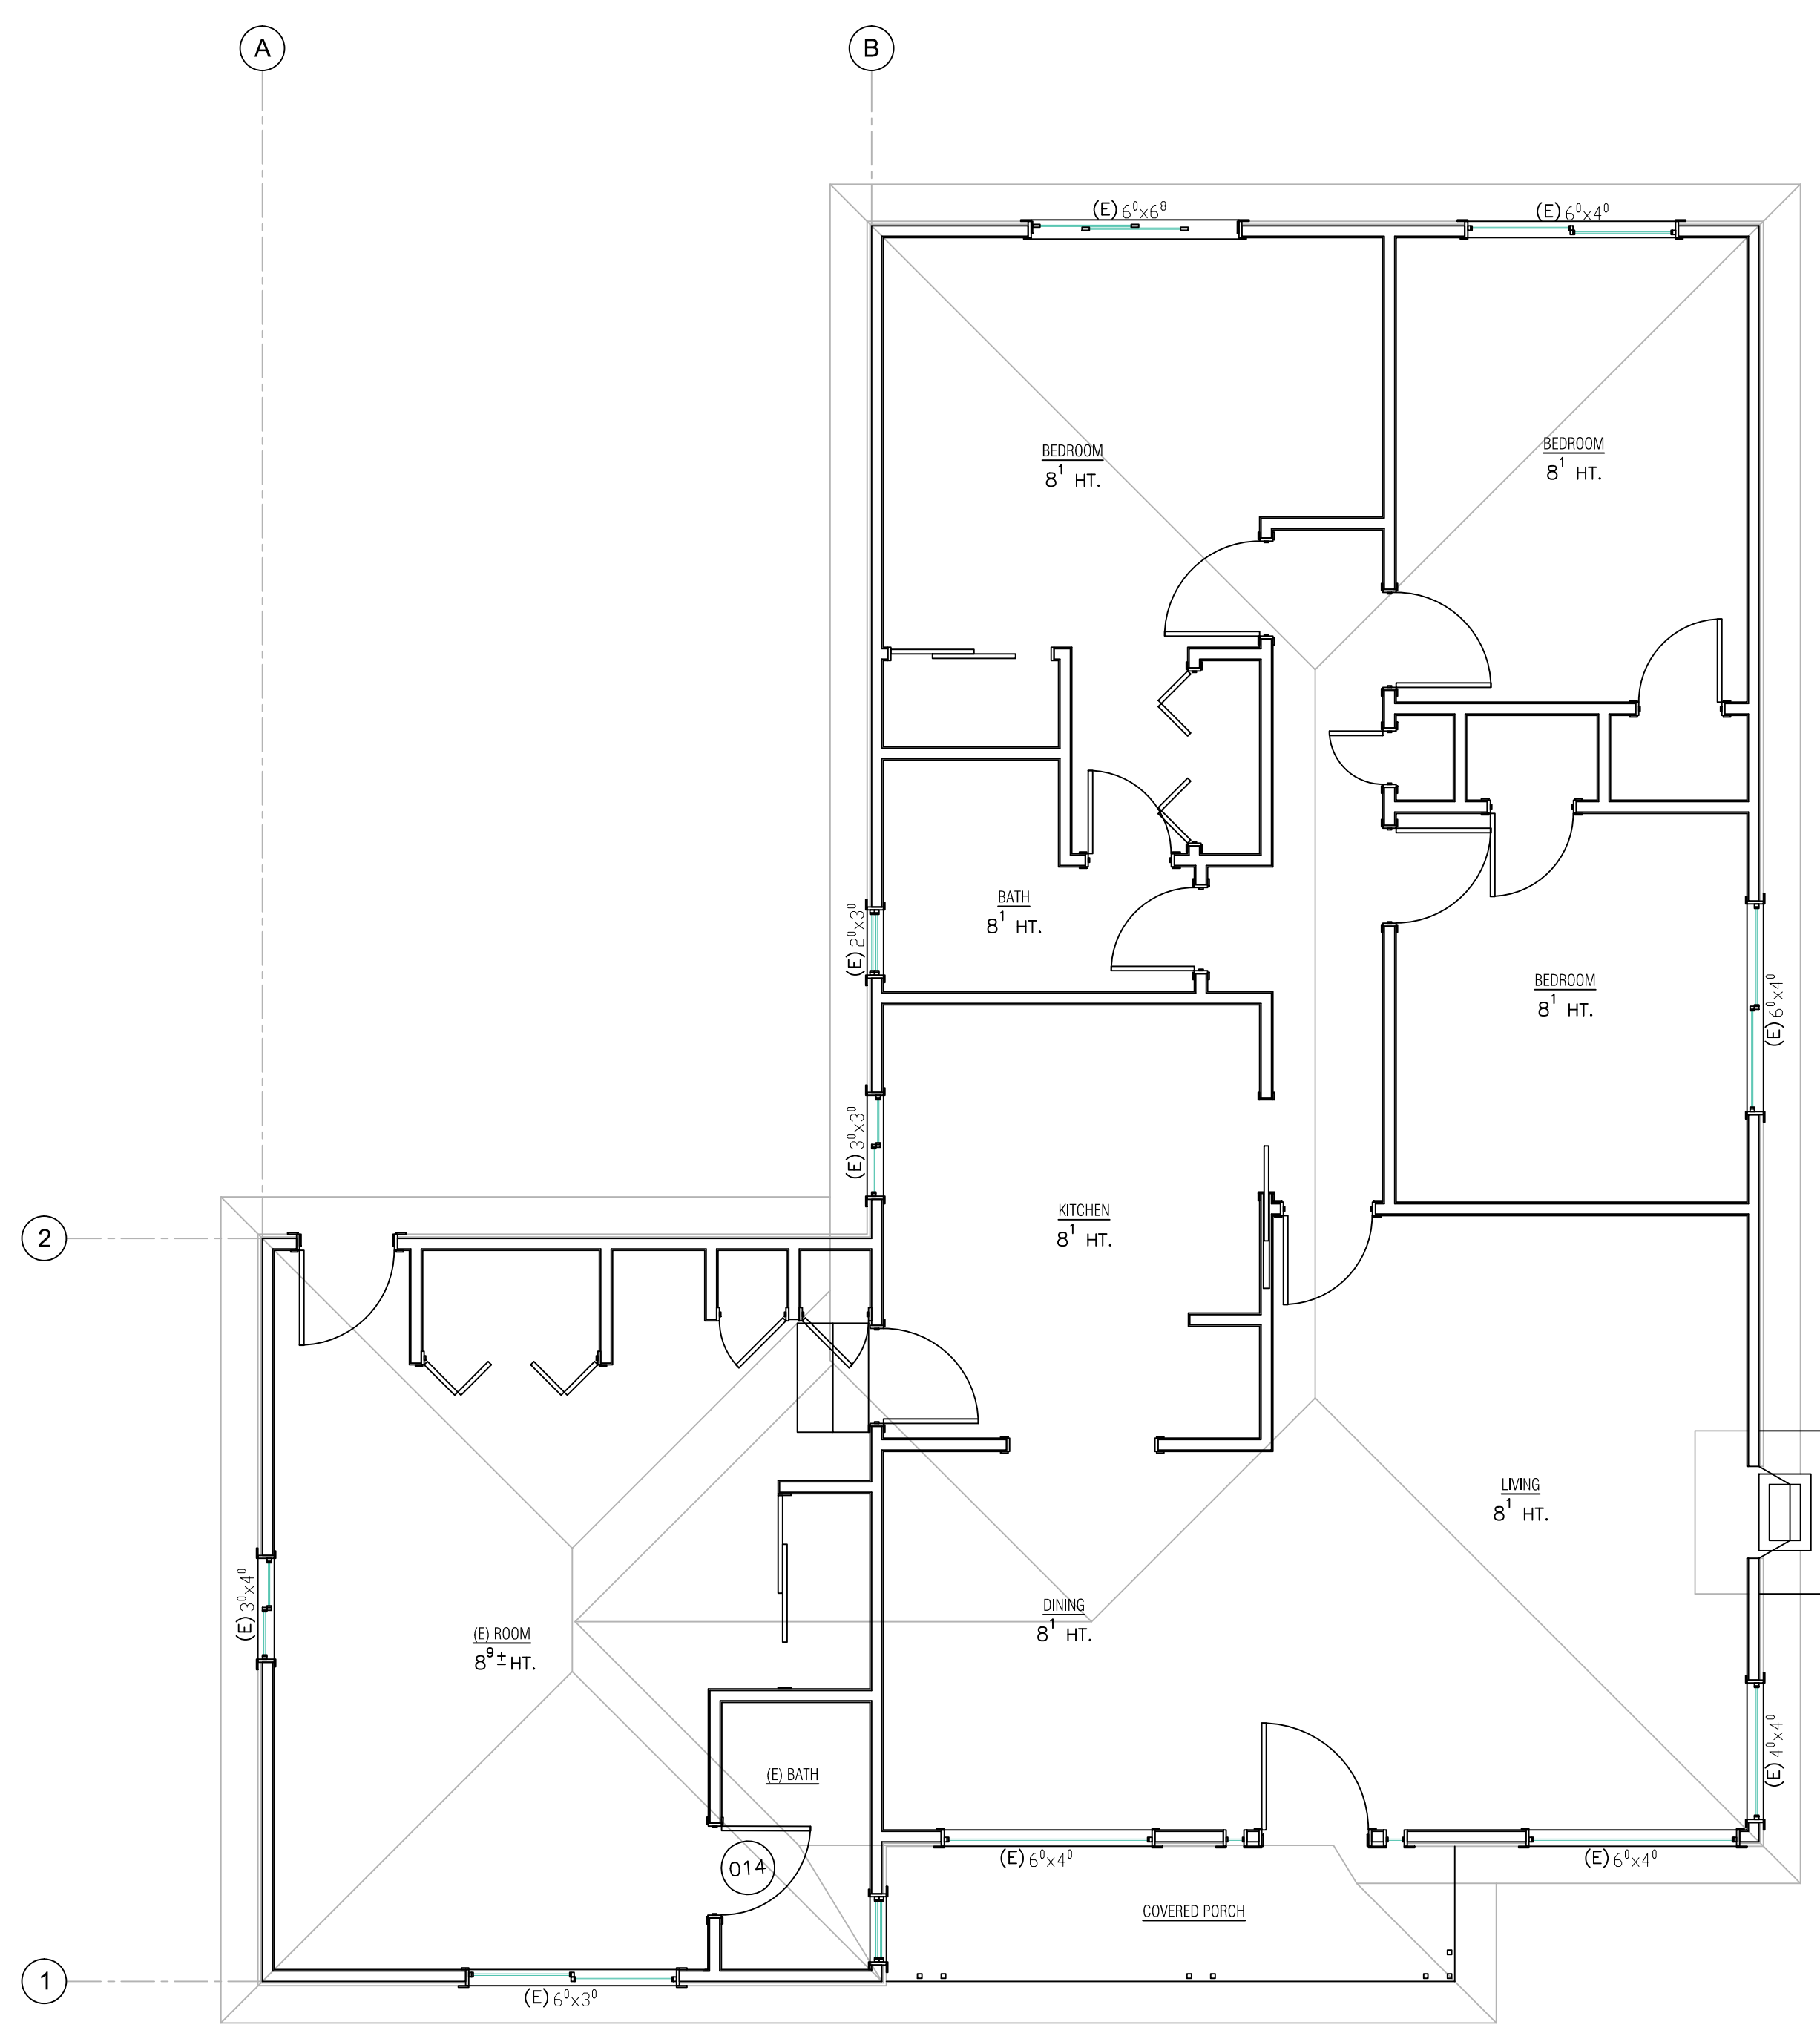

(E) Floor Plan

(E) FLOOR AREA = 1489 SQ. FEET

Scale 1/4"=1'-0"

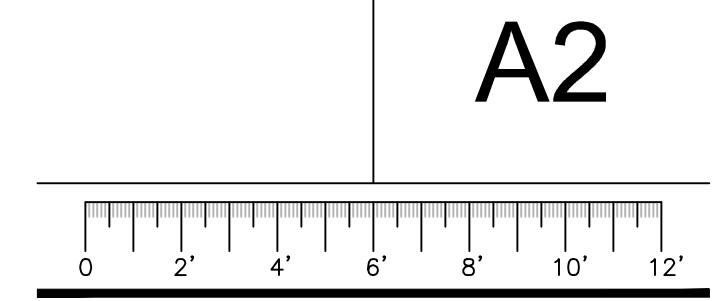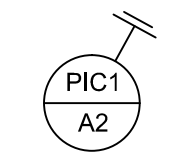

CONTRACTOR SHOULD NOTIFY THIS ENGINEER (Jeff Ingram) IN WRITING. OUR OFFICE WILL THEN RECOMMEND THE APPROPRIATE SOLUTIONS. THE WORK WILL BE ADDRESSED IN A TIMELY MANNER BASED ON THE WORKER'S SCHEDULE. FAILURE TO NOTIFY THIS ENGINEER WILL BE AT THE CONTRACTOR'S RISK. ANY STRUCTURAL FRAMING THAT IS TO BE DEVIATED FROM THE CITY APPROVED PLANS MUST BE APPROVED BY ISE WITH WRITTEN DOCUMENTATION SHOWN AND SIGNED BY THE ENGINEER. THIS ENGINEER'S DOCUMENTATION IS NOT TO BE USED FOR ANY OTHER PROJECTS.

FLOOR PLAN NOTES

F8. Attic Access
Per sec. R807.1, 2019 CRC - 22"x30" min. size or large enough for removal of hvac units. Provide 30"x24" pull attic access panel at location indicated w/ 30" min. clear headroom in the attic space or, above the access opening for access to attic furnace location, provide opening large enough for removal of hvac unit, typical.
Per sec. 904.10, 2019 CMC - Upright furnaces shall be permitted to be installed in an attic, turned, or under-floor space exceeding 5 feet (1524 mm) in height, provided the required listings and furnace and duct clearances are observed. Horizontal furnaces shall be permitted to be installed in an attic, turned, or under-floor space, provided the required listings and furnace and duct clearances are observed. Provide double 2x framing all around opening, typ., u.n.o. for access to attic furnace locations, with plywood path and platform to HVAC unit, and work light w/switch.

F9 Smoke Detector Requirements
California Residential Code CRC Section R314
Smoke detectors shall be installed per this code and in accordance with the manufacturer's installation instructions.
Dwelling units, congregated residences, hotels/motels, lodges of any kind, and guest rooms that are used for sleeping purposes must have smoke detectors. The detectors must sound an alarm that is audible in all sleeping areas of the individual dwelling unit in which they are located.
Smoke detectors and inspections are required:
- In new construction
- When one or more sleeping rooms are added or created in existing residential buildings
- Whenever an addition, alteration or repair to a house or residential unit requires a building permit (excluding issuance of a permit for exterior surface repairs such as chimney repairs and reroofing projects)

F9.1 LOCATION OF SMOKE DETECTORS
When required, smoke detectors in dwelling units are to be located:
1. In each sleeping room
2. Outside each sleeping area in the immediate vicinity of the bedrooms
3. On each additional story of the dwelling, including basements and habitable attics and not including crawl spaces and uninhabitable attics. In dwellings, or dwelling units with split levels and without an intervening door between the adjacent levels, a smoke alarm installed on the upper level shall suffice for the adjacent lower level provided that the lower level is less than one full story below the upper level.
4. Smoke alarms shall be installed not less than 3 feet horizontally from the door or opening of a bathroom that contains a bathtub or shower unless this would prevent placement of a smoke alarm required by this section.
5. Where stairs lead to other occupied levels, a smoke alarm or smoke detector shall be located so that smoke rising in the stairway cannot be prevented from reaching the smoke alarm or smoke detector by an intervening door or obstruction.
6. For tray-shaped ceilings (coffered ceilings), smoke alarms and smoke detectors shall be installed on the highest portion of the ceiling or on the sloped portion of the ceiling within 12 inches vertically down from the highest point.
7. Place a minimum of:
20 feet away from cooking appliances
3 feet away from bathrooms with tubs or showers
3 feet away from air supply registers
3 feet away from ceiling fans with paddles

F10. Void
F11. Plywood Shearwalls, & Hardi-Frames in Wall
See structural notes & details. provide shop drawings for review by engineer & designer prior to fabrication.
A. Plywood shearwalls: see foundation & framing plans for all shearwall panels & holdown locations. see shearwall schedule for edge & field nailing for shearwall panels. typical, u.n.o. B. Steel Hardi-Frames: install prefab steel Hardi-Frames in walls per manuf. specs and details where shown, typical, u.n.o.

F12. Bath Accessories
See interior elevation notes for more info. Verify all colors, sizes, finishes, etc. of bath accessories, towel bars, roll holders, medicine cabinets, etc. w/ interior designer if applicable. install as shown on interior elevations, typical, u.n.o.

F13. Finishes/Special Ceiling Treatments
A. Finishes: Verify w/owner for all wall, floor, & ceiling finishes, typical.
B. Ceiling treatments: see framing plans, cross sections, & details for all beamed, soffited, & vaulted ceilings.

F14. Thermal Insulation and Sound Insulation
All floor, wall & sound insulation to be Roxul ComfortBatt or equal formaldehyde-free fire resistant stone wool insulation.
All open cell spray foam to be Foam-Lok FL 5500 Open Cell Spray Foam Insulation by LoPolla Industries, Inc. ICC-ES ESR-2847 and installed by Certified Nozzle person for spraying foam as required by code.
a. Floors:
5-1/2" min. (R-21) unfaced Roxul ComfortBatt stone wool batts (u.n.o. by T-24 report) between all new floor joists.
b. New roofs:
7" min. (R-25) open cell spray foam between all roof rafters at entire attic & vaulted ceilings (except @garage, optional), with 3-1/2" (R-13) unfaced Roxul ComfortBatt stone wool batts between all new 2x ceiling joists, typ. u.n.o., attic ventilation not required per sec. 806.4, 2019 CRC.
c. Exterior walls:
R-15 for 2x4 walls & R-21 for 2x6 walls (u.n.o. by T-23 report) unfaced Roxul ComfortBatts stone wool batts @ new exterior walls.
d. Sound attenuating insulation @walls:
R-13 or R-15 "Rockwool" or equiv. batts at all interior "sound" walls as/typ shown on plans, or per owner, e.g. between bedrooms w/common wall, or wall between both & bedroom.

F15. Natural Lighting and Ventilation
Per Sec. 1203.4.1, 1205.2, 2019 CBC.
(A) Lighting: Windows shall provide natural light of 8% of the room area, or 10 square feet minimum.
(B) Ventilation: Natural ventilation shall be provided by means of operable exterior openings with an area not less than 4% of the room area, or 5 sq. feet minimum. Mechanical ventilation is permitted in lieu of natural ventilation.

F16. Shelve and pole, or as per Contractor "closet set"
F17. Typical Interior Door (nominal size noted), style & manufacturer selected by owner.

F18. Individual Shower and Tub-shower Combination Control Valves:
(A) Per 408.3 CBC: Showers and tub-shower combinations shall be provided with individual control valves of the pressure balance, thermostatic, or combination pressure balance/thermostatic mixing valve type that provide scald and thermal shock protection for the rated flow rate of the installed showerhead. These valves shall be installed at the point of use and comply with ASSE 1016/ASME A112.1016/CSA B125.16 or ASME A112.18.1/CSA B125.1.
(B) Per CBC 2406.4.5: Glazing and Wet Surfaces: Safety glazing required at tub/shower enclosure & doors, windows with lower edge 60" or less from tub/shower floor, less than 24" of door swing, bottom edge less than 8" from floor or ground or exposed area larger than 9 sq. feet. Provide "X" or "Z" Tub or shower pan w/tilt to 72" from floor; shower head @76" and temp. glass enclosure.
(C) Shower Compartment: Min. finished interior area for showers shall be 1024 square inches and encompassing a minimum 30 inch circle.

F19. Bedrooms:
(A) Min. one window or door to meet egress requirements.
(B) Natural lighting & ventilation requirements shall be met.
(C) AFCI (Arc-Fault Circuit Interrupter) required for all receptacle outlets installed in bedrooms
ALL (N) EXIT DOORS: EXIT DOORS SHALL BE OPENABLE FROM THE INSIDE WITHOUT THE USE OF A KEY OR SPECIAL KNOWLEDGE OR EFFORT.

F21. AIR CONDITIONING:
AIR CONDITIONING CONDENSING UNITS Refer to ENERGY CALCULATIONS.

F22. Glazing Adjacent to Doors:
Per sec. 2406.4.2 CBC. Glazing in an individual fixed or operable panel adjacent to a door where the nearest vertical edge of the glazing is within a 24"-inch (610 mm) arc of either vertical edge of the door in a closed position and where the bottom exposed edge of the glazing is less than 60 inches (1524 mm) above the walking surface shall be considered to be a hazardous location.
Exceptions:
1. Decorative glazing.
2. Where there is an intervening wall or other permanent barrier between the door and glazing.
3. Where access through the door is to a closet or storage area 3 feet (914 mm) or less in depth. Glazing in this application shall comply with Section 2406.4.3.
4. Glazing in walls on the latch side of and perpendicular to the plane of the door in the closed position in one- and two-family dwellings or within dwelling units in Group R-2

F9 SHEET SMOKE ALARMS- CRC 314

INSTALL SMOKE ALARMS IN EACH SLEEPING ROOM; OUTSIDE EACH SEPARATE SLEEPING AREA IN THE IMMEDIATE VICINITY OF THE BEDROOMS; AND ON EACH ADDITIONAL STORY OF THE DWELLING INCLUDING BASEMENTS AND HABITABLE ATTICS

CARBON MONOXIDE ALARMS- CRC 315

INSTALL CO ALARMS OUTSIDE OF EACH SEPARATE DWELLING UNIT SLEEPING AREA IN THE IMMEDIATE VICINITY OF THE BEDROOMS; AND ON EVERY LEVEL OF THE DWELLING UNIT INCLUDING BASEMENTS

F1. Egress
F1.2 Emergency escape and rescue opening required
Per sec. R310.1, 2019 CRC Basements, habitable attics and every sleeping room shall have not less than one operable emergency escape and rescue opening. Where basements contain one or more sleeping rooms, an emergency escape and rescue opening shall be required in each sleeping room. Emergency escape and rescue openings shall open directly into a public way, or to a yard or court that opens to a public way.
Exception: Storm shelters and basements used only to house mechanical equipment not exceeding a total floor area of 200 square feet (18.58 m²).

F1.3 Operational constraints and opening control devices
Per sec. R310.1.1 2019 CRC Emergency escape and rescue openings shall be maintained free of any obstructions other than those allowed by this section and shall be operational from the inside of the room without the use of keys, tools or special knowledge. Window opening control devices complying with ASTM F2090 shall be permitted for use on windows serving as a required emergency escape and rescue opening.

F1.4 Minimum opening area
Per sec. R310.2.1 2019 CRC Bedrooms shall be provided with an emergency egress window or door to satisfy the following:
(A) Minimum net clear opening of 5.7 square feet (except at grade floor or below grade openings shall have a net clear opening of NOT less than 5 square feet)
(B) Minimum net clear opening height of 24 inches.
(C) Minimum net clear opening width of 20 inches.

F1.5 Window Sill Height
Per sec. R310.2.2 2019 CRC Where a window is provided as the emergency escape and rescue opening, it shall have the bottom of the clear opening not greater than 44 inches (1118 mm) measured from the floor; where the sill height is below grade, it shall be provided with a window well in accordance with Section R310.2.3.

F1.5 Window Wells
Per sec. R310.2.3 The horizontal area of the window well shall be not less than 9 square feet (0.9 m²), with a horizontal projection and width of not less than 36 inches (914 mm). The area of the window well shall allow the emergency escape and rescue opening to be fully opened.

Exception: The ladder or steps required by Section R310.2.3.1 shall be permitted to encroach not more than 6 inches (152 mm) into the required dimensions of the window well.

F1.5 Ladder and Steps
Per sec. R310.2.3.1 Window wells with a vertical depth greater than 44 inches (1118 mm) shall be equipped with a permanently affixed ladder or steps usable with the window in the fully open position. Ladders or steps required by this section shall not be required to comply with Sections R311.7 and R311.8. Ladders or rungs shall have an inside width of not less than 12 inches (305 mm), shall project not less than 3 inches (76 mm) from the wall and shall be spaced not more than 18 inches (457 mm) on center vertically for the full height of the window well.

F1.6 Drainage
Per sec. R310.2.3.2 Window wells shall be designed for proper drainage by connecting to the building's foundation drainage system required by Section R405.1 or by an approved alternative method.
Exception: A drainage system for window wells is not required where the foundation is a well-drained soil sand-gravel mixture soils in accordance with the United Soil Classification System, Group I Soils, as detailed in Table R405.1.

F2 Water-resistant gypsum backing
F2.1 Backing Board
Per sec. R702.3.7, 2019 CRC - Gypsum board used as the base or backer for adhesive application of ceramic tile or other required nonabsorbent finish material shall conform to ASTM C1396, C1178 or C1278. Use of water-resistant gypsum backing board shall be permitted on ceilings. Water-resistant gypsum board shall not be installed over a Class 1 or II vapor retarder in a shower or tub compartment. Cut or exposed edges, including those at wall intersections, shall be sealed as recommended by the manufacturer.

F2.2 Tile and Backing Limitations
Per sec. R702.3.7.1, 2019 CRC - Water-resistant gypsum backing board shall not be used where there will be direct exposure to water, or in areas subject to continuous high humidity. NO GYPSUM BOARD ALLOWED! Provide water resistant 5/8" Dens-Shield by Georgia-Pacific or 1/4" HardieBacker board by JamesHardie, or asphalt saturated felt paper, 2/ 2x6 at all water splash areas, typical, u.n.o.

F2.3 Ceramic Tile Backer
Per sec. R702.4.2 2019 CRC Materials used as backers for wall tile in tub and shower areas and wall panels in shower areas shall be of materials listed in table R702.4.2, and installed in accordance with the manufacturer's recommendations.

F3. Post in Wall
See foundation & framing plans, typical. install double studs, 4x and 6x d.f. posts in walls where shown & required. see details & structural drawings for holdown specs, typical, u.n.o.

F4. One Hour Firewall at Dwelling/Garage Walls/Ceilings/Carport
F4.1 Separation
F4.1.1 - One Hour Firewall at Ceiling or Walls of Garage, and Under Stairs per 2019 CRC, sec. R302.6 and Table R302.6

Dens-Glass Code: Fire-rated 5/8" type 'X' one hour, rated gyp. bd. fire-rated assemblies shall have all joints and nail heads taped with taping compound per sec. 2508.4, 2019 CBC at:
a) All walls and ceilings/beams of garage, or up common wall between garage and living space to underside of roof sheathing system (including through crickets), and
b) At all wall and ceiling of storage space under interior stairs
All penetrations in common fire wall shall be protected by an approved firestop as tested per 2019 CRC sec. R302.4.1.2.
Ducts in the garage and ducts penetrating the common firewall shall be made of 26 gauge sheet metal or other approved materials, and shall have no openings into the garage per 2019 CRC sec. R302.5.2. "Seal all penetrations w/fire caulking for the full depth of the gyp sheathing, and recess any penetrations with 5-side sheetrock box, e.g. (at can lights, laundry boxes, electrical panels)"
Garage Fire Rated Door w/automatic self closer, self latching and tight fitting per sec. R302.5.1 2019 CRC and sec. 406.1.4 2019 CBC. New 1-3/4" thick solid core point grade wood exterior grade 20 min. fire rated door with dark bronze anodized aluminum threshold and weather-stripping at head and jamb.

F4.1.2 -Openings in garage walls shall comply with Section R302.5. Attachment of gypsum board shall comply with Table R702.3.5. The wall separation provisions of Table R302.5 shall not apply to garage walls that are perpendicular to the adjacent dwelling unit wall. A separation is not required between the dwelling unit and a carport, provided the carport is entirely open on two or more sides and there are not enclosed areas above.

a) From the residence and attics - Not less than 1/2-inch gypsum board or equivalent applied to the garage side
b) From habitable rooms above the garage or carport - Not less than 5/8-inch Type X gypsum board or equivalent
c) Structure's supporting floor/ceiling assemblies used for separation required by this section - Not less than 1/2-inch gypsum board or equivalent
d) Garages located less than 3 feet from a dwelling unit on the same lot Not less than 1/2-inch gypsum board or equivalent applied to the interior side of exterior walls that are within this area

F5. Bathubs/showers and Enclosures
Per sec. R307.2 and sec. R702.3.7.1, 2019 CRC - Bathub and shower floors and walls above bathtubs with installed shower heads and in shower compartments shall be finished with a nonabsorbent surface.
All wall & ceiling tile to be installed w/ water-proofing, or moisture resistant underlayment (per note #2 above) to a height of 72" min. above drain inlet. see interior elevations for more info. where shown on plan, provide/install clear 7/16" thick clear TEMPERED Starphire frameless glass door or equal and enclosures w/hardware & trim per owner's specs., typ., u.n.o see plumbing schedule & electrical/mechanical plan sheet A-3.0 for more info.

Shower shall have a min. finished interior floor area of 1024 square inches, and encompassing a 30 inch circle
The minimum required area and dimensions shall be measured at a height equal to the top of the threshold and a point tangent to its centerline.
The area and dimensions shall be maintained to a point of not less than 70 inches above the shower drain outlet with no protrusions or other than the fixture or valves, showerheads, soap dishes, shelves, and safety grab bars, or rails.
Fold-down seats in accessible shower stalls shall be permitted to protrude into the 30 inch circle.
Provide non-absorbant material under tubs and in tub/shower enclosures.

A. Typical bathroom shower: Job-built shower w/ tile floors, curbs, walls, niches, & stone slab seat w/hot mop pan to +18" high on walls & st drain per "a", typical, u.n.o.
C. Bathub: @ bath 60" long x 32" enameled cast iron soaking tub and shower combo as selected by owner, with tile walls to ceiling, typical, u.n.o.

F6. Cabinetry, Fixtures, Closet Packages, and Appliances
Contractor & cabinet maker shall verify all final design details & materials w/owner as well as all room dimensions & rough openings for fixtures & appliances, prior to fabrication & installation, typical, u.n.o.


F7. Crawl Space Access
Per sec. R408.4, 2019 CRC. Provide 18" x 24" min. access where shown w/ double 2x framing all around opening. see foundation plan for more info. typical, u.n.o.

Safety glazing (tempered) is required at the following locations:
1. Windows adjacent to and within 24 inches of either edge of door.
2. Any glass in any door.
ALL (N) EXIT DOORS: EXIT DOORS SHALL BE OPENABLE FROM THE INSIDE WITHOUT THE USE OF A KEY OR SPECIAL KNOWLEDGE OR EFFORT.

WINDOW SCHEDULE			
Quantity	MARK	SIZE	
		WIDTH	HEIGHT
1	001	5'-11"	4'-0"
1	002	5'-11"	4'-0"
1	003	4'-0"	4'-0"
1	004	5'-11"	4'-0"
1	(N)005	2'-0"	2'-6"
1	(N)006	5'-10"	2'-10"
1	(N)007	6'-0"	5'-0"
1	(N)008	4'-0"	5'-0"
1	(N)009	6'-0"	5'-0"

DOOR AND FRAME SCHEDULE					
Quantity	MARK	WD	HGT	DOOR SIZE	
				THK	
1	010	4'-6"	6'-8"	1	3/4"
1	011	2'-6"	6'-8"	1	3/4"
1	012	2'-6"	6'-8"	1	3/4"
1	(N)014	2'-4"	6'-8"	1	3/4"
1	(N)015	2'-0"	6'-8"	1	3/4"
1	(N)016	3'-0"	6'-8"	1	3/4"
1	(N)019	3'-0"	6'-8"	1	3/4"
1	(N)020	2'-8"	6'-8"	1	3/4"
1	(N)021	2'-4"	6'-8"	1	3/8"
1	(N)022	7'-2"	6'-8"	1	3/4"
1	(N)023	5'-0"	6'-8"	1	3/4"


DOOR AND FRAME SCHEDULE					
Quantity	MARK	WD	HGT	DOOR SIZE	
				THK	
1	001	3'-0"	6'-8"	1	3/4"
1	002	2'-6"	6'-8"	1	3/4"
1	003	2'-6"	6'-8"	1	3/4"
1	004	2'-6"	6'-8"	1	3/4"
1	005	2'-8"	6'-8"	1	3/4"
1	006	1'-6"	6'-8"	1	3/4"
1	007	2'-8"	6'-8"	1	3/4"
1	008	6'-0"	6'-8"	1	3/4"
1	009	6'-0"	6'-8"	1	3/4"

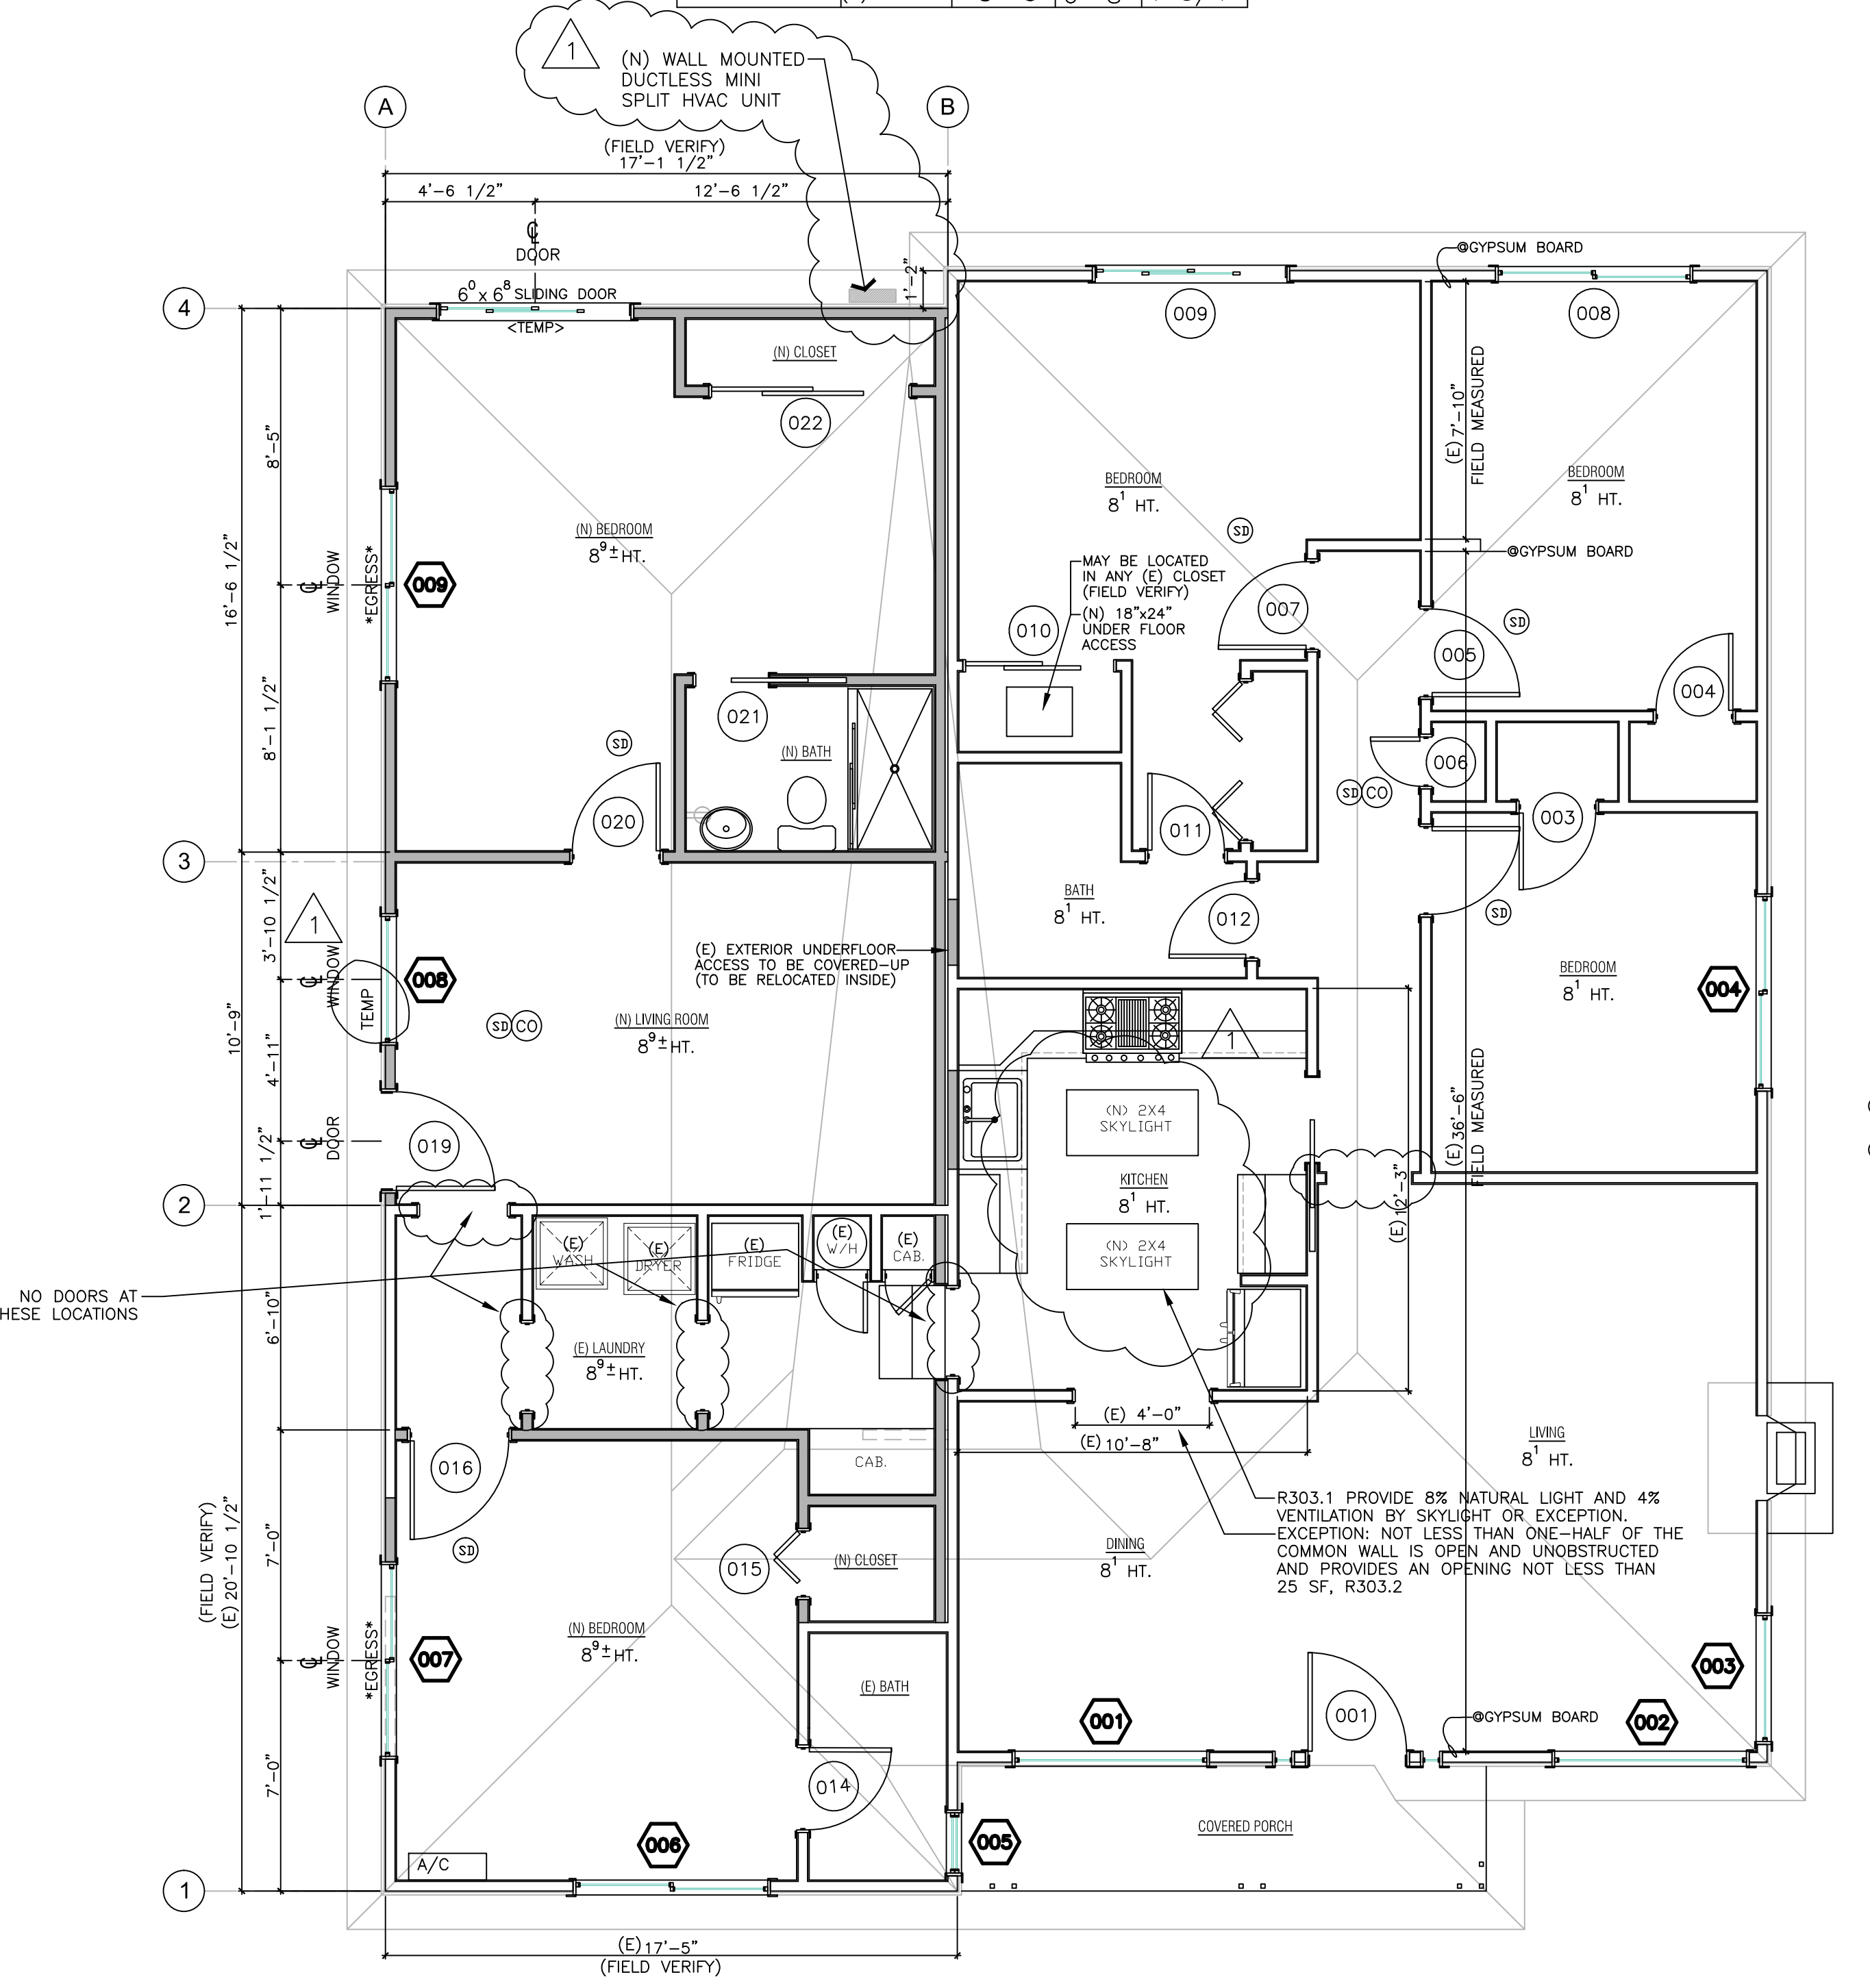

(N) Floor Plan

Scale 1/4"=1'-0"

WALL DIMENSIONS SHOWN ARE TAKEN ABOUT THE STUD EDGE @ROUGH FRAME, TYP. U.O.N.

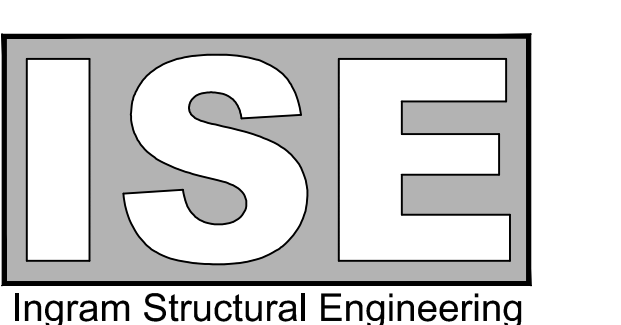

Jeff Ingram, P.E.
Civil Engineer
License No. C 66222
E: Jeff@IngramSE.com
C (408) 836-6602

Yola Ingram
Architectural Designer
Kitchen and Bath Specialist
E: Yola@IngramSE.com
C (408) 836-6604

2570 N. First Street
Suite 200
San Jose, CA 95131
www.IngramSE.com
DesignTeam@IngramSE.com, jeff@IngramSE.com



VESA RESIDENCE

Property Owners OVIDIU VESA
Project Address 684 N Redwood Ave, San Jose, CA 95128
Phone 650-278-2869
Parcel 274-45-086
Site Area 7870 ft²
Zoning R-1.8 Single Family Residential City of San Jose
Setbacks Front: 25'-0"
Sides: 5'-0"
Rear: 20'-0"
Max Height: 35'-0"
Proposed Setbacks Front: 25'-0" +/- (EXISTING)
Right Side: 5'-0" +/- (EXISTING)
Left Side: 10'-2" +/-
Rear: 66'-2" +/-
Blfg Height: 14'-6" +/-
Construction Type V-B
Occupancy R-3 & U

DATE ISSUE:


7/6/2022
1/9/2023 PER BUILDING DEPARTMENT PLAN CHECK
1/26/2023 PER PERMIT CENTER PLANNING PLAN CHECK

THESE STRUCTURAL DRAWINGS WERE PRODUCED BY ISE. THE USE OF THESE PLANS AND SPECIFICATIONS SHALL BE RESTRICTED TO THE ORIGINAL SITE FOR WHICH THEY WERE PREPARED, AND PUBLICATION THEREOF IS EXPRESSLY LIMITED TO SUCH USE. RE-USE, REPRODUCTION, OR PUBLICATION BY ANY METHOD, IN WHOLE OR IN PART, IS PROHIBITED. FURTHERMORE, TITLE TO THE PLANS AND SPECIFICATIONS REMAINS WITH ISE. VISUAL CONTACT WITH THESE PLANS AND SPECIFICATIONS CONSTITUTE PROOF OF ACCEPTANCE OF ALL RESTRICTIONS.
Copyright © 2022 ISE Ingram Structural Engineering

PROJECT #: 21.824 SCALE: 1/4"=1'-0"
DRAWN BY: JI
PROJECT MANAGER: JI
ENGINEERED BY: JI
REVIEWED BY: JI

(N) Floor Plan

A3

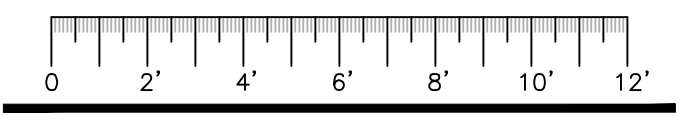


CONTRACTOR SHOULD NOTIFY THIS ENGINEER (Jeff Ingram) IN WRITING. OUR OFFICE WILL THEN RECOMMEND THE APPROPRIATE SOLUTIONS. THE WORK WILL BE ADDRESSED IN A TIMELY MANNER BASED ON THE CURRENT WORKLOAD AT SUCH TIME. ANY STRUCTURAL FRAMING SHALL BE DEVIATED FROM THE CITY APPROVED PLANS MUST BE APPROVED BY USE. WITH WRITTEN DOCUMENTATION SHOWN AND SIGNED BY USE PRIOR TO FURTHER CONSTRUCTION AT SUCH AREA OR AREAS AFFECTED BY SUCH REVISION. FAILURE TO NOTIFY THIS ENGINEER WILL RELEASE THIS ENGINEER OF ANY LIABILITY. BY ACCEPTING THIS WORK, BOTH THE STRUCTURAL FRAMING CONTRACTOR AND THE ARCHITECT AGREE TO HOLD EACH OTHER HARMLESS FROM THE LIABILITY OF THEIR RESPECTIVE PROFESSIONS, AS STATED HEREIN.


APPLIANCE SCHEDULE

- All appliances to be supplied and installed by Contractor per manufacturer specs, typical. Verify all appliance model #'s & required rough openings w/owner prior to ordering cabinetry. Appliances listed below are an example, actual appliances to be selected by the home owner.
- A1 Gas Rangetop**
Install per manuf. specs. 110v dedicated circuit 30" wide GE PROFILE, or equiv. 6 burner gas rangetop (griddle and grille inserts) Sealed Burner Gas Rangetop in Stainless Steel.
 - A2 Kitchen Exhaust Hood**
Requires 10" dia. duct - install per manuf. specs with duct to exterior roof mounted vent termination & remote blower Vent-A-Hood 42" Stainless Steel 900 CFM Wall Mounted Liner insert with Dual Blowers and Halogen Lights 36" x 19" stainless steel exhaust hood liner insert installed per manuf. specs, typical. See mech. notes for more info.
 - A3 Kitchen Microwave Oven**
Install per manuf. specs GE SpaceMaker II microwave oven or equivalent, in stainless steel. verify with cabinet maker regarding ordering trim kit. Install with 110v- 15 amp dedicated circuit.
 - A4 Kitchen Refrigerator and Freezer**
GE PROFILE 36" wide or equiv. Refrigerator provide 110v -15 amp dedicated circuit, and filtered cold water line for automatic ice maker.
 - A6 Kitchen and Pantry Dishwashers**
Install per manuf. specs. install with 110v- 15 amp dedicated circuit. GE PROFILE dishwasher w/ cabinet overlay @ Kitchen, Stainless @ Pantry. Provide an approved air gap fitting on the discharge side of the dish washer, per sec. 807.4, 2019 C.P.C.
 - A7 Kitchen Ovens**
220v- 40 amp dedicated circuit: GE PROFILE 30" wide or equiv. Single Oven Steam Oven True Convection Ovens. Steam oven over Single oven, all in stainless steel. install with trim kit per manuf. specs.
 - A7 Kitchen Ovens**
220v- 40 amp dedicated circuit. GE PROFILE 30" wide or equiv. Single Oven & Steam Oven True Convection Ovens. Steam oven over Single oven, all in stainless steel. install with trim kit per manuf. specs.
 - A8 Pantry Double Oven**
220v- 40 amp dedicated circuit. GE PROFILE or equiv. Double Oven 30" wide True Convection oven over conventional oven in stainless steel. install w/trim kit per manuf. specs.
 - A9 Garbage Disposals**
In-Sink-Erator or equiv. 1.0 hp garbage disposal One each at kitchen sink, kitchen veggie sink, and pantry sink, typical.
 - A12 Ice Maker**
Energy Star Provide filtered water hookups with accessible butterfly valve shutoff at ice maker location per plan and plumbing specs, typical, u.n.o. provide 110v electric-20amp dedicated circuit, typical, u.n.o.
- CR3 R311.3 Floors and Landings at Exterior Doors.**
There shall be a landing on floor on each side of each exterior door. The width of each landing shall not be less than the door served. Every landing shall have a dimension of not less than 36 inches measured in the direction of travel. The slope at exterior landings shall not exceed 1/4 unit vertical in 12 units horizontal (2 percent).
- Per Section R311.3.1 Floors elevations at the required egress doors.
Landings or finished floors at the required egress door shall not be more than 1-1/2" lower than the top of the threshold.
Exception: The landing or floor on the exterior side shall be not more than 7-3/4" below the top of the threshold provided the door does not swing over the landing or floor.
Where exterior landings or floors serving the required egress door are not at grade, they shall be provided with access to grade by means of a ramp in accordance with Section R311.8 or a stairway in accordance with Section R311.7.

- F18. Individual Shower and Tub-shower Combination Control Valves:**
(A) Per 408.3 CPC: Showers and tub-shower combinations shall be provided with individual control valves of the pressure balance, thermostatic, or combination pressure balance/thermostatic mixing valve type that provide acid and thermal shock protection for the rated flow rate of the installed showerhead. These valves shall be installed at the point of use and comply with ASSE 1016/ASME A112.1016/CSA B125.16 or ASME A112.18.1/CSA B125.1.
(B) Per CBC 2406.4.5: Glazing and Wet Surfaces: Safety glazing required at tub/shower enclosures & doors, windows with lower edge 60" or less from tub/shower floor, less than 24" of door swing, bottom edge less than 18" from floor or ground or exposed area larger than 9 sq. feet. Provide "x" "x" "x" Tub or shower pan w/tille to 72" from floor; shower head @76" and temp. glass enclosure.
(D) Shower Compartment: Min. finished interior area for showers shall be 1024 square inches and encompassing a minimum 30 inch circle.
- F19. Bedrooms:**
(A) Min. one window or door to meet egress requirements.
(B) Natural lighting & ventilation requirements shall be met.
(C) AFCI (Arc-Fault Circuit Interrupter) required for all receptacle outlets installed in bedrooms.
ALL (N) EXIT DOORS: EXIT DOORS SHALL BE OPENABLE FROM THE INSIDE WITHOUT THE USE OF A KEY OR SPECIAL KNOWLEDGE OR EFFORT.
- F21. AIR CONDITIONING:**
AIR CONDITIONING CONDENSING UNITS Refer to ENERGY CALCULATIONS.
- F22. Glazing Adjacent to Doors:**
Per sec. 2406.4.2 CBC, Glazing in an individual fixed or operable panel adjacent to a door where the nearest vertical edge of the glazing is within a 24-inch (610 mm) arc of either vertical edge of the door in a closed position and where the bottom exposed edge of the glazing is less than 60 inches (1524 mm) above the walking surface shall be considered to be a hazardous location. Exceptions:
1. Decorative glazing.
2. Where there is an intervening wall or other permanent barrier between the door and glazing.
3. Where access through the door is to a closet or storage area 3 feet (914 mm) or less in depth. Glazing in this application shall comply with Section 2406.4.3.
4. Glazing in walls on the latch side of and perpendicular to the plane of the door in a closed position in one- and two-family dwellings or within dwelling units in Group R-2
- F23. ADDITIONAL MECHANICAL NOTES:**
REF: ELECTRICAL/MECHANICAL SHEETS FOR MORE INFO.
(A) Combustion air openings at all furnace room locations shall comply to U.M.C. 702. One opening shall be located within the upper 12" of the enclosure and one opening shall be located within the lower 12" of the enclosure.
Combustion air to interior enclosed areas shall be supplied from outside, and walls shall be insulated, with solid core/weather-stripped access doors.
(B) Gas F.A.U. installed in attic space shall have:
1. Furnace model listed for attic.
2. Attic access of 30" square minimum.
3. An electrical outlet & light fixture w/switch at attic access.
(C) All mechanical equipment shall have a UL design approved
- F24. Lighting - General**
Per sec. 1204.1, Every space intended for human occupancy shall be provided with natural light by means of exterior glazed openings in accordance with Section 1204.2 or shall be provided with artificial light in accordance with Section 1204.3. Exterior glazed openings shall open directly onto a public way or onto a yard or court in accordance with Section 1205.
(HCD.1) Glazed openings may open into a passive solar energy collector provided the area of exterior glazed openings in the passive solar energy collector is increased to compensate for the area required by the interior space.
- F24.2 Lighting - Natural**
The minimum net glazed area shall be not less than 8 percent of the floor area of the room served.
F24.2.1 Adjoining spaces
Per sec. 1204.2.1 CBC, For the purpose of natural lighting, any room is permitted to be considered as a portion of an adjoining room where one-half of the area of the common wall is open and unobstructed and provides an opening of not less than one-tenth of the floor area of the interior room or 25 square feet (2.32 m2), whichever is greater.
Exception: Openings required for natural light shall be permitted to open into a sunroom with thermal isolation or a patio cover where the common wall provides a glazed area of not less than one-tenth of the floor area of the interior room or 20 square feet (1.86 m2), whichever is greater.
- F24.2.2 Exterior openings**
Per sec. 1204.2.2 CBC, Exterior openings required by Section 1204.2 for natural light shall open directly onto a public way, yard or court, as set forth in Section 1205.
Exceptions:
1. Required exterior openings are permitted to open into a roofed porch where the porch meets all of the following criteria:
1.1. Abuts a public way, yard or court.
1.2. Has a ceiling height of not less than 7 feet (2134 mm).
1.3. Has a longer side at least 65 percent open and unobstructed.
2. Skylights are not required to open directly onto a public way, yard or court.
- F25 Artificial Light**
Per sec. 1204.3 CBC, Artificial light shall be provided that is adequate to provide an average illumination of 10 footcandles (107 lux) over the area of the room at a height of 30 inches (762 mm) above the floor level.
- F26 Openings on Yards or Courts**
Per sec. 1202.5.3 CBC, Where natural ventilation is to be provided by openings onto yards or courts, such yards or courts shall comply with Section 1205.

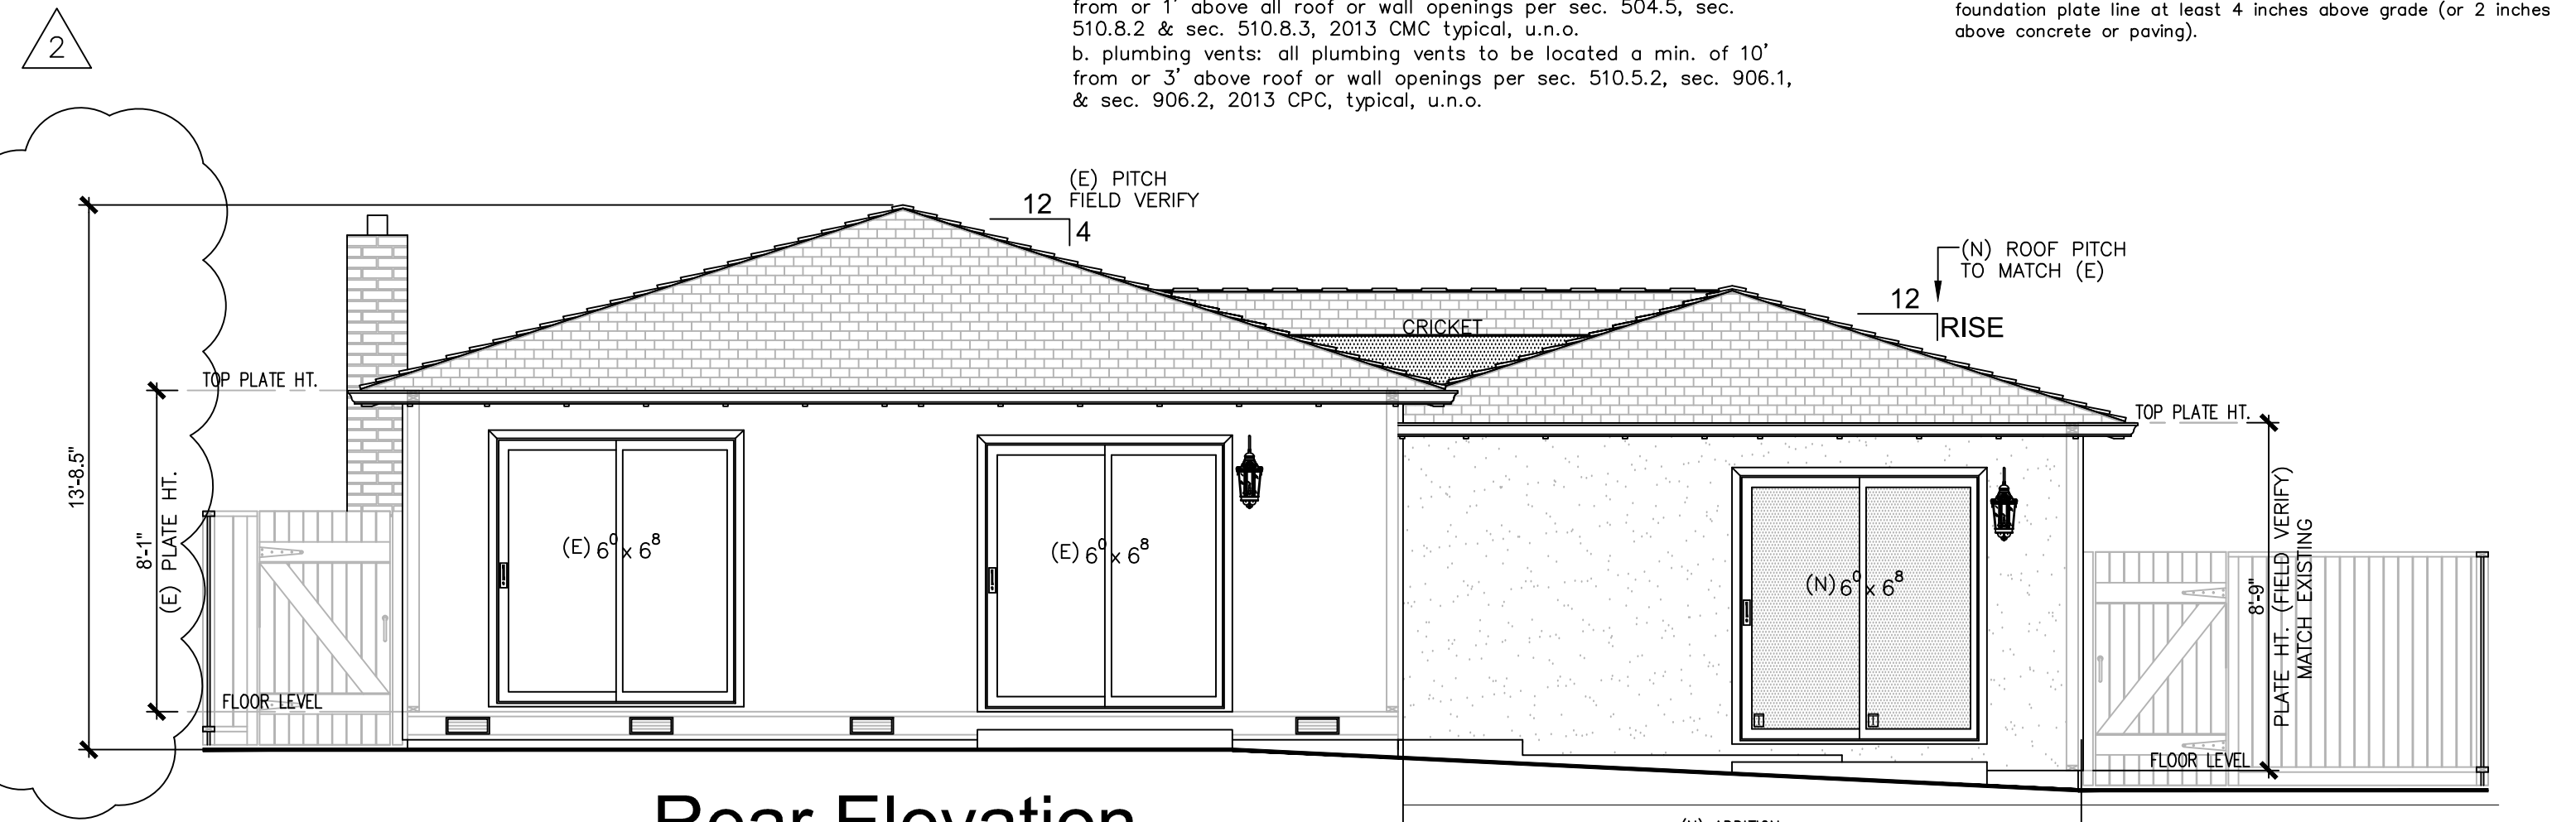

Rear Elevation
SCALE: 1/4"=1'-0"

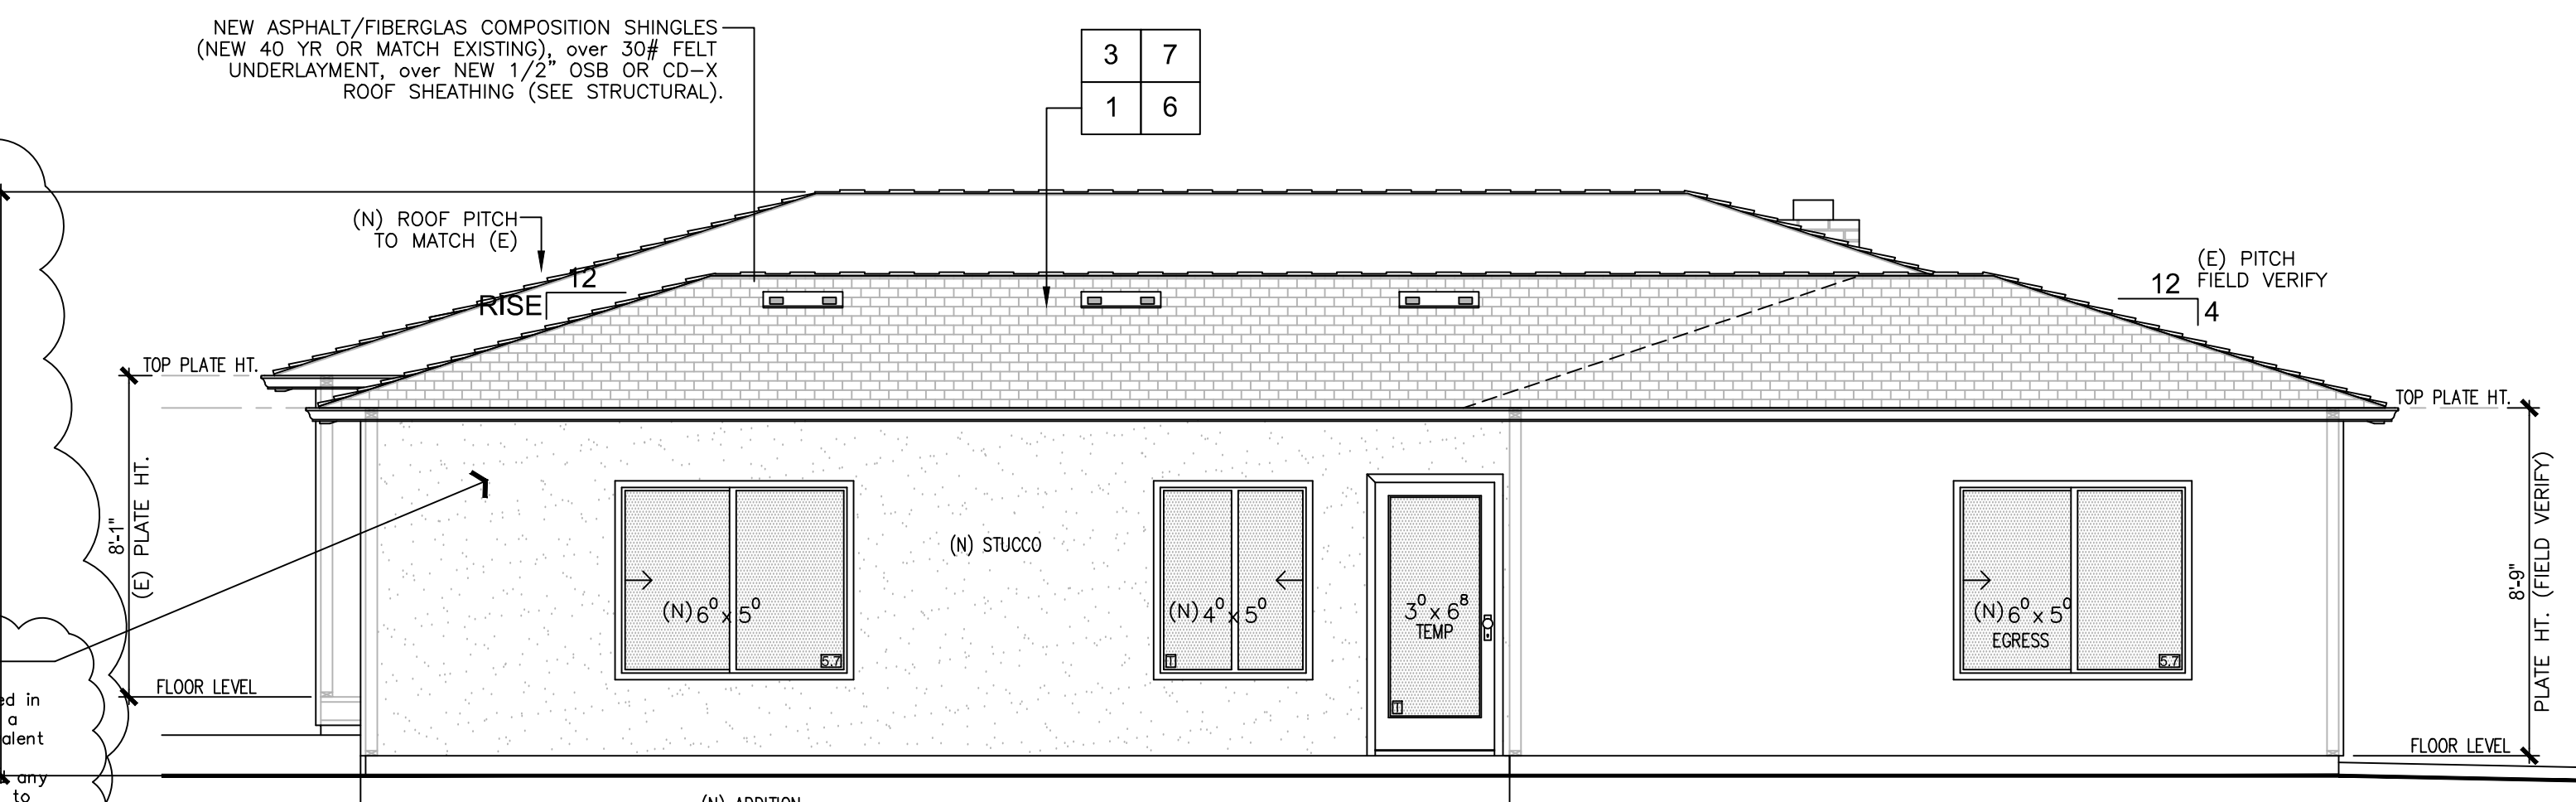

Left Side Elevation
SCALE: 1/4"=1'-0"

- 5** Windows: New windows to match existing style, use low e argon filled glass at all new windows. New windows shall be Eagle Window Co. aluminum clad wood frame casement with 7/8" Colonial simulated divided lites w/spacer bars (or equal per owner), and paint grade pre-primed pine finish at interior, and dual low e glass at all new casements. Provide aluminum frame "Vivid View" or equal.
- 6** Barge Rafter & Fascia Trim: (match existing) or new.
a. barge rafter assembly (match existing as/if occurs)- use continuous g.i. drip edge flashing, over 1x2 Clear Lam (or equal brand) pre-primed shingle strip, over 2x6 Clear Lam (or equal) pre-primed barge rafter, or equal approved system per owner.
b. 1x6 kiln dried fascia (match existing as/if occurs)- use continuous kiln-dried 1x6 Clear Lam (or equal) pre-primed fascia board or an approved equal per owner.
- 7** Attic/Roof Exhaust Vents: (to match existing or new)
a. O'Hagin rectangular attic vents (or equal); use O'Hagin Composition Shingle Vent for vaulted roof (or equal brand) (24" wide, 17" long, 2" high with 69.22 sq. in. vent area) roof mounted vents, where shown, and as required for attic/ceiling ventilation per Sec. R806.1 & R806.2 & R806.3 2013 CRC.
b. eave vents: @each structural block, provide 4-2" dia. eave block hole to achieve attic ventilation area equal to 1/150 of the attic square footage per Sec. R806.2 2013 CRC.
- 8** a. Floors and landings at exterior doors: R311.3 There shall be a landing on each side of each exterior door. The width of each landing shall not be less than the door served. Every landing shall have a minimum dimension of 36 inches measured in the direction of travel. Exterior landings shall be permitted to have a slope not to exceed 1/4 unit vertical in 12 units horizontal (2%). Exception: exterior balconies less than 60 sq. ft. and only accessible from a door are permitted to have a landing less than 36 inches measured in the direction of travel.
b. Floor elevations at the required egress doors: R311.3.1 Landings or floors at the required egress door shall not be more than 1-1/2" lower than the top of the threshold. Exception: the exterior landing or floor shall not be more than 7-3/4" below the top of the threshold provided the door does not swing over the landing or floor.
c. Floor elevations for other exterior doors: R311.3.2 Doors other than the required egress door shall be provided with landings or floors not more than 7-3/4" below the top of the threshold. Exception: a landing is not required where a stairway of two or fewer risers is located on the exterior side of the door, provided the door does not swing over the stairway.
- 9** Roof Jacks provide neoprene gaskets and g.i. roof jack/ rain cap. paint to match roof color & locate where not visible from street wherever possible, typical, u.n.o.
a. exhaust vents: all exhaust vents shall be located a min. of 3' from or 1' above all roof or wall openings per sec. 504.5, sec. 510.8.2 & sec. 510.8.3, 2013 CMC typical, u.n.o.
b. plumbing vents: all plumbing vents to be located a min. of 10' from or 3' above roof or wall openings per sec. 510.5.2, sec. 906.1, & sec. 906.2, 2013 CPC, typical, u.n.o.
- 1** New "Presidential TL" or Equal per owner 40 year Class A asphalt/fiberglass composition shingle roofing (max. weight not to exceed 3.0 psf- see structural roof plan), over 30# felt underlayment, over Ice & Watershield self-sealing waterproof roof membrane (by W.R. Grace) or equivalent, over Neop 1/2" ext. grade LP Techshield OSB Structural 1 fall faced sheathing or equivalent install w/foil face down, over New 2x DF-L rafters (see structural drawings).
- 2** (N) Gutters & Downspouts to match existing.
a. gutters: provide/install new 4-1/4" bonded metal "ogee" gutters (or equal) at addition, and/or areas affected by new work, typical U.O.N.
b. downspouts: provide/install new 2" dia. round bonded metal (or equal) downspouts at new addition, and at areas affected by new work. Maintain existing underground drain line system/splash blocks as/if occurs, typical U.O.N.
- 3** Flashing: 26 ga. g.i. flashing per Sec. R905.2.8, 2013 CRC for asphalt shingle roofing systems.
a. valley flashing: 26 ga. g.i. "W" flashing over cont. 36" wide (min.) extra layer of 30# felt @ all valleys, per sec. R905.2.8.2(2), 2013 CRC, typical, u.n.o.
b. rake flashing: 26 ga. g.i. "L" flashing per details at roof & under exterior wall siding, and per sec. R905.2.8.3, 2013 CRC, typical, u.n.o.
c. pitch break flashing: 26 ga. g.i. "L" flashing per details @ all wall to pitched roofs, and per sec. R905.2.8.3, 2013 CRC, typical, u.n.o.
d. cricket flashing: 26 ga. g.i. flashing over 1/2" cd plywood sheathing, over 2x4 d.f. framing @ 24" o.c. (as occurs), 1/4"/ft. min. slope to drain, typ., u.n.o.
e. window/door head flashing: g.i. "Z" flashing above windows & doors per details, typical, u.n.o.
- 4** (N) Wall w/Stucco Finish:
To match existing 7/8" thick min. 3-coat stucco with o/wire lath over water-resistive barrier. Water-resistive barriers shall be installed as required in Section R703.2 and where applied over wood-based sheathing, shall include a water-resistive, vapor-permeable barrier with a performance at least equivalent to two layers of grade D paper. The individual layers shall be installed independently such that each layer provides a separate continuous plan and any flashing, installed in accordance with Section R703.4 and intended to drain to the water-resistive barrier, is directed between the layers, over shear plywood sheathing per structural drawings per sec. R703.2 & sec. R703.6, 2019 CRC, o/ 2x4 D.F.#2 studs (or 2x studs where occurs) @ 16" o.c., w/ weep screed @ base per sec. R703.6.2.1, 2019 CRC, typical, u.n.o.
Stucco finish to have 26 gauge galvanized weep screed at foundation plate line at least 4 inches above grade (or 2 inches above concrete or paving).



Ingram Structural Engineering
Jeff Ingram, P.E. Yola Ingram
Civil Engineer Architectural Designer
License No. C 66222 Kitchen and Bath Specialist
E: Jeff@ingramSE.com E: Yola@ingramSE.com
C (408) 836-6602 C (408) 836-6604

2570 N. First Street
Suite 200
San Jose, CA 95131
www.IngramSE.com
DesignTeam@ingramSE.com, jeff@ingramse.com



VESA RESIDENCE


Property Owners	IVIDUJ VESA
Project Address	684 N Redwood Ave, San Jose, CA 95128
Phone	650-278-2869
Parcel	274-45-086
Site Area	7870 ft ²
Zoning	R-1-8 Single Family Residential City of San Jose
Setbacks	Front: 25'-0" Sides: 5'-0" Rear: 20'-0" Max Height: 35'-0"
Proposed Setbacks	Front: 25'-0" +/- (EXISTING) Right Side: 5'-0" +/- (EXISTING) Left Side: 10'-2" +/- Rear: 66'-2" +/- Blfg Height: 14'-6" +/-
Construction	Type V-B
Occupancy	R-3 & U
DATE ISSUE:	
7/6/2022	
1/9/2023	PER BUILDING DEPARTMENT PLAN CHECK
1/26/2023	PER PERMIT CENTER PLANNING PLAN CHECK

THESE STRUCTURAL DRAWINGS WERE PRODUCED BY ISE. THE USE OF THESE PLANS AND SPECIFICATIONS SHALL BE RESTRICTED TO THE ORIGINAL SITE FOR WHICH THEY WERE PREPARED, AND PUBLICATION THEREOF IS EXPRESSLY LIMITED TO SUCH USE. RE-USE, REPRODUCTION, OR PUBLICATION BY ANY METHOD, IN WHOLE OR IN PART, IS PROHIBITED. FURTHERMORE, TITLE TO THE PLANS AND SPECIFICATIONS REMAINS WITH ISE. VISUAL CONTACT WITH THESE PLANS AND SPECIFICATIONS CONSTITUTE PROOF OF ACCEPTANCE OF ALL RESTRICTIONS.
Copyright © 2022 ISE Ingram Structural Engineering

PROJECT #:	21.824	SCALE:	1/4"=1'-0"
DRAWN BY:	JJ		
PROJECT MANAGER:	JJ		
ENGINEERED BY:	JJ		
REVIEWED BY:	JJ		

Elevations

A4

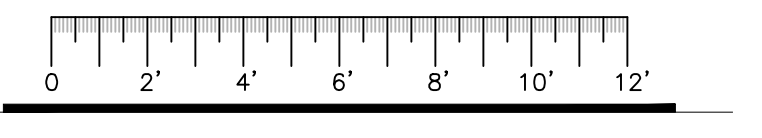

CONTRACTOR SHOULD NOTIFY THIS ENGINEER (Jeff Ingram) IN WRITING. OUR OFFICE WILL THEN RECOMMEND THE APPROPRIATE SOLUTIONS. THE WORK WILL BE ADDRESSED IN A TIMELY MANNER BASED ON THE HONOR SYSTEM GIVEN THE CURRENT WORK LOAD AT SUCH TIME AS THE CITY APPROVED PLANS MUST BE PROVIDED BY ISE WITH WRITTEN DOCUMENTATION SHOWN AND SIGNED BY ISE PRIOR TO FURTHER CONSTRUCTION AT SUCH AREA OR AREAS AFFECTED BY SUCH REVISION. FAILURE TO NOTIFY THIS ENGINEER WILL BE AT THE RISK OF THE OWNER AND THE CONTRACTOR. THE ASSISTANCE OF THEIR RESPONSIBILITIES, AS STATED HEREIN.

SECTION R806
ROOF VENTILATION
 R806.1 Ventilation required. Enclosed attics and enclosed rafter spaces formed where ceilings are applied directly to the underside of roof rafters shall have cross ventilation for each separate space by ventilating openings protected against the entrance of rain or snow. Ventilation openings shall have a least dimension of 1/16 inch (1.6 mm) minimum and 1/4 inch (6.4 mm) maximum. Ventilation openings having a least dimension larger than 1/4 inch (6.4 mm) shall be provided with corrosion-resistant wire cloth screening, hardware cloth or similar material with openings having a least dimension of 1/16 inch (1.6 mm) minimum and 1/4 inch (6.4 mm) maximum. Openings in roof framing members shall conform to the requirements of Section R802.7. Required ventilation openings shall open directly to the outside air.

R806.2 Minimum vent area. The minimum net free ventilating area shall be 1/150 of the area of the vented space. Exception: The minimum net free ventilating area shall be 1/300 of the vented space provided one or more of the following conditions are met:

- In Climate Zones 14 and 16, a Class I or II vapor retarder is installed on the warm-in-winter side of the ceiling.
- Not less than 40 percent and not more than 50 percent of the required ventilating area is provided by ventilators located in the upper portion of the attic or rafter space. Upper ventilators shall be located not more than 3 feet (914 mm) below the ridge or highest point of the space, measured vertically, with the balance of the required ventilation provided by eave or cornice vents. Where the location of wall or roof framing members conflicts with the installation of upper ventilators, installation more than 3 feet (914 mm) below the ridge or highest point of the space shall be permitted.

R806.3 Vent and insulation clearance. Where eave or cornice vents are installed, insulation shall not block the free flow of air. Not less than a 1-inch (25 mm) space shall be provided between the insulation and the roof sheathing and at the location of the vent.

SECTION R408
UNDER-FLOOR SPACE
 R408.1 Ventilation. The under-floor space between the bottom of the floor joists and the earth under any building (except space occupied by a basement) shall have ventilation openings through foundation walls or exterior walls. The minimum net area of ventilation openings shall be not less than 1 square foot (0.0929 m²) for each 150 square feet (14 m²) of under-floor space area, unless the ground surface is covered by a Class 1 vapor retarder material. Where a Class 1 vapor retarder material is used, the minimum net area of ventilation openings shall be not less than 1 square foot (0.0929 m²) for each 1,500 square feet (140 m²) of under-floor space area. One such ventilating opening shall be within 3 feet (914 mm) of each corner of the building.

R408.2 Openings for under-floor ventilation. The minimum net area of ventilation openings shall be not less than 1 square foot (0.0929 m²) for each 150 square feet (14 m²) of under-floor area. One ventilation opening shall be within 3 feet (915 mm) of each corner of the building. Ventilation openings shall be covered for their height and width with any of the following materials provided that the least dimension of the covering shall not exceed 1/4 inch (6.4 mm):

- Perforated sheet metal plates not less than 0.070 inch (1.8 mm) thick.
- Expanded sheet metal plates not less than 0.047 inch (1.2 mm) thick.
- Cast-iron grill or grating.
- Extruded load-bearing brick vents.
- Hardware cloth of 0.035 inch (0.89 mm) wire or heavier.
- Corrosion-resistant wire mesh, with the least dimension being 1/8 inch (3.2 mm) thick.

Exception: The total area of ventilation openings shall be permitted to be reduced to 1/1,500 of the under-floor area where the ground surface is covered with an approved class I vapor retarder material and the required openings are placed to provide cross ventilation of the space. The installation of operable louvers shall not be prohibited.

5 Attic/Roof Exhaust Vents: (to match existing OR new construction)
 a. O'Hagin rectangular attic vents (or equal): use O'Hagin Composition Shingle Vent for vaulted roof (or equal brand) (24" wide, 17" long, 2" high with 69.22 sq. in. vent area) roof mounted vents, where shown, and as required for attic/ceiling ventilation per Sec. R806.1 & R806.2 & R806.3, 2013 CRC.
 b. eave vents: @each structural block, provide 4-2" dia. eave block hole to achieve attic ventilation area equal to 1/150 of the attic square footage per Sec. R806.2 2013 CRC.

6 Roof Jacks provide neoprene gaskets and g.i. roof jack/ rain cap. paint to match roof color & locate where not visible from street wherever possible, typical, u.o.n.
 a. exhaust vents: all exhaust vents shall be located a min. of 3' from or 1' above all roof or wall openings per sec. 504.5, sec. 510.8.2 & sec. 510.8.3, 2013 OMC typical, u.o.n.
 b. plumbing vents: all plumbing vents to be located a min. of 10' from or 3' above roof or wall openings per sec. 510.5.2, sec. 906.1, & sec. 906.2, 2013 CPC, typical, u.o.n.

7 a. Floors and landings at exterior doors: R311.3 There shall be a landing on each side of each exterior door. The width of each landing shall not be less than the door served. Every landing shall have a minimum dimension of 36 inches measured in the direction of travel. Exterior landings shall be permitted to have a slope not to exceed 1/4 unit vertical in 12 units horizontal (2%). Exception: exterior balconies less than 60 sq. ft. and only accessible from a door are permitted to have a landing less than 36 inches measured in the direction of travel.
 b. Floor elevations at the required egress doors: R311.3.1 Landings or floors at the required egress door shall not be more than 1-1/2" lower than the top of the threshold. Exception: the exterior landing or floor shall not be more than 7-3/4" below the top of the threshold provided the door does not swing over the landing or floor.
 c. Floor elevations for other exterior doors: R311.3.2 Doors other than the required egress door shall be provided with landings or floors not more than 7-3/4" below the top of the threshold. Exception: a landing is not required where a stairway of two or fewer risers is located on the exterior side of the door, provided the door does not swing over the stairway.




8 (N) Gutters & Downspouts:
 a. gutters: provide/install new 4-1/4" bonderized metal "goose" gutters (or equal) at addition, and/or areas affected by new work, typical U.O.N.
 b. downspouts: provide/install new 2" dia. round bonderized metal (or equal) downspouts at new addition, and at areas affected by new work. Maintain existing underground drain line system/splash blocks as/if occurs, typical U.O.N.

1 New "Presidential TL" or Equal per owner 40 year Class A asphalt/fiberglass composition shingle roofing (max. weight not to exceed 4.0 psf- see structural roof plan), over 30# felt underlayment, over Ice & Watershield self-sealing waterproof roof membrane (by W.R. Grace) or equivalent, over New 1/2" ext. grade LP Techshield OSB Structural 1 foil faced sheathing or equivalent (install w/foil face down), over New 2x DF-L rafters (see structural drawings).

2 (N) New low slope roof system:
 Class A-1B Roof Systems "Tan" Single Ply Mechanically Attached Membrane Roofing System w/heat welded seams, or equivalent waterproof roofing system per Contractor, over 15/32" exterior grade OSB/C-D plywood sheathing o/rafters per structural plans.
 (UL-R15546 & ICC-ES Evaluation Report ESR-2852)

3 Flashing: 26 ga. g.i. flashing per Sec. R905.2.8, 2013 CRC for asphalt shingle systems.
 a. valley flashing: 26 ga. g.i. "W" flashing over cont. 36" wide (min.) extra layer of 30# felt @ all valleys, per sec. R905.2.8.2(2), 2013 CRC, typical, u.o.n.
 b. rake flashing: 26 ga. g.i. "L" flashing per details at roof & under exterior wall siding, and per sec. R905.2.8.3, 2013 CRC, typical, u.o.n.
 c. pitch break flashing: 26 ga. g.i. "L" flashing per details @ all wall to pitched roofs, and per sec. R905.2.8.3, 2013 CRC, typical, u.o.n.
 d. cricket flashing: 26 ga. g.i. flashing over 1/2" cdx plywood sheathing, over 2x4 d.f. framing @ 24" o.c. (as occurs), 1/4"/ft. min. slope to drain, typ., u.o.n.
 e. window/door head flashing: g.i. "Z" flashing above windows & doors per details, typical, u.o.n.

4 Exterior Siding & Trim:
 install gyp. bd. per sec. R702.3, 2013 CRC.
 Prepare wall surface for new exterior sheathing & siding materials, typ. U.O.N.
 a. stucco siding: 7/8" thick min. 3-coat stucco with finish, over 2 layers class "d" building paper, over Tyvek, over 1/2" OSB Structural 1 sheathing per Sect. R703.2 & R703.6 2013 CRC, over new 2x4 studs @16" o.c. with weep screed @base per Sec. R703.6.2.1 2013 CRC, typ. U.O.N.
 b. exterior wood trim: 1x/2x kiln-dried paint grade cedar trim (back primed) or equal @new windows & doors, typ. U.O.N.

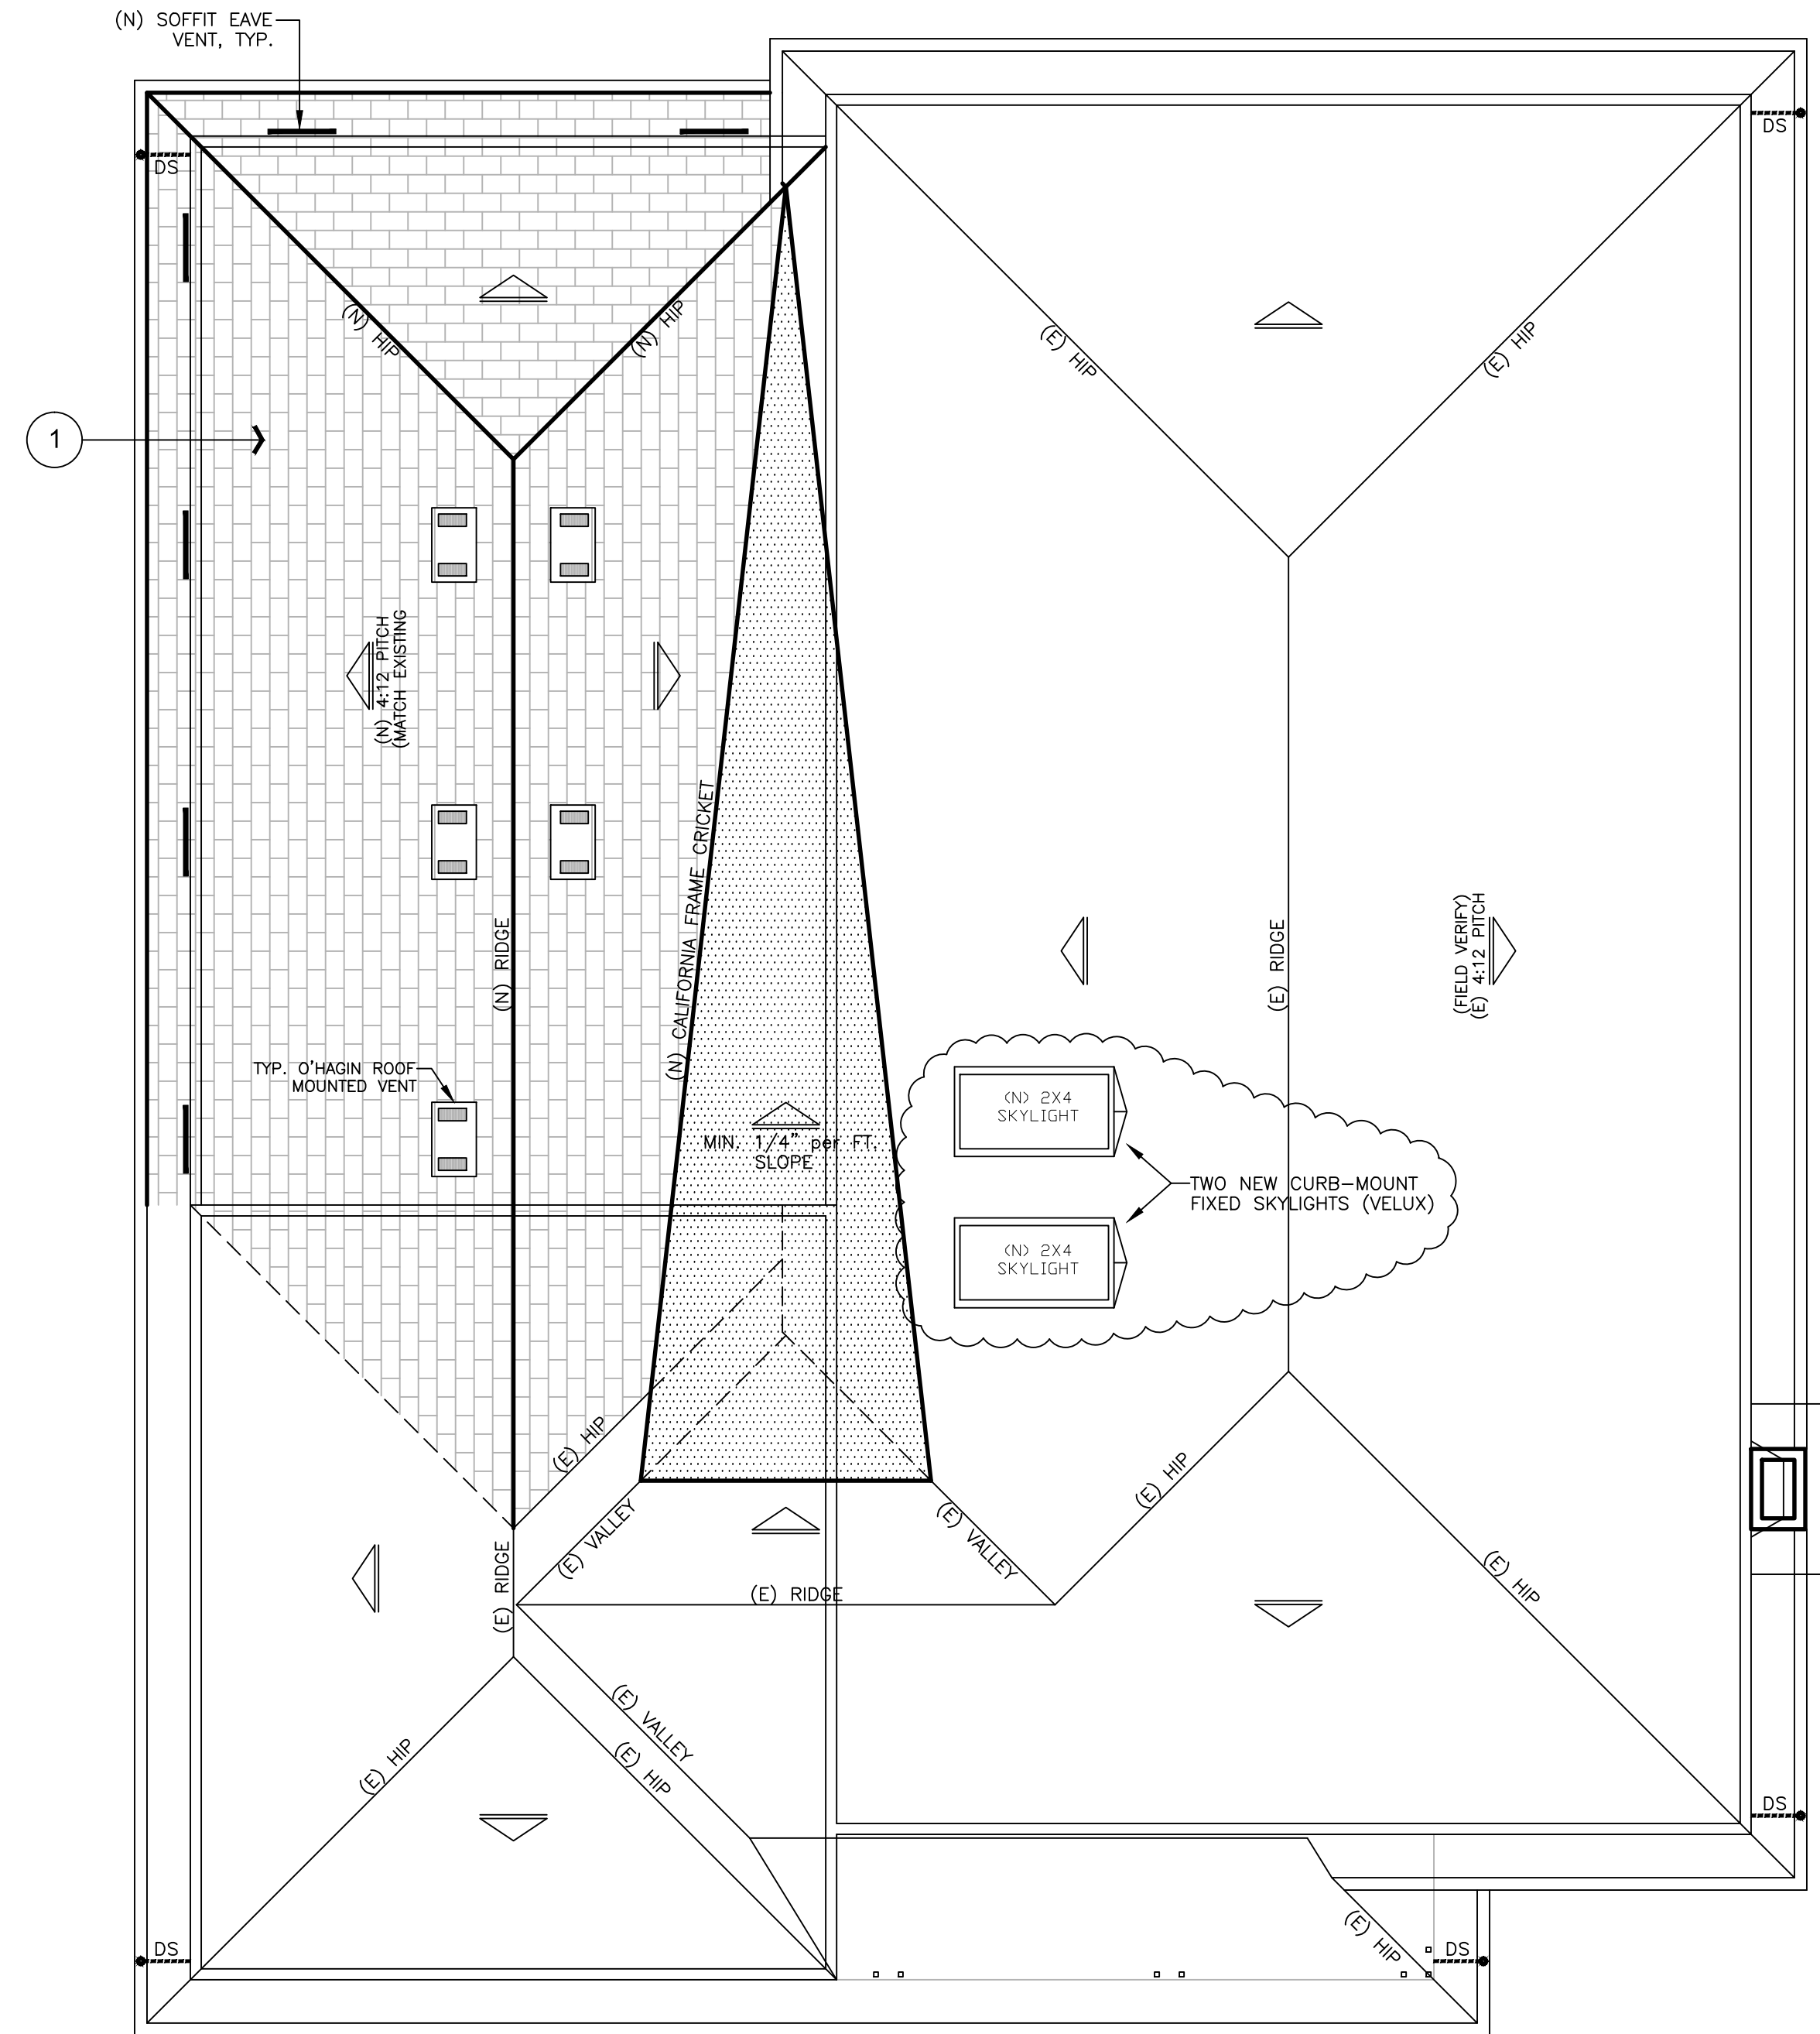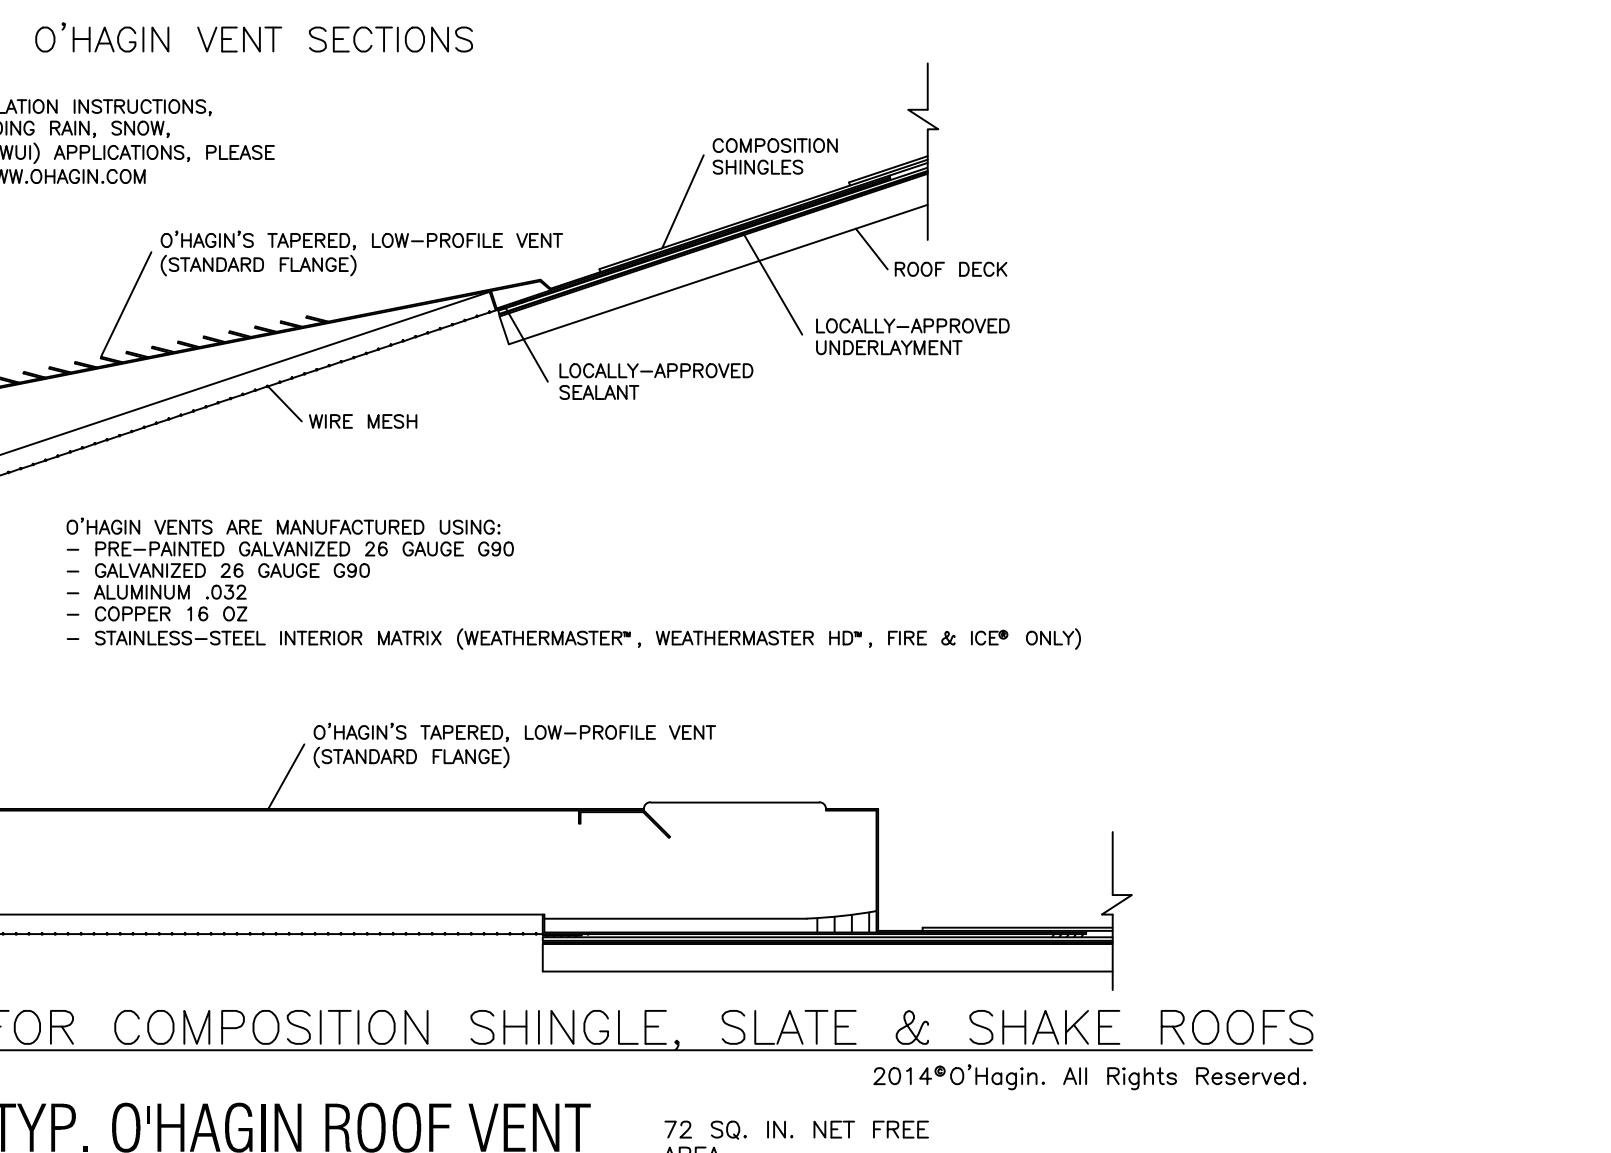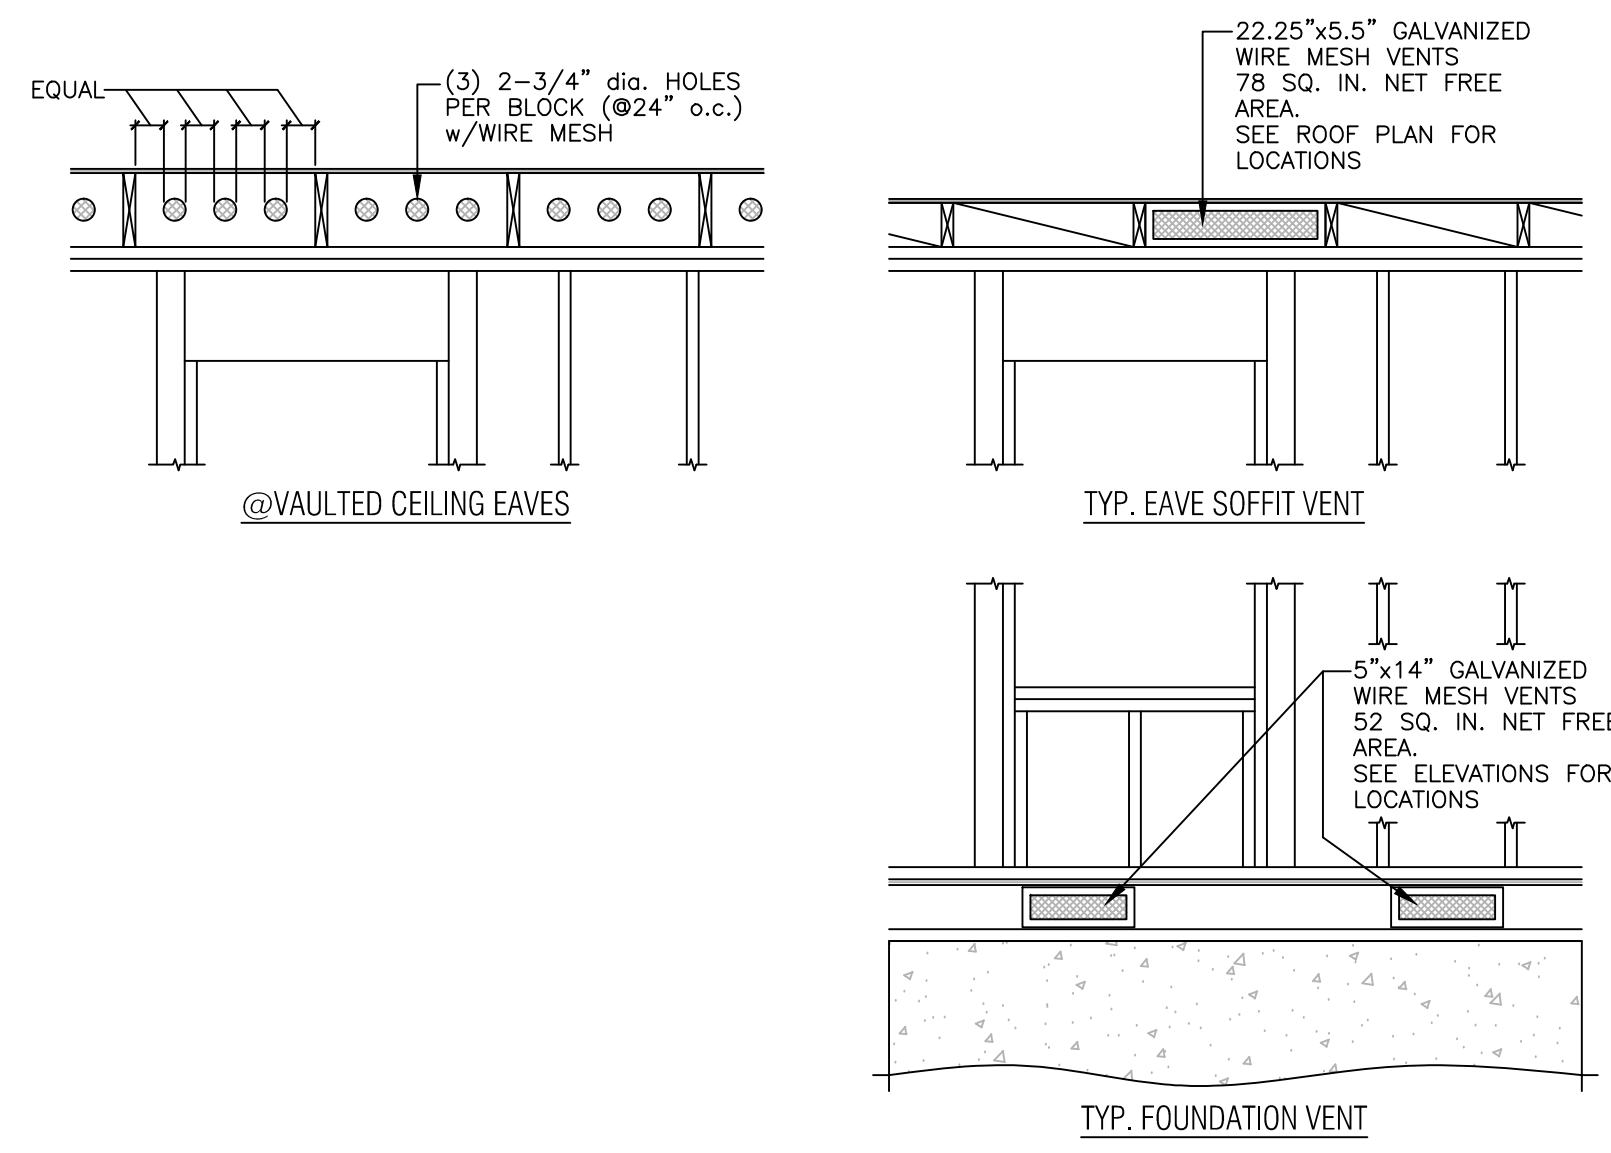

(N) Roof Plan

SCALE: 1/4"=1'-0"



Ingram Structural Engineering
Jeff Ingram, P.E. Civil Engineer
 License No. C 66222
 E: Jeff@ingramse.com
 C (408) 836-6602

Yola Ingram Architectural Designer
 Kitchen and Bath Specialist
 E: Yola@ingramse.com
 C (408) 836-6604

2570 N. First Street
 Suite 200
 San Jose, CA 95131
 www.ingramse.com
 DesignTeam@ingramse.com, jeff@ingramse.com



VESA RESIDENCE

Property Owners	OVIDIU VESA
Project Address	684 N Redwood Ave, San Jose, CA 95128
Phone	650-278-2869
Parcel	274-45-086
Site Area	7870 ft ²
Zoning	R-1-8 Single Family Residential City of San Jose
Setbacks	Front: 25'-0" Sides: 5'-0" Rear: 20'-0" Max Height: 35'-0"
Proposed Setbacks	Front: 25'-0" +/- (EXISTING) Right Side: 5'-0" +/- (EXISTING) Left Side: 10'-2" +/- Rear: 66'-2" +/- Blg Height: 14'-6" +/-
Construction	Type V-B
Occupancy	R-3 & U

DATE ISSUE:


7/6/2022	PER BUILDING DEPARTMENT PLAN CHECK
1/9/2023	PER PERMIT CENTER
1/26/2023	PLANNING PLAN CHECK

THESE STRUCTURAL DRAWINGS WERE PRODUCED BY ISE. THE USE OF THESE PLANS AND SPECIFICATIONS SHALL BE RESTRICTED TO THE ORIGINAL SITE FOR WHICH THEY WERE PREPARED, AND PUBLICATION THEREOF IS EXPRESSLY LIMITED TO SUCH USE. RE-USE, REPRODUCTION, OR PUBLICATION BY ANY METHOD, IN WHOLE OR IN PART, IS PROHIBITED. FURTHERMORE, TITLE TO THE PLANS AND SPECIFICATIONS REMAINS WITH ISE. VISUAL CONTACT WITH THESE PLANS AND SPECIFICATIONS CONSTITUTE PROOF OF ACCEPTANCE OF ALL RESTRICTIONS.
 Copyright © 2022 ISE Ingram Structural Engineering

PROJECT #:	21.824	SCALE:	1/4"=1'-0"
DRAWN BY:	JJ		
PROJECT MANAGER:	JJ		
ENGINEERED BY:	JJ		
REVIEWED BY:	JJ		

Roof Plan

A5

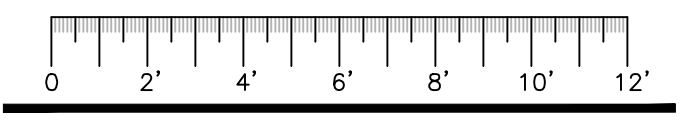

CERTIFICATE OF COMPLIANCE
Project Name: Vesa Residence
Calculation Date/Time: 2023-01-11 16:25:16
Input File Name: 0220397 Vesa Residence.rbd19x

Q1	Q2	Q3	Q4	Q5	Q6	Q7	Q8	Q9	Q10	Q11	Q12	Q13	Q14	Q15	Q16
01	02	03	04	05	06	07	08	09	10	11	12	13	14	15	16

ENERGY USE SUMMARY

Energy Use (BTU/ft²-yr)	Standard Design	Proposed Design	Compliance Margin	Percent Improvement
Space Heating	43.39	46.61	2.78	6.4
Space Cooling	44.35	44	0.35	0.8
HVAC Ventilation	0	0	0	0
Water Heating	15.44	15.44	0	0
Solar Utilization/Passivity Credit	n/a	0	0	n/a
Compliance Energy Total	107.18	104.05	3.13	2.9

CERTIFICATE OF COMPLIANCE
Project Name: Vesa Residence
Calculation Date/Time: 2023-01-11 16:25:16
Input File Name: 0220397 Vesa Residence.rbd19x

REQUIRED SPECIAL FEATURES

HERS FEATURE SUMMARY

HERS PROVIDER: CalCERTS, Inc.

CERTIFICATE OF COMPLIANCE
Project Name: Vesa Residence
Calculation Date/Time: 2023-01-11 16:25:16
Input File Name: 0220397 Vesa Residence.rbd19x

OPAQUE SURFACES

Q1	Q2	Q3	Q4	Q5	Q6	Q7	Q8	Q9	Q10	Q11
01	02	03	04	05	06	07	08	09	10	11

CERTIFICATE OF COMPLIANCE
Project Name: Vesa Residence
Calculation Date/Time: 2023-01-11 16:25:16
Input File Name: 0220397 Vesa Residence.rbd19x

OPAQUE SURFACES - CATHEDRAL CEILING

ATTIC

PENETRATION / GLAZING

CERTIFICATE OF COMPLIANCE
Project Name: Vesa Residence
Calculation Date/Time: 2023-01-11 16:25:16
Input File Name: 0220397 Vesa Residence.rbd19x

PENETRATION / GLAZING

Q1	Q2	Q3	Q4	Q5	Q6	Q7	Q8	Q9	Q10	Q11	Q12	Q13	Q14	Q15	Q16
01	02	03	04	05	06	07	08	09	10	11	12	13	14	15	16

CERTIFICATE OF COMPLIANCE
Project Name: Vesa Residence
Calculation Date/Time: 2023-01-11 16:25:16
Input File Name: 0220397 Vesa Residence.rbd19x

SLAB FLOORS

Q1	Q2	Q3	Q4	Q5	Q6	Q7	Q8	Q9	Q10
01	02	03	04	05	06	07	08	09	10

CERTIFICATE OF COMPLIANCE
Project Name: Vesa Residence
Calculation Date/Time: 2023-01-11 16:25:16
Input File Name: 0220397 Vesa Residence.rbd19x

OPAQUE SURFACE CONSTRUCTIONS

Q1	Q2	Q3	Q4	Q5	Q6	Q7	Q8
01	02	03	04	05	06	07	08

CERTIFICATE OF COMPLIANCE
Project Name: Vesa Residence
Calculation Date/Time: 2023-01-11 16:25:16
Input File Name: 0220397 Vesa Residence.rbd19x

WATER HEATING SYSTEMS

Q1	Q2	Q3	Q4	Q5	Q6	Q7	Q8	Q9	Q10	Q11	Q12	Q13	Q14
01	02	03	04	05	06	07	08	09	10	11	12	13	14

CERTIFICATE OF COMPLIANCE
Project Name: Vesa Residence
Calculation Date/Time: 2023-01-11 16:25:16
Input File Name: 0220397 Vesa Residence.rbd19x

SPACE CONDITIONING SYSTEMS

Q1	Q2	Q3	Q4	Q5	Q6	Q7	Q8	Q9	Q10	Q11
01	02	03	04	05	06	07	08	09	10	11

CERTIFICATE OF COMPLIANCE
Project Name: Vesa Residence
Calculation Date/Time: 2023-01-11 16:25:16
Input File Name: 0220397 Vesa Residence.rbd19x

HVAC HEAT PUMPS - HERS VERIFICATION

Q1	Q2	Q3	Q4	Q5	Q6	Q7	Q8	Q9
01	02	03	04	05	06	07	08	09

CERTIFICATE OF COMPLIANCE
Project Name: Vesa Residence
Calculation Date/Time: 2023-01-11 16:25:16
Input File Name: 0220397 Vesa Residence.rbd19x

HVAC FAN SYSTEMS - HERS VERIFICATION

Q1	Q2	Q3
01	02	03

CERTIFICATE OF COMPLIANCE
Project Name: Vesa Residence
Calculation Date/Time: 2023-01-11 16:25:16
Input File Name: 0220397 Vesa Residence.rbd19x

DOCUMENTATION AUTHORITY'S DECLARATION STATEMENT

RESPONSIBLE PERSON'S DECLARATION STATEMENT

CalCERTS, Inc. HERS PROVIDER

FRI Energy Consultants, LLC
21 N. Harrison Avenue, Suite 210
Campbell, CA 95008
Phone: 408-866-1620 Fax: 408-866-6832
VESA RESIDENCE
684 N. REDWOOD AVE
SAN JOSE, CA 95128
T24-1

2019 Low-Rise Residential Mandatory Measures Summary

NOTE: Low-rise residential buildings subject to the Energy Standards must comply with all applicable mandatory measures, regardless of the compliance approach used. Review the respective section for more information. *Exceptions may apply.

Section	Measure
§ 110.0(a)1	Air Leakage. Manufactured fenestration, exterior doors, and exterior pit doors must limit air leakage to 0.3 CFM per square foot or less when tested per NFRC-400, ASTM E233 or AIAA/WMA/MSA 1011.S.2/440-2011.*
§ 110.0(a)5	Labeling. Fenestration products and exterior doors must have a label meeting the requirements of § 110.11(a).
§ 110.0(b)1	Field-fabricated exterior doors and fenestration products must use U-factors and solar heat gain coefficient (SHGC) values from Tables 110.0.A, 110.0.B, or 110.0.C for exterior doors. They must be caulked and/or weather-stripped.
§ 110.7	Air Leakage. All joints, penetrations, and other openings in the building envelope that are potential sources of air leakage must be caulked, caulked, or weather-stripped.
§ 110.0(a)1	Insulation Certification by Manufacturers. Insulation must be certified by the Department of Consumer Affairs, Bureau of Household Goods and Services (BHGS).
§ 110.0(a)2	Insulation Requirements for Heated Slab Floors. Heated slab floors must be insulated per the requirements of § 110.0(a).
§ 110.0(a)3	Roofing Products Solar Reflectance and Thermal Emittance. The thermal emittance and aged solar reflectance values of the roofing material must meet the requirements of § 110.0(a) and be labeled per §10.113 when the installation of a cool roof is specified on the CFIR.
§ 110.0(a)4	Radiant Barrier. When required, radiant barriers must have an emittance of 0.05 or less and be certified to the Department of Consumer Affairs.
§ 150.0(a)1	Ceiling and Rafter Roof Insulation. Minimum R-12 insulation in wood frame ceiling, or the weighted average U-factor must not exceed 0.043. Minimum R-19 or weighted average U-factor of 0.054 or less in a rafter roof alteration. Rite access doors must have permanently attached insulation using adhesive or mechanical fasteners. The attic access must be gasketed to prevent air leakage. Insulation must be installed in direct contact with a continuous roof or ceiling which is sheathed to limit infiltration and exfiltration as specified in § 110.7, including but not limited to electric insulation either above or below the roof deck or onto a structural ceiling.
§ 150.0(a)2	Loose-fill Insulation. Loose-fill insulation must meet the manufacturer's required density for the labeled R-value.
§ 150.0(a)3	Wall Insulation. Minimum R-13 insulation in 2.4-inch wood framing wall or have a U-factor of 0.102 or less, or R-20 in 2.6-inch wood framing or have a U-factor of 0.071 or less. Opaque non-framed assemblies must have an overall assembly U-factor not exceeding 0.102. Masonry walls must meet Tables 150.1.A or B.*
§ 150.0(a)4	Raised-floor Insulation. Minimum R-19 insulation in raised wood framed floor or 0.037 maximum U-factor.*
§ 150.0(a)5	Slab Edge Insulation. Slab edge insulation must meet all of the following: have a water absorption rate, for the insulation material alone without facings, no greater than 0.3 percent; have a water vapor permeance no greater than 20 perm per inch; be protected from physical damage and UV light deterioration; and, when installed as part of a heated slab floor, meet the requirements of § 110.0(a).
§ 150.0(a)6	Vapor Retarder. In climate zones 1 through 16, the earth floor or unvented crawl space must be covered with a Class I or Class II vapor retarder. This requirement also applies to controlled ventilation crawl spaces for buildings complying with the exception to § 150.0(a).
§ 150.0(a)7	Vapor Retarder. In climate zones 14 and 15, a Class I or Class II vapor retarder must be installed on the conditioned space side of all insulation in all exterior walls, vented attics, and unvented attics with air-permeable insulation.
§ 150.0(a)8	Fenestration Products. Fenestration, including skylights, separating conditioned space from unconditioned space or outdoors must have a maximum U-factor of 0.75, or the weighted average U-factor of all fenestration must not exceed 0.59.*
§ 150.0(a)9	Fireplaces, Decorative Gas Appliances, and Gas Log Measures:
§ 110.5(e)	Pilot Light. Continuously burning pilot lights are not allowed for indoor and outdoor fireplaces.
§ 150.0(e)1	Closable Doors. Masonry or factory-built fireplaces must have a closable metal or glass door covering the entire opening of the firebox.
§ 150.0(e)2	Combustion Intake. Masonry or factory-built fireplaces must have a combustion intake, which is at least six square inches in area and is equipped with a readily accessible, operable, and light-tight damper or combustion-air control device.*
§ 150.0(e)3	Flue Damper. Masonry or factory-built fireplaces must have a flue damper with a readily accessible control.*
§ 110.0(d)1	Space Conditioning, Water Heating, and Plumbing System Measures:
§ 110.0(d)1.1	Certification. Heating, ventilation and air conditioning (HVAC), equipment, water heaters, showerheads, faucets, and all other regulated appliances must be certified by the manufacturer to the California Energy Commission.
§ 110.0(d)2	HVAC Efficiency. Equipment must meet the applicable efficiency requirements in Table 110.2.A through Table 110.2.K.*
§ 110.0(d)3	Controls for Heat Pumps with Supplementary Electric Resistance Heaters. Heat pumps with supplementary electric resistance heaters must have controls that prevent supplementary heater operation when the heating load can be met by the heat pump alone, and in which the on-temperature for compression heating is higher than the on-temperature for supplementary heating, and the off-temperature for compression heating is higher than the off-temperature for supplementary heating.*
§ 110.0(d)4	Thermostats. All heating or cooling systems not controlled by a central energy management control system (EMCS) must have a setback thermostat.*
§ 110.0(d)5	Water Heating Recirculation Loops Serving Multiple Dwelling Units. Water heating recirculation loops serving multiple dwelling units must meet the air release valve, backflow prevention, pump, pump isolation valve, and recirculation loop connection requirements of § 110.3(a).
§ 110.0(d)6	Isolation Valves. Instantaneous water heaters with an input rating greater than 6.9 Btu per hour (2 kW) must have isolation valves with hose bibbs or other fittings on both cold and hot water to allow for flushing the water heater when the valves are closed.
§ 110.5	Pilot Lights. Continuously burning pilot lights are prohibited for natural gas: fan-type central furnaces; household cooking appliances (except appliances without an electrical supply voltage connection with pilot lights that consume less than 150 Btu per hour); and pool and spa heaters.*
§ 150.0(d)1	Building Cooling and Heating Loads. Heating and/or cooling loads are calculated in accordance with the ASHRAE Handbook, Equipment Volume, Applications Volume, and Fundamentals Volume, and Supplemental Residential Comfort System Installation Standards Manual, or the ACCA Manual J, using design conditions specified in § 150.0(d).

2019 Low-Rise Residential Mandatory Measures Summary

§ 150.0(d)3A	Clearances. Air conditioner and heat pump outdoor condensing units must have a clearance of at least five feet from the outlet of any dryer.
§ 150.0(d)3B	Liquid Line Driv. Air conditioners and heat pump systems must be equipped with liquid line filter driers if required, as specified by the manufacturer's instructions.
§ 150.0(d)4	Storage Tank Insulation. Unfired hot water tanks, such as storage tanks and backup storage tanks for solar water-heating systems, must have a minimum of R-12 external insulation or R-16 internal insulation where the internal insulation R-value is indicated on the exterior of the tank.
§ 150.0(d)5A	Water Piping, Solar Water-heating System Piping, and Space Conditioning System Line Insulation. All domestic hot water piping must be insulated as specified in Section 110.11 of the California Plumbing Code. In addition, the following piping conditions must have a minimum insulation wall thickness of one inch or a minimum insulation R-value of 7.7: the first five feet of cold water piping from the storage tank; all hot water piping with a nominal diameter equal to or greater than 3/4 inch and less than one inch; all hot water piping with a nominal diameter less than 3/4 inch that is associated with a domestic hot water recirculation system, from the heating source to storage tank or between tanks; buried below grade; and from the heating source to kitchen fixtures.*
§ 150.0(d)6	Insulation Protection. Piping insulation must be protected from damage, including that due to sunlight, moisture, equipment maintenance, and wind as required by Section 120.3(b). Insulation exposed to weather must be water resistant and protected from UV light (no adhesive tapes). Insulation covering chilled water piping and refrigerant suction piping located outside the conditioned space must include, or be protected by, a Class I or Class II vapor retarder. Pipe insulation buried below grade must be installed in a waterproof and non-combustible casing or sleeve.
§ 150.0(d)7	Gas or Propane Water Heating Systems. Systems using gas or propane water heaters to serve individual dwelling units must include all of the following: A dedicated 1.25 volt, 20 amp electrical receptacle connected to the electric panel with a 120/240 volt 3 conductor, 10 AWG copper branch circuit, within three feet of the water heater without obstruction. Both ends of the ungrounded conductor must be labeled with the word "open" and be electrically isolated. Have a reserved single pole circuit breaker space in the electrical panel adjacent to the circuit breaker for the branch circuit and labeled with the words "Future 240V Line," a Category III or IV arc, or a Type E vent with straight pipe between the outside termination and the space where the water heater is installed, a condensate drain that is no more than two inches higher than the base of the water heater, and flow restrictor with pump assistance, and a gas supply line with a capacity of at least 200,000 Btu per hour.
§ 150.0(d)8	Recirculating Loops. Recirculating loops serving multiple dwelling units must meet the requirements of § 110.3(a)5.
§ 150.0(d)9	Solar Water-heating Systems. Solar water-heating systems and collectors must be certified and rated by the Solar Rating and Certification Corporation (SRCC), the International Association of Plumbing and Mechanical Officials, Research and Testing (IAPMO RTR), or by a listing agency that is approved by the Executive Director.
§ 110.0(d)10	Ducts and Fans Measures:
§ 110.0(d)10.1	Ducts. Insulation installed on an existing space-conditioning unit must comply with § 604.0 of the California Mechanical Code (CMC). If a contractor installs the insulation, the contractor must certify to the customer, in writing, that the insulation meets this requirement.
§ 110.0(d)10.2	CMC Compliance. All air distribution systems ducts and plenums must meet the requirements of the CMC §§ 607.0, 607.0.1, 607.0.2, 607.0.3, 607.0.781, 607.0

CONTRACTOR SHOULD NOTIFY THIS ENGINEER (Jeff Ingram) IN WRITING. OUR OFFICE WILL THEN RECOMMEND THE APPROPRIATE FRAMING BASED ON THE CURRENT WORK LOAD AT SUCH TIME APPROVED FROM THE CITY APPROVED. PLANS MUST BE APPROVED BY USE WITH WRITEN DOCUMENTATION SHOWN AND SIGNED BY THE ENGINEER. FAILURE TO NOTIFY THIS ENGINEER WILL BE AT THE CONTRACTOR'S RISK. THE CONTRACTOR SHALL BE RESPONSIBLE FOR THE ASSURANCE OF THEIR RESPONSIBILITIES. AS STATED BY USE WITH WRITEN DOCUMENTATION SHOWN AND SIGNED BY THE ENGINEER.

ADDITIONAL ELECTRICAL/MECHANICAL NOTES:

- PER CBC 210-8, ALL RECEPTACLES IN BATHROOMS, LAUNDRY ROOMS, KITCHENS, AND GARAGES ARE REQUIRED TO BE GFCI PROTECTED EXCEPT WHEN ON A DEDICATED APPLIANCE CIRCUIT.
- PER CBC 212, ALL BEDROOM RECEPTACLES ARE REQUIRED TO BE AFCI PROTECTED.
- PER CBC 210-8, EXTERIOR RECEPTACLES, IN ADDITION TO BEING WATERPROOF, ARE REQUIRED TO BE GFCI PROTECTED.
- EXHAUST FANS REQUIRED IN BATHROOMS AND LAUNDRY ROOM PER CBC 1203.3.
- PER CBC 310.9, SMOKE DETECTORS ARE REQUIRED TO BE INSTALLED AT THE HIGH POINTS OF A CEILING OR ON A WALL WITHIN 12" OF A HIGH POINT OF A CEILING IN BEDROOMS.
- ARC-FAULT CIRCUIT INTERRUPTERS ARE REQUIRED IN ALL BEDROOMS PER CBC 210-12.
- CLOTHES DRYERS AND ELECTRIC RANGES SHALL HAVE A 4-WIRE GROUNDED ELECTRICAL OUTLET PER NEC 250-59.
- IN ADDITION TO OTHER BRANCH CIRCUIT REQUIREMENTS, AT LEAST ONE 20-amp BRANCH CIRCUIT SHALL BE PROVIDED TO SUPPLY BATHROOM RECEPTACLE OUTLETS. SUCH CIRCUITS SHALL HAVE NO OTHER OUTLETS. NEC 210-11
- IN ADDITION TO OTHER BRANCH CIRCUIT REQUIREMENTS, AT LEAST ONE 20-amp BRANCH CIRCUIT SHALL BE PROVIDED TO SUPPLY LAUNDRY RECEPTACLE OUTLETS REQUIRED PER CBC 210-52(f) AND 210-11(c).

NOTE:
ALL BRANCH CIRCUITS THAT SUPPLY 125 VOLT SINGLE PHASE, 15 and 20 AMPERE RECEPTACLE OUTLETS INSTALLED IN DWELLING UNIT BEDROOMS SHALL BE PROTECTED BY AN ARC-FAULT CIRCUIT INTERRUPTERS per NEC 210-12.

- General lighting at kitchen must meet the requirements of the CA Energy Code.
- Have an efficacy of at least 40 lumens/watt (see table 2-7 of CA residential energy manual)
 - Provide a uniform pattern of lighting for kitchen.
 - Provide a light level sufficient for performing basic kitchen tasks.
 - Be controlled on a readily accessible switch(s) at entrance(s) to the kitchen.
 - Be switched independent of incandescent lighting.
 - Shall not contain medium-base incandescent lamp sockets.

Outlets

- Receptacle outlets shall be installed in kitchens: (NEC 210-52)
- On wall counters spaces 12 inches or wider. Counter space at either side of a sink or range shall be considered as a separate counter.
 - Not more than 4 feet on centers.
 - Not more than 2 feet from the counter end.
 - Provide a min. of one receptacle on island/peninsular countertop 12" or wider.
 - Counter space at either side of a sink or range shall be considered as a separate counter.

- Gas Furnace installed in an attic shall have:
- Furnace model listed for attic location.
 - Attic access 30" x 30" minimum (exception 22" x 30"). Access must be within 20' of furnace with 24" wide (min.), unobstructed, solid walkway to furnace. Furnace requires a working platform per CMC 908.0.
 - One electric outlet and lighting fixture controlled by a switch located at the required passageway opening. (CMC 306).

MECHANICAL NOTES

- ITEMS TO BE VERIFIED WITH OWNER:
- MECHANICAL CONTRACTOR TO INSTALL A COMPLETE AND OPERATING COMPLY WITH ALL APPLICABLE SECTIONS OF THE UMC AND UBC.
 - PLUMBING CONTRACTOR IS TO MEET W/ THE OWNER PRIOR TO THE SELECTION AND INSTALLATION OF ALL INDIVIDUAL CONTROL VALVES.
- PROVIDE TYPE "L" COPPER TUBING FOR ALL WATER PIPING. TYPE "M" COPPER TUBING SHALL NOT BE USED FOR WATER PIPING
 - PLUMBING DRAIN WASTE AND VENT AND/OR MECHANICAL DUCTING ALONG WITH ELECTRICAL PANEL/WIRING SIZING CALCULATIONS MAY BE REQUIRED TO BE PROVIDED IF THE FIELD INSPECTOR REQUESTS THESE ITEMS.
 - ALL 1ST FLOOR HEAT REGISTERS ARE TO BE FLOOR MOUNT AND ALL 2ND FLOOR HEAT REGISTERS BEING CEILING MOUNT ONLY.
 - WATER HEATERS TO BE C.E.C. CERTIFIED AND HAVE A PRESSURE & TEMPERATURE RELIEF DEVICES PER UPC 505.1.
 - FURNACES TO BE C.E.C. CERTIFIED AND COMPLY WITH UMC 302.1
 - PROVIDE CLEARANCES AROUND WATER HEATER AND FURNACE PER UMC 304.6 & TABLE 3-B AND UPC 508 & 511.
 - EQUIPMENT WHICH HAS A FLAME, GENERATES A SPARK, OR USES A GLOWING SOURCE SHALL COMPLY WITH UMC 303.3 AND UPC 510.1
 - FURNACE TO BE ANCHORED OR STRAPPED TO RESIST EARTHQUAKES PER UMC 308.
 - WATER HEATER TO BE ANCHORED OR STRAPPED TO RESIST EARTHQUAKES PER UPC 510.5.
 - IN SHOWERS & TUB/SOWER COMBINATIONS, INDIVIDUAL CONTROL VALVES MUST BE PRESSURE BALANCED OR THERMOSTATIC MIXING VALVES PER UPC 420.
 - SHOWERHEADS, LAVATORY AND SINK FAUCETS SHALL HAVE A MAXIMUM FLOW RATE OF 2.5 GPM PER CALIFORNIA ENERGY COMMISSION
 - WATER CLOSETS AND ASSOCIATED FLUSHMETER VALVES, IF ANY, SHALL USE NO MORE A.N.S.I.S. A112.19.2 HAS CODE SECTION 1792(B).
 - PROVIDE COMBUSTION AIR FOR FUEL-BURNING EQUIPMENT PER UMC 507 AND TABLE 7-A.
 - ALL VENT TERMINATIONS MUST BE 10' AWAY OR 3' ABOVE ANY OPENINGS PER UMC 504.6.
 - ALL AIR DUCTS PENETRATION SEPERATION WALL OR CEILING BETWEEN GARAGE AND LIVING AREA SHALL BE A MINIMUM OF 26 GAUGE PER UBC 302.4 EXCEPTION #3.
 - PROVIDE CONFORMING DRYER EXHAUST TO OUTSIDE. TOTAL LENGTH SHALL NOT EXCEED 14 FEET INCLUDING TWO 90°-ELBOWS. CMC 504.3.2 AND 908.
 - ALL HOSE BIBBS SHALL HAVE NON-REMOVABLE TYPE BACK-FLOW PREVENTION DEVICE. PER UPC 603.4.7
 - NO UNDERFLOOR CLEANOUT SHALL BE LOCATED MORE THAN 20 FEET FROM AN ACCESS DOOR, TRAP DOOR, OR CRAWL HOLE PER UPC 707.
 - IF HOUSE IS TO HAVE PROPANE (LPG) GAS, IT MUST MEET THE REQUIREMENTS OF UPC 1213.

MECHANICAL NOTES


- ITEMS TO BE VERIFIED WITH OWNER:
- MECHANICAL CONTRACTOR TO INSTALL A COMPLETE AND OPERATING COMPLY WITH ALL APPLICABLE SECTIONS OF THE UMC AND UBC.
 - PLUMBING CONTRACTOR IS TO MEET W/ THE OWNER PRIOR TO THE SELECTION AND INSTALLATION OF ALL INDIVIDUAL CONTROL VALVES.
- PROVIDE TYPE "L" COPPER TUBING FOR ALL WATER PIPING. TYPE "M" COPPER TUBING SHALL NOT BE USED FOR WATER PIPING
 - PLUMBING DRAIN WASTE AND VENT AND/OR MECHANICAL DUCTING ALONG WITH ELECTRICAL PANEL/WIRING SIZING CALCULATIONS MAY BE REQUIRED TO BE PROVIDED IF THE FIELD INSPECTOR REQUESTS THESE ITEMS.
 - ALL 1ST FLOOR HEAT REGISTERS ARE TO BE FLOOR MOUNT AND ALL 2ND FLOOR HEAT REGISTERS BEING CEILING MOUNT ONLY.
 - WATER HEATERS TO BE C.E.C. CERTIFIED AND HAVE A PRESSURE & TEMPERATURE RELIEF DEVICES PER UPC 505.1.
 - FURNACES TO BE C.E.C. CERTIFIED AND COMPLY WITH UMC 302.1
 - PROVIDE CLEARANCES AROUND WATER HEATER AND FURNACE PER UMC 304.6 & TABLE 3-B AND UPC 508 & 511.
 - EQUIPMENT WHICH HAS A FLAME, GENERATES A SPARK, OR USES A GLOWING SOURCE SHALL COMPLY WITH UMC 303.3 AND UPC 510.1
 - FURNACE TO BE ANCHORED OR STRAPPED TO RESIST EARTHQUAKES PER UMC 308.
 - WATER HEATER TO BE ANCHORED OR STRAPPED TO RESIST EARTHQUAKES PER UPC 510.5.
 - IN SHOWERS & TUB/SOWER COMBINATIONS, INDIVIDUAL CONTROL VALVES MUST BE PRESSURE BALANCED OR THERMOSTATIC MIXING VALVES PER UPC 420.
 - SHOWERHEADS, LAVATORY AND SINK FAUCETS SHALL HAVE A MAXIMUM FLOW RATE OF 2.5 GPM PER CALIFORNIA ENERGY COMMISSION
 - WATER CLOSETS AND ASSOCIATED FLUSHMETER VALVES, IF ANY, SHALL USE NO MORE THAN 1.6 GALLONS PER FLUSH AND SHALL MEET PERFORMANCE STANDARDS BY A.N.S.I.S. A112.19.2 HAS CODE SECTION 1792(B).
 - PROVIDE COMBUSTION AIR FOR FUEL-BURNING EQUIPMENT PER UMC 507 AND TABLE 7-A.
 - ALL VENT TERMINATIONS MUST BE 10' AWAY OR 3' ABOVE ANY OPENINGS PER UMC 504.6.
 - ALL AIR DUCTS PENETRATION SEPERATION WALL OR CEILING BETWEEN GARAGE AND LIVING AREA SHALL BE A MINIMUM OF 26 GAUGE PER UBC 302.4 EXCEPTION #3.
 - PROVIDE CONFORMING DRYER EXHAUST TO OUTSIDE. TOTAL LENGTH SHALL NOT EXCEED 14 FEET INCLUDING TWO 90°-ELBOWS. CMC 504.3.2 AND 908.
 - ALL HOSE BIBBS SHALL HAVE NON-REMOVABLE TYPE BACK-FLOW PREVENTION DEVICE. PER UPC 603.4.7
 - NO UNDERFLOOR CLEANOUT SHALL BE LOCATED MORE THAN 20 FEET FROM AN ACCESS DOOR, TRAP DOOR, OR CRAWL HOLE PER UPC 707.
 - IF HOUSE IS TO HAVE PROPANE (LPG) GAS, IT MUST MEET THE REQUIREMENTS OF UPC 1213.

ELECTRICAL NOTES

- ELECTRICAL LIGHTING & MECHANICAL DEVICES SHOWN ON THE DRAWINGS INDICATES ARCHITECTURAL DESIGN INTENT ONLY. ELECTRICAL AND MECHANICAL SUBCONTRACTOR TO MEET WITH OWNER FOR FINAL APPROVAL AND/OR REVISIONS.
- ITEMS TO BE VERIFIED WITH OWNER:
 - PHONE & TV JACK LOCATIONS PRIOR TO INSTALLATION. VERIFY TYPE OF CABLING AND NUMBER OF LINES.
 - ALL ELECTRICAL FIXTURES, APPLIANCES INCLUDING MAKE AND MODEL NUMBERS.
 - PROVIDE COMPLETE & OPERATING CENTRAL VACUUM SYSTEM. PROVIDE DEDICATED ELECTRICAL CIRCUIT FOR SYSTEM.
 - ROUGH WIRE AND STUBB-OUT FOR FUTURE LANDSCAPE LIGHTING, SPA OR ENTRY GATE - PROVIDE CIRCUITS & PVC CONDUIT.
 - LOW VOLTAGE SWITCHING REQUIREMENTS.
 - PROVIDE MOTION ACTIVATED EXTERIOR & SECURITY LIGHTING. VERIFY SPECIAL REQUIREMENTS FOR HIGH SPEED ACCESS LINES FOR COMPUTER CONNECTIONS TO THE INTERNET.
- SPAS, HOT TUBS AND HYDROMASSAGE BATHTUBS SHALL COMPLY WITH N.E.C. 680-41 AS FOLLOWS:
 - RECEPTACLES ON THE PROPERTY SHALL BE LOCATED AT LEAST 5 FEET FROM THE INSIDE WALL OF THE SPA OR HOT TUB.
 - ALL 125 VOLT RECEPTACLES WITHIN TWO FEET OF THE INSIDE WALLS OF A SPA OR TUB SHALL BE PROTECTED BY A POWER TO THE SPA HOT TUB. LIGHTING FIXTURES AND LIGHTING OUTLETS LOCATED OVER THE SPA OR HOT TUB OR WITHIN 5 FEET SHALL BE A MINIMUM OF 7 FOOT 6 INCHES ABOVE THE MAXIMUM WATER LEVEL AND SHALL BE PROTECTED BY A GROUND-FAULT CIRCUIT INTERRUPTER.(SEE EXCEPTION)
 - BONDING AND GROUNDING SHALL COMPLY WITH NEC 680-41(d), (e), (f), AND (g)
 - HYDROMASSAGE BATHTUBS AND THEIR ASSOCIATED ELECTRICAL COMPONENTS SHALL BE SUPPLIED BY A CIRCUIT PROTECTED BY A GROUND-FAULT CIRCUIT-INTERRUPTER, NEC 680-70
 - WALL SWITCHES SHALL BE LOCATED AT LEAST 5 FEET FROM WATER SOURCE.
- SMOKE DETECTORS:
 - PROVIDE AC/DC SMOKE DETECTORS WITHIN EACH SLEEPING ROOM & CENTRALLY LOCATED IN CORRIDOR OR AREA GIVING ACCESS TO EACH SEPARATE SLEEPING AREA. ALL SMOKE DETECTORS TO BE GROUND-FAULT CIRCUIT-INTERRUPTER INCLUDING RECEPTACLES PROVIDING INTERCONNECTED AND BE WIRED TO THE HOUSE PRIMARY WIRING AND SHALL ALSO HAVE BATTERY BACK-UP (TYPICAL)
 - SMOKE DETECTORS SHALL SOUND AN ALARM AUDIBLE IN ALL SLEEPING AREAS OF THE RESIDENCE PER UBC 310.9.1
- PROVIDE UFER ELECTRICAL GROUNDING CONCRETE ENCASED ELECTRODE PER NEC 250-5 ITEM (c).
- BOND ALL INTERIOR METALLIC GAS AND WATER PIPES TO THE SERVICE GROUND PER NEC 250-80 (a) & (b).
- KITCHEN, BATH AND LAUNDRY:
 - ALL GENERAL PURPOSE LIGHTING @ KITCHENS AND BATHS TO HAVE AN EFFICACY RATING OF AT LEAST 40 LUMENS PER WATT (C.E.C. 150 (k)).
 - ALL KITCHEN & BATH LIGHTING FIXTURES SHALL COMPLY WITH C.E.C. AND T-24 REQUIREMENTS FOR TYPE AND SIZE.
 - LIGHTS OVER SHOWER AND TUBS MUST BE LABELED "SUITABLE FOR DAMP LOCATIONS" AND CONFORM TO NEC 410-4.
 - PROVIDE SEPARATE 20 AMP CIRCUIT MINIMUM ONE (1) FOR LAUNDRY APPLIANCES PER NEC 220-4(c)
 - PROVIDE SEPARATE 20 AMP CIRCUIT MINIMUM TWO (2) FOR SMALL KITCHEN APPLIANCES PER NEC 220-4(b)
 - PROVIDE RECEPTACLE OUTLETS AT KITCHEN COUNTER TOP AT 4' O.C. OR NO GREATER THAN 2' FROM AN INSTALLED APPLIANCE OR SINK PER NEC 210-52(c).
 - ALL ELECTRICAL OUTLETS AT BATH AREAS TO MEET NEC 210-52(c) AND 210-8(b).
- PROVIDE SEPARATE 20 AMP CIRCUIT MINIMUM ONE (1) FOR LAUNDRY APPLIANCES PER NEC 220-4(c).
- ELECTRICAL LIGHTING:
 - LIGHTS IN CLOSETS MUST HAVE AN ENCLOSED BULB PER UBC 410-8.
 - ALL RECESSED FIXTURES IN CEILINGS THAT ARE TO BE INSULATED MUST BE I.C. TYPE FIXTURE PER NEC 410.66(b)
- ELECTRICAL OUTLETS:
 - OUTLETS ALONG HOUSE/GARAGE COMMON WALL SHALL BE MOUNTED AT +18" ABOVE FINISH SLAB AND COMPLY WITH PROVIDE WATERPROOF OUTLET COVERS ON ALL OUTSIDE RECEPTALS PER NEC 410-57(b) AND UBC 709.7.

ELECTRICAL SYMBOLS LIST


	110V DUPLEX OUTLET
	110V DUPLEX OUTLET FOR A/C
	CEILING FAN WITH LIGHT
	RECESSED LED DOWN CAN LIGHT
	SINGLE POLE SWITCH
	DOUBLE POLE SWITCH
	CEILING FAN W/ LIGHT FIXTURE
	WALL SCONCE
	EXHAUST FAN W/ LIGHT FIXTURE

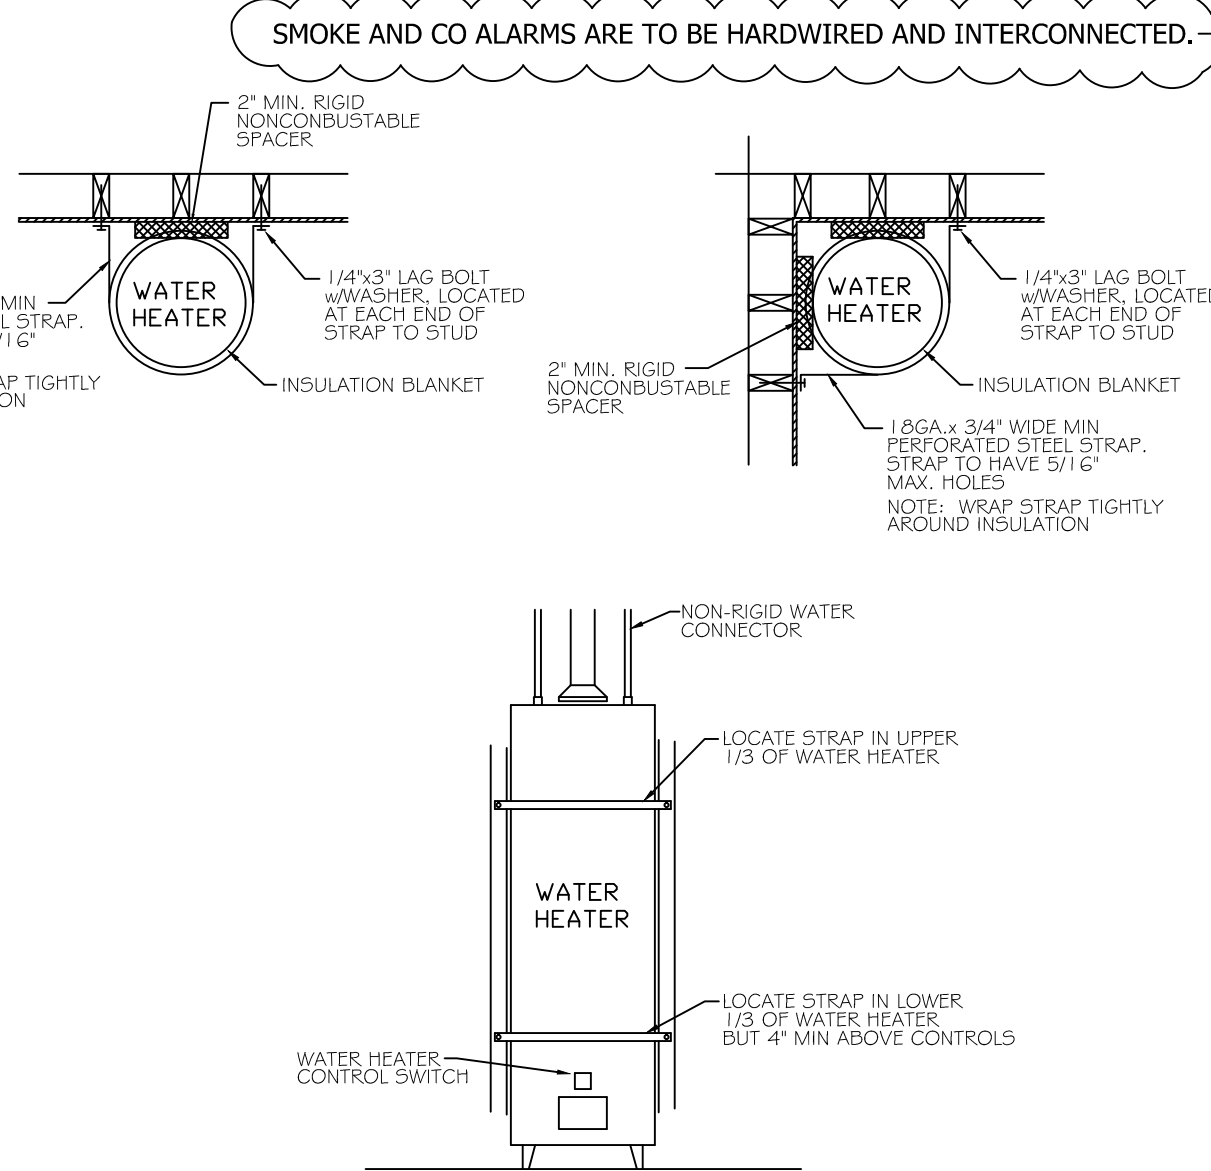

SMOKE AND CO ALARMS ARE TO BE HARDWIRED AND INTERCONNECTED.


ELECTRICAL NOTES

- ELECTRICAL LIGHTING & MECHANICAL DEVICES SHOWN ON THE DRAWINGS INDICATES ARCHITECTURAL DESIGN INTENT ONLY. ELECTRICAL AND MECHANICAL SUBCONTRACTOR TO MEET WITH OWNER FOR FINAL APPROVAL AND/OR REVISIONS.
- ITEMS TO BE VERIFIED WITH OWNER:
 - PHONE & TV JACK LOCATIONS PRIOR TO INSTALLATION. VERIFY TYPE OF CABLING AND NUMBER OF LINES.
 - ALL ELECTRICAL FIXTURES, APPLIANCES INCLUDING MAKE AND MODEL NUMBERS.
 - PROVIDE COMPLETE & OPERATING CENTRAL VACUUM SYSTEM. PROVIDE DEDICATED ELECTRICAL CIRCUIT FOR SYSTEM.
 - ROUGH WIRE AND STUBB-OUT FOR FUTURE LANDSCAPE LIGHTING, SPA OR ENTRY GATE - PROVIDE CIRCUITS & PVC CONDUIT.
 - LOW VOLTAGE SWITCHING REQUIREMENTS.
 - PROVIDE MOTION ACTIVATED EXTERIOR & SECURITY LIGHTING. VERIFY SPECIAL REQUIREMENTS FOR HIGH SPEED ACCESS LINES FOR COMPUTER CONNECTIONS TO THE INTERNET.
- SPAS, HOT TUBS AND HYDROMASSAGE BATHTUBS SHALL COMPLY WITH N.E.C. 680-41 AS FOLLOWS:
 - RECEPTACLES ON THE PROPERTY SHALL BE LOCATED AT LEAST 5 FEET FROM THE INSIDE WALL OF THE SPA OR HOT TUB.
 - ALL 125 VOLT RECEPTACLES WITHIN TWO FEET OF THE INSIDE WALLS OF A SPA OR TUB SHALL BE PROTECTED BY A POWER TO THE SPA HOT TUB. LIGHTING FIXTURES AND LIGHTING OUTLETS LOCATED OVER THE SPA OR HOT TUB OR WITHIN 5 FEET SHALL BE A MINIMUM OF 7 FOOT 6 INCHES ABOVE THE MAXIMUM WATER LEVEL AND SHALL BE PROTECTED BY A GROUND-FAULT CIRCUIT INTERRUPTER.(SEE EXCEPTION)
 - BONDING AND GROUNDING SHALL COMPLY WITH NEC 680-41(d), (e), (f), AND (g)
 - HYDROMASSAGE BATHTUBS AND THEIR ASSOCIATED ELECTRICAL COMPONENTS SHALL BE SUPPLIED BY A CIRCUIT PROTECTED BY A GROUND-FAULT CIRCUIT-INTERRUPTER, NEC 680-70
 - WALL SWITCHES SHALL BE LOCATED AT LEAST 5 FEET FROM WATER SOURCE.
- SMOKE DETECTORS:
 - PROVIDE AC/DC SMOKE DETECTORS WITHIN EACH SLEEPING AREA. ALL SMOKE DETECTORS TO BE GROUND-FAULT CIRCUIT-INTERRUPTER INCLUDING RECEPTACLES PROVIDING INTERCONNECTED AND BE WIRED TO THE HOUSE PRIMARY WIRING AND SHALL ALSO HAVE BATTERY BACK-UP (TYPICAL)
 - SMOKE DETECTORS SHALL SOUND AN ALARM AUDIBLE IN ALL SLEEPING AREAS OF THE RESIDENCE PER UBC 310.9.1
- PROVIDE UFER ELECTRICAL GROUNDING CONCRETE ENCASED ELECTRODE PER NEC 250-5 ITEM (c).
- BOND ALL INTERIOR METALLIC GAS AND WATER PIPES TO THE SERVICE GROUND PER NEC 250-80 (a) & (b).

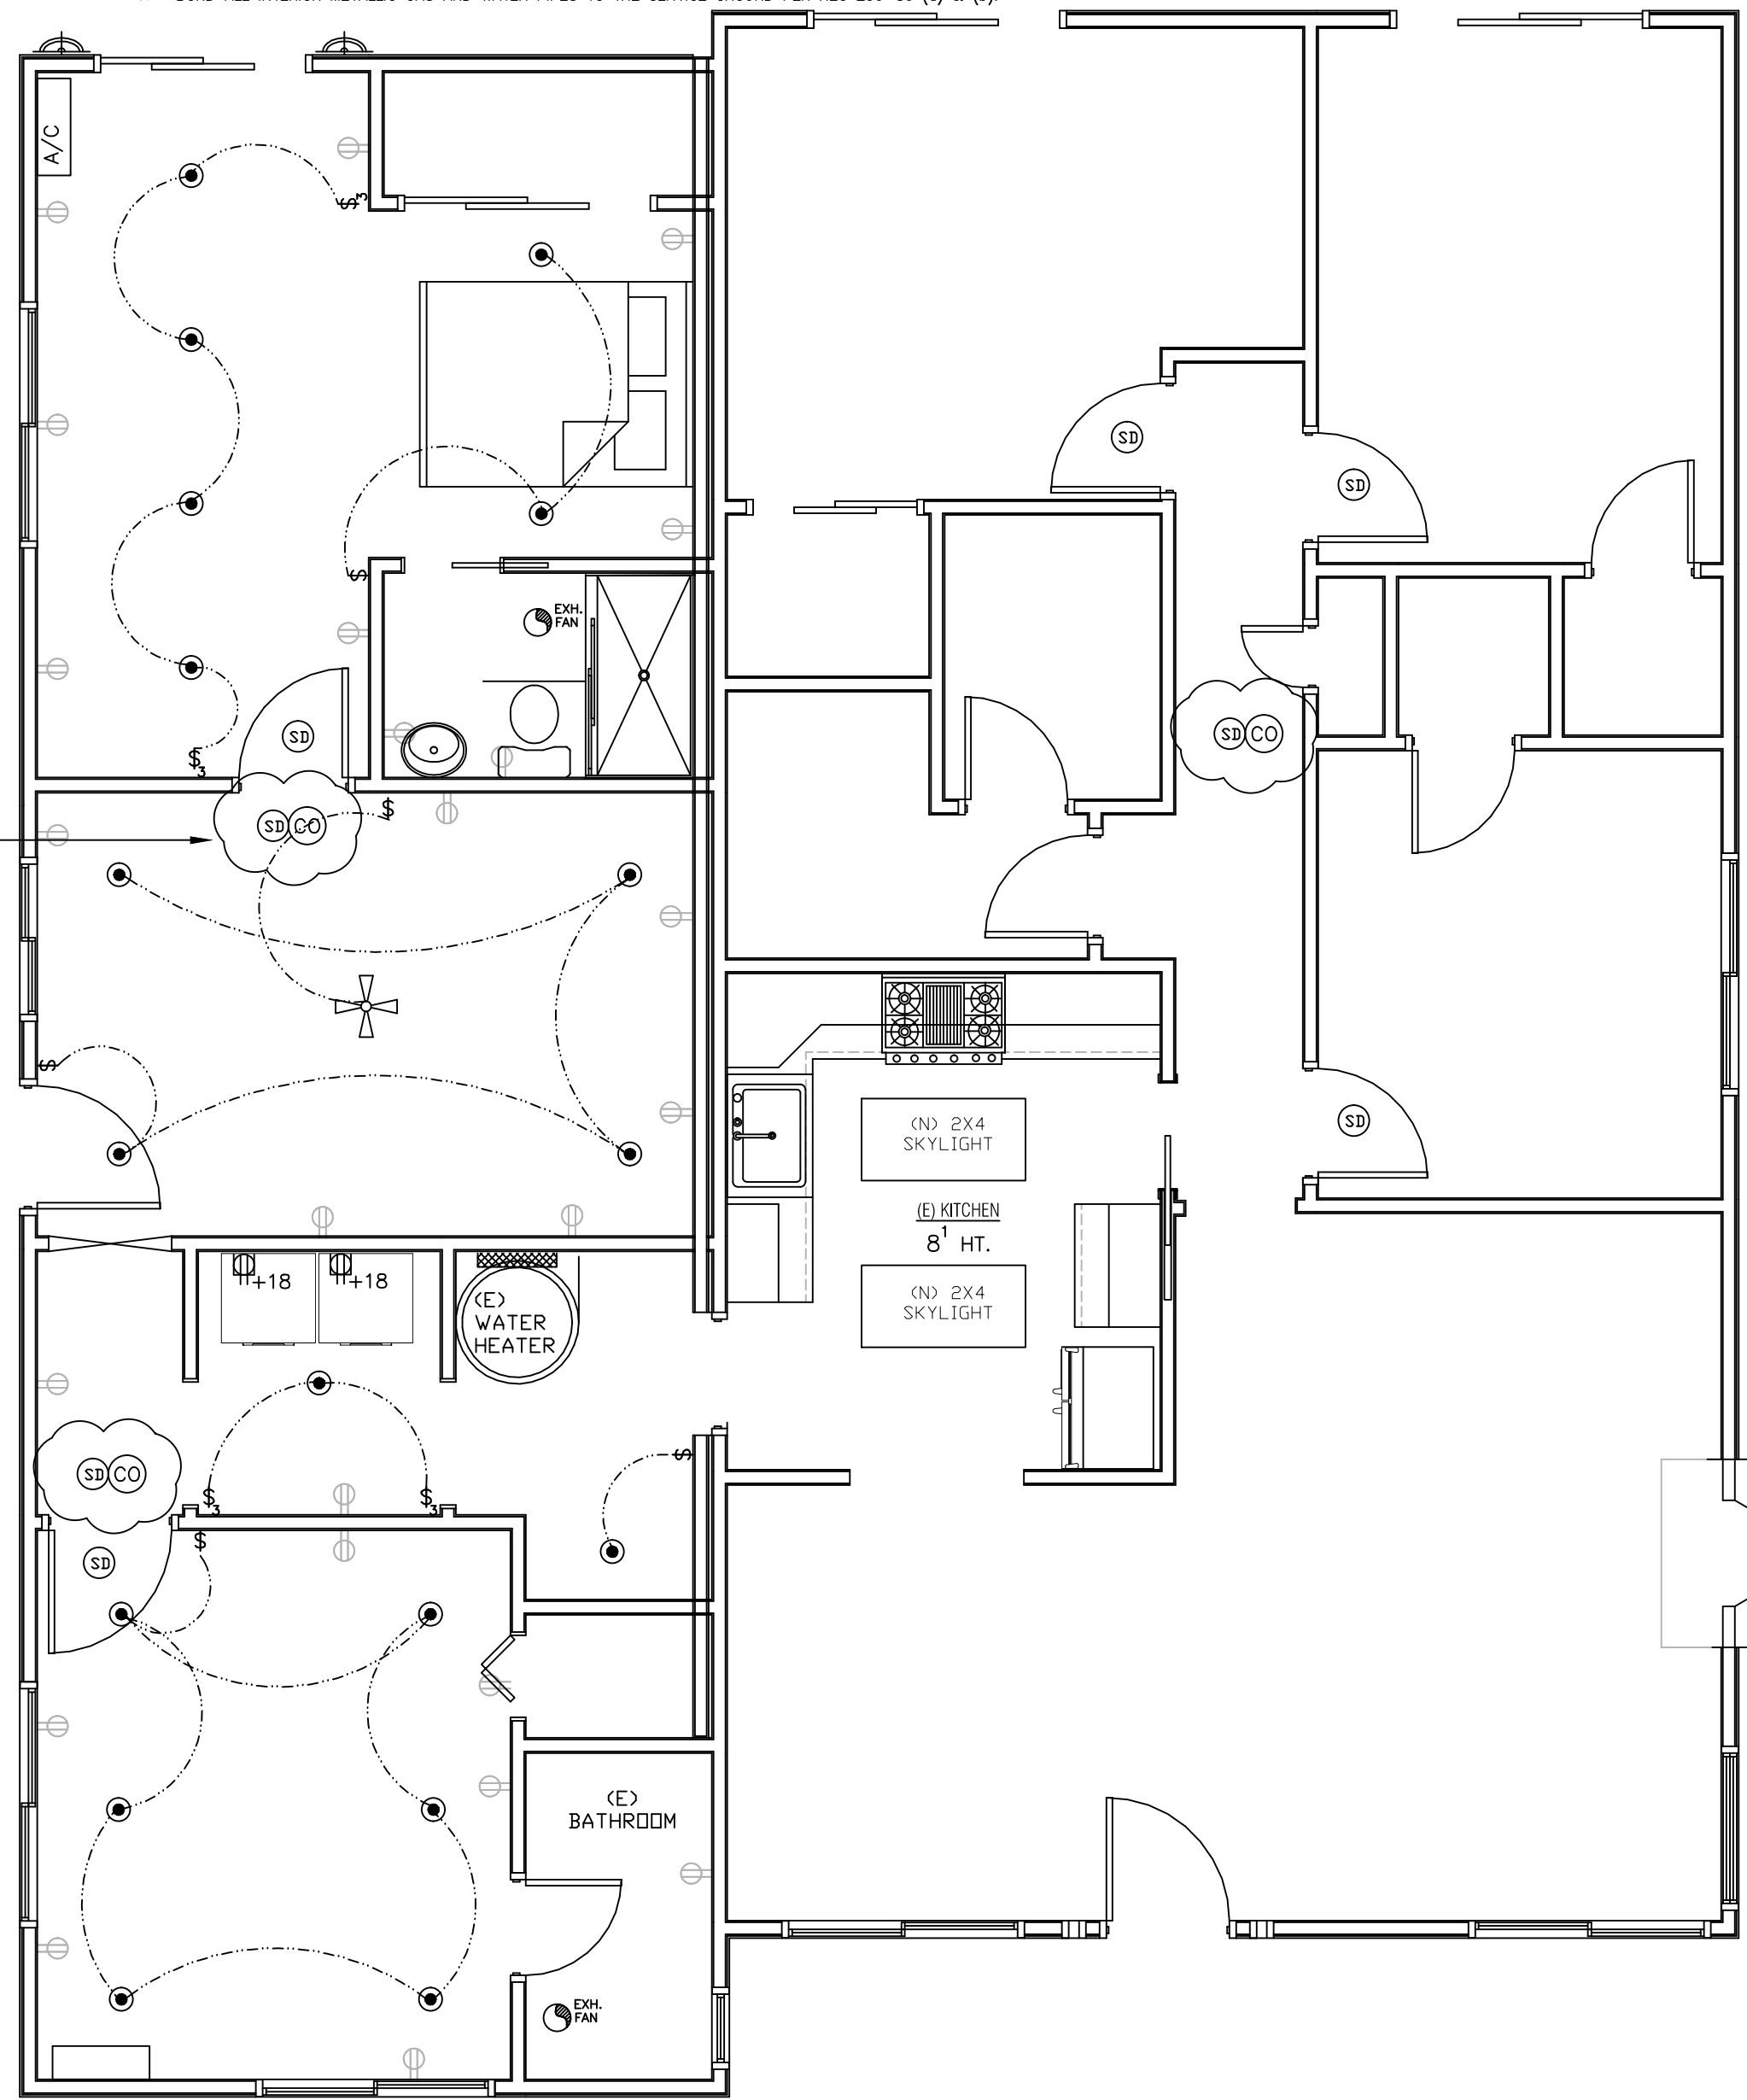

Proposed Electrical Plan

SCALE: 1/4"=1'-0"

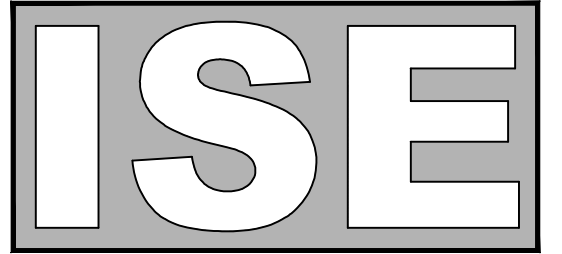

Ingram Structural Engineering
Jeff Ingram, P.E. **Yola Ingram**
 Civil Engineer Architectural Designer
 License No. C 66222 Kitchen and Bath Specialist
 E: Jeff@ingramse.com E: Yola@ingramse.com
 C (408) 836-6602 C (408) 836-6604

2570 N. First Street
 Suite 200
 San Jose, CA 95131
 www.ingramse.com
 DesignTeam@ingramse.com, jeff@ingramse.com



VESA RESIDENCE

Property Owners	OVIDIU VESA
Project Address	684 N Redwood Ave, San Jose, CA 95128
Phone	650-278-2869
Parcel	274-45-086
Site Area	7870 ft ²
Zoning	R-1-8 Single Family Residential City of San Jose
Setbacks	Front: 25'-0" Sides: 5'-0" Rear: 20'-0" Max Height: 35'-0"
Proposed Setbacks	Front: 25'-0" +/- (EXISTING) Right Side: 5'-0" +/- (EXISTING) Left Side: 10'-2" +/- Rear: 66'-2" +/- Blotg Height: 14'-6" +/-
Construction	Type V-B
Occupancy	R-3 & U

DATE ISSUE:


7/6/2022	PER BUILDING DEPARTMENT PLAN CHECK
1/9/2023	PER PERMIT CENTER
1/26/2023	PLANNING PLAN CHECK

THESE STRUCTURAL DRAWINGS WERE PRODUCED BY ISE. THE USE OF THESE PLANS AND SPECIFICATIONS SHALL BE RESTRICTED TO THE ORIGINAL SITE FOR WHICH THEY WERE PREPARED, AND PUBLICATION THEREOF IS EXPRESSLY LIMITED TO SUCH USE. RE-USE, REPRODUCTION, OR PUBLICATION BY ANY METHOD, IN WHOLE OR IN PART, IS PROHIBITED. FURTHERMORE, TITLE TO THE PLANS AND SPECIFICATIONS REMAINS WITH ISE. VISUAL CONTACT WITH THESE PLANS AND SPECIFICATIONS CONSTITUTE PROOF OF ACCEPTANCE OF ALL RESTRICTIONS.
 Copyright © 2022 ISE Ingram Structural Engineering

PROJECT #:	21.824	SCALE:	1/4"=1'-0"
DRAWN BY:	JI	PROJECT MANAGER:	JI
ENGINEERED BY:	JI	REVIEWED BY:	JI

Electrical Plan

E1


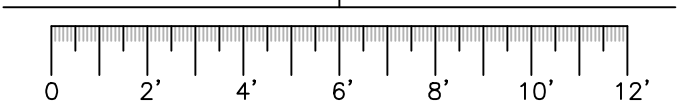


SHEAR WALL SCHEDULE (See Notes)				2x SILL P		per AWC SDPWS-15 Table 4.3A		USED IN CALCULATIONS	
SHEAR WALL TYPE	PLYWOOD or OSB SHEATHING (17)	EDGE NAILING (2,13) (14,15)	JOISTS or BLOCKS TO TOP PLATE	SOLE PLATE TO JOISTS or BLK'G	SILL BOLTS TO CONCRETE	NOMINAL UNIT SHEAR	ALLOWABLE UNIT SHEAR	ALLOWABLE UNIT SHEAR	
(SEE PLANS)	APA RATED CDX DOC PS 1 or PS 2	8d Common Nails (23)	SIMPSON ANCHOR (23)	16d COMMON NAILS	5/8" x 7" EMBED. (1,3,16,18) Note (4)				
6	3/8" or 7/16"	@6" o.c.	A35 at 24" o.c.	@10" o.c.	@4"-0" o.c. 2x SILL PLATE	520 lb/ft	260 lb/ft	260 lb/ft	
4	3/8" or 7/16"	@4" o.c.	A35 at 16" o.c.	@7" o.c.	@3"-9" o.c. 2x SILL PLATE	760 lb/ft	380 lb/ft	380 lb/ft	
3	3/8" or 7/16"	@3" o.c.	A35 at 12" o.c.	@5 1/2" o.c.	@3"-0" o.c. 2x SILL PLATE	980 lb/ft	490 lb/ft	490 lb/ft	
2	3/8" or 7/16"	@2" o.c.	(2) A35 at 16" o.c.	@4" o.c.	@2"-3" o.c. 2x SILL PLATE	1280 lb/ft	640 lb/ft	640 lb/ft	
4	3/8" or 7/16"	@4" o.c.	(SEE DETAILS)	(SEE DETAILS)	(SEE DETAILS)	1520 lb/ft	760 lb/ft	760 lb/ft	
3	3/8" or 7/16"	@3" o.c.	(SEE DETAILS)	(SEE DETAILS)	(SEE DETAILS)	1960 lb/ft	980 lb/ft	980 lb/ft	

ALL FIELD NAILING SHALL BE 8d COMMON at 12" o.c.
 (1) AT ROOF, SPACE SHEAR CLIP BETWEEN EACH RAFTER BAY @ 6" CENTER EXTERIOR WALLS, U.O.N. (2) SILL ANCHOR BOLTS SHALL BE HOT-DIPPED GALVANIZED

- NOTES:** (CONTRACTOR SHALL READ & UNDERSTAND THESE NOTES BEFORE CONSTRUCTION)
- In Seismic Design Category D, E, or F, (SEE NOTE #20 FOR SEISMIC DESIGN CATEGORY FOR THIS PROJECT) where shear design values exceed 350 pounds per linear foot, all framing members receiving edge nailing from ABUTTING PANELS shall not be less than a single 3-inch nominal member, USE 3x or 4x (DEPTH TO MATCH WALL FRAMING) MEMBER @ SHEAR ABUTTING PANEL EDGES.
 - Nails shall be 8d COMMON (0.131"x2-1/4" COMMON) with minimum 1.131-inch nail penetration into framing members or blocking.
 - Foundation sill plates shall be Pressure Treated Douglas-Fir Larch No. 2 or equal lumber; See shear schedule for sill plate size. All sill plates bolted to concrete with 5/8" diameter x12" bolts spaced not more than 4'-0" o.c., with a minimum of two bolts for each piece of sill plate. Anchor bolts shall have a 4.5" minimum and a 12" maximum clearance to the end of the sill plate, and 1" minimum embedment into concrete or masonry. Sill plate size & anchorage in Seismic Design Category D, E, or F: Plate washers shall be minimum 0.229" x 3" x 3" in size, between sill plate & nut. The hole in the plate washer is permitted to be diagonally slotted with a width up to 3/16" larger than the base diameter and the slot length not to exceed 1-3/4", provided a standard cut washer is placed between the plate washer and the nut. Sill plates resisting a design load greater than 350 plf using ASD shall not be less than a 3-inch nominal member. See note (16) for exception.
 - Where panels applied on both faces of a wall AND nail spacing is less than 6" o.c. on either side, panel joints shall be offset to fall on different framing members, or framing shall be 3-inch nominal or thicker at adjoining panel edges and nails on each side shall be staggered.
 - All shear wall sheathing shall extend to the bottom of the roof sheathing U.O.N. by the structural details.
 - Provide stud or blocking at unsupported panel edge.
 - Extend shear sheathing over all openings for continuous shear support & uniform wall thickness.
 - Shear wall panels shall not be less than 24" in either direction; EXCEPTION: Shear plywood panel may be less than 24" provided that all edges of the undersized sheath are supported by and fastened to framing members or blocking.
 - Panel edges backed with 2-inch nominal or wider framing. Install panels either horizontally or vertically. Space fasteners maximum 12" o.c. on intermediate supports for studs spaced @16" o.c.
 - All posts receiving hold-downs shall have shear edge nailing full height.
 - Floor plywood shall be glued and fastened to the rim joist or blocking for the use of 16d COMMON shear wall bottom plate fasteners. Glue shall meet the requirements of the APA adhesive spec. AFG-D, and shall be applied as per manufacturer's recommendations; glue may be applied manually or with pneumatic or electric equipment.
 - 15/32" plywood or OSB sheathing may be used in lieu of 3/8" or 7/16".
 - If gun nails (power driven fasteners) are used, then adjust the power such that the nail head does not penetrate the plywood sheathing. The head of shear wall nails shall not penetrate the plywood.
 - When ordering large quantities of nails, verify the carton label or with the manufacturer that the nails have the same length & diameter values as the nails specified in note #2.
 - Framing at adjoining panel edges shall be 3 inches nominal or wider, and nails shall be staggered.
 - VOID
 - Shear plywood sheathing shall be APA rated DOC PS-1 or PS-2 (APA or TECO Performance-Rated) or OSB SHEATHING, 24/0 SPAN RATING for 3/8" 3-ply sheathing, 32/16 span rating for 15/32" sheathing (5-ply or OSB). See plans for more information.
 - Sill plate and anchor bolt is designed as per 2018 NDS Table 12E. For 2x sill plate with 5/8" bolt, allowable shear parallel to grain is (930 lb x1.6)=1490 lb; for 3x sill plate & 5/8" bolt, allowable shear is (1180 lb x1.6)=1890 lb.
 - Plywood shear wall nominal unit shear data was obtained from AWS SDPWS-15 Table 4.3A. Allowable shear equals the nominal shear divided by 2.0 as per SDPWS Section 4.3.3. Allowable shears for 3/8" are permitted to be increased for 15/32" plywood with same nailing provided: (A) Studs are spaced a maximum of 16" on center, or (B) if panels are applied with long dimension across studs. SDPWS-15 Table 4.3A footnote 2.
 - Seismic Design Category = D

- ADDITIONAL SHEAR WALL NOTES:**
- CONTRACTOR SHALL REVIEW ALL TYPICAL SHEAR WALL CONNECTION DETAILS & NOTES PRIOR TO CONSTRUCTION.
 - A) SAME as NOTE #2 ABOVE.
 - B) HDG=HOT-DIPPED GALVANIZED NAILS SHALL BE USED FOR ALL SILL PLATE NAILING (i.e. TO P.T. LUMBER, TYP.)
 - A) ALL SHEAR WALL PLYWOOD NAILING EDGES SHALL BE FASTENED TO SOLID FRAMING MEMBERS OR BLOCKING.
 - B) SHEAR PLYWOOD SHALL BE FASTENED DIRECTLY TO THE STUDS, AND STUDS SHALL BE SPACED NOT MORE THAN 16" o.c.
 - C) DO NOT "OVER-NAIL" THE SHEAR WALL. SPACE NAILING IN ACCORDANCE TO THE SHEAR WALL SCHEDULE.
 - D) DO NOT "OVER-SHOOT" THE NAILS INTO THE PLYWOOD, THE HEAD OF THE NAILS SHOULD BE FLUSH WITH THE FACE OF PLYWOOD. IF POWER-DRIVEN NAILING IS DONE, RECOMMEND ADJUSTING THE POWER SUCH THAT THE HEAD OF THE NAILS DO NOT PENETRATE THROUGH THE PLYWOOD, AND THE USE OF A HAMMER TO FINISH OFF THE NAILING.
 - E) AT SHEAR WALL ABUTTING PANEL EDGES, RECOMMEND 4x (DEPTH TO MATCH WALL FRAMING) TO RECEIVE NAILING FROM EACH PLYWOOD SHEET. MINIMUM ONE 2x STUD IS ACCEPTABLE FOR TYPE 1 SHEAR WALL ONLY @ ABUTTING PANEL EDGES. FOR SHEAR WALL TYPES 2, 3, 4, ... ETC. 3x OR 4x MEMBER IS MANDATORY AT ABUTTING PANEL EDGES.
 - AT EXISTING FOUNDATION CONDITIONS FOR SILL "SHEAR" BOLTS: USE 5/8" diameter HDG ALL-THREAD x7" EMBEDMENT, DRILL & CLEAN-OUT HOLES SHALL BE USED. USE SIMPSON SET-ADHESIVE, NOTE THAT SOME CITY BUILDING DEPARTMENTS MAY WANT SPECIAL INSPECTION DURING THIS PROCESS- THIS SHOULD BE VERIFIED BY THE CONTRACTOR PRIOR TO THE PLACEMENT OF EPOXY. IN LIEU OF THE USE OF EPOXY FOR SILL ANCHOR SHEAR BOLTS ONLY, 5/8" dia. x(7" EMBED.) Titen HD SCREWS MAY BE USED; TITEN BOLTS SHALL BE HOT-DIPPED GALVANIZED and the TYPICAL 7"x3"x1/4" HDG PLATE WASHERS SHALL BE USED.
 - AT EXISTING FOUNDATION CONDITIONS FOR EPOXY RETROFIT HOLDINGS- SPECIAL INSPECTION IS MANDATORY DURING THE INSTALLATION, REFERENCE DETAILS or PLANS FOR INSTALLATION INFO.
 - ALL SIMPSON PRODUCTS ARE TO BE INSTALLED AS PER MANUFACTURER'S RECOMMENDATIONS.
 - A) LENGTH OF SHEAR WALL IS DEFINED AS THE EDGE OF PLYWOOD SHEET, AND THE MINIMUM SHEAR WALL LENGTH IS SPECIFIED ON THE PLANS.
 - PROVIDE E.N.=EDGE NAILING AT EACH PLYWOOD SHEET PERIMETER; AT CONDITIONS WHERE HOLD-DOWN OCCURS, E.N. TO BOTH THE HEADER BEARING STUD(S) AND TO THE FULL-Ht. POST RECEIVING THE HOLD-DOWN.

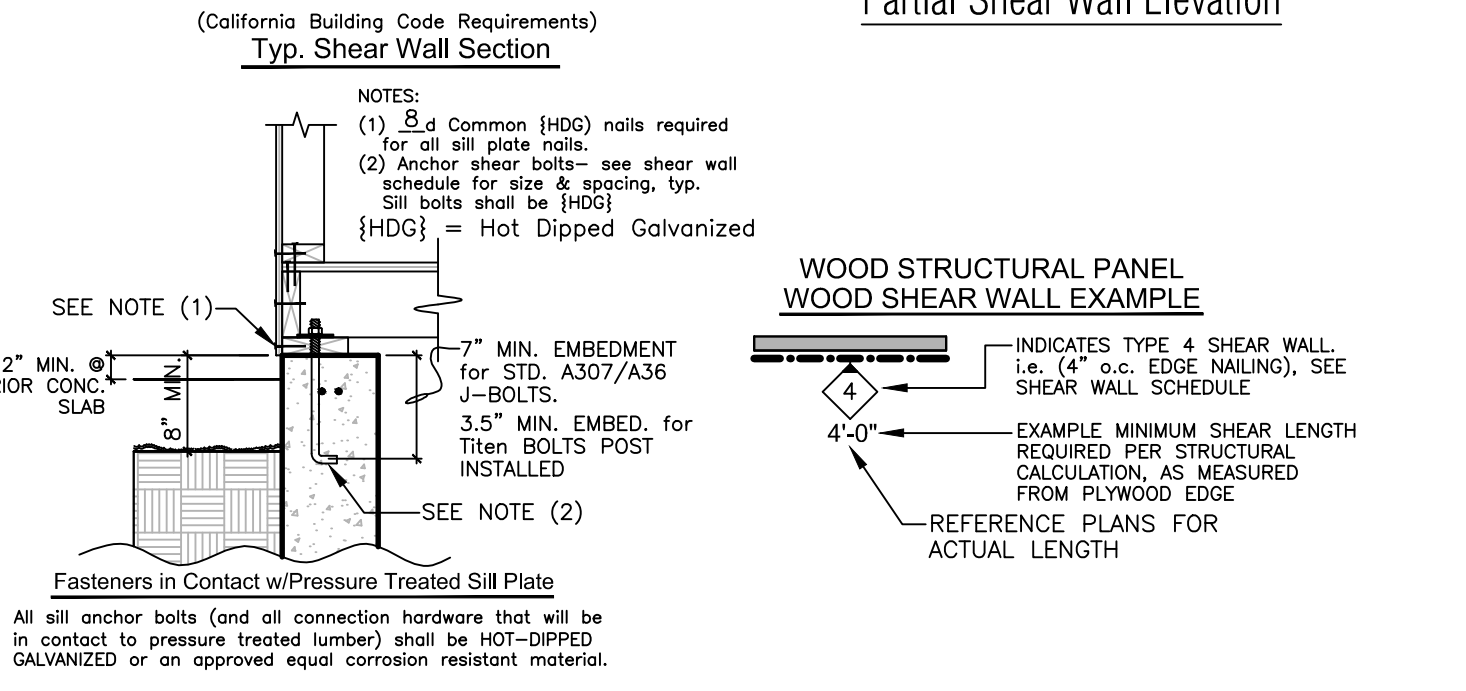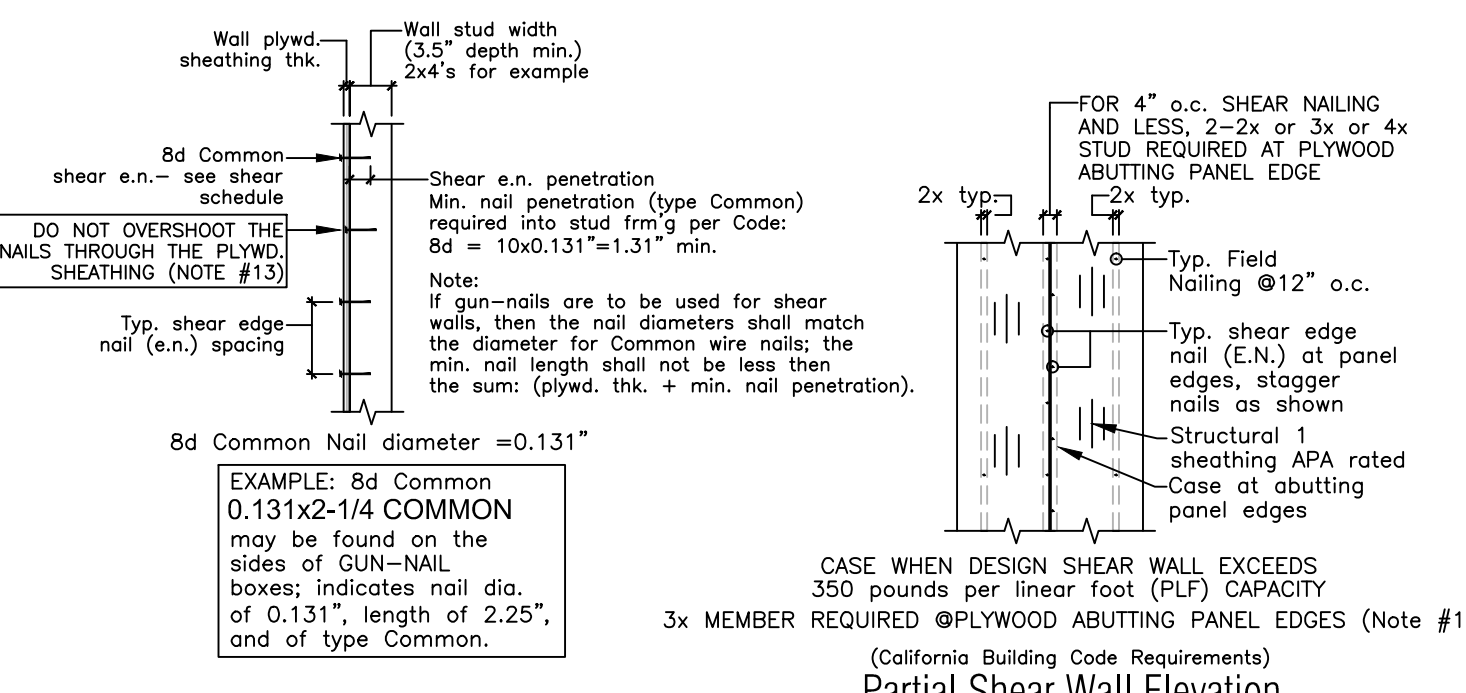

<<< Use 8d COMMON nails for shear wall nailing >>>
 <<< Use 8d COMMON HOT-DIPPED GALVANIZED nails for shear sill plate nailing >>>

SHEAR WALL SCHEDULE

- NOTES:**
- HEADERS: SEE HEADER SCHEDULE SHEET SD.2, TYP. U.O.N. ON PLANS.
 - PROVIDE 2x SOLID BLOCKING BELOW ALL BEARING WALLS PERPENDICULAR TO JOISTS.
 - PROVIDE DBL. JOISTS BELOW ALL BEARING WALLS PARALLEL TO JOISTS.
 - SEE SHEET SD.1 FOR GENERAL NOTES & STRUCTURAL SPECIFICATIONS.
 - FIELD VERIFY ALL EXISTING DIMENSIONS IN FIELD PRIOR TO CONSTRUCTION. ANY SIGNIFICANT DISCREPANCIES, STOP CONSTRUCTION & NOTIFY ARCHITECT & ENGINEER IN WRITING.
 - SEE ARCHITECTURAL PLANS FOR DIMENSIONS.
 - ALL METAL ANCHORS, FASTENERS, CONNECTORS, ETC. THAT WILL BE IN CONTACT WITH PRESSURE TREATED LUMBER (OR EXPOSED TO WEATHER CONDITIONS) SHALL BE HOT-DIPPED GALVANIZED, SILICONE BRONZE, STAINLESS STEEL or COPPER.
 - ALL HARDWARE TO BE "SIMPSON" or EQUAL PRODUCT U.O.N. ON PLANS.

- AVOIDING TROUBLES & PROBLEMS NOTES:**
- If a discrepancy arises between the drawings and field conditions, or where a detail is doubtful or interpretation or an unanticipated field condition is encountered, the engineer shall be immediately contacted for procedure to be followed. Such instructions shall be confirmed in writing and distributed to all affected parties, see "disclaimer" @right-side of sheet.
 - Wherever there is a conflict between details and specifications, or between details, or where doubtful of interpretation, the most restrictive shall govern as determined by the Engineer of Record.



PLYWOOD: Plywood sheathing (floor, & shear walls) shall not be less than 24" in either direction unless all edges of the undersized sheets are supported by and fastened to framing members or blocking.

MIN. DIMENSION OF ROOF SHEATHING TO BE 24"

ROOF PLYWOOD SHEATHING
 Roof Sheathing: 15/32" DOC PS-1 or DOC PS-2 Sheathing, EXP 1 with 32/16 Span Rating, APA Rated Plywood or OSB, Use 10d nails: 0.148"x2-1/4" HDG Gun nail @6" o.c. at BOUNDARY & EDGES & 12" o.c. IN THE FIELD; unblocked @intermediate panel edges U.O.N. on plans.
 NOTE: FOR NEW PLYWOOD INSTALLED OVER EXISTING 1x SKIP-SHEATHING, USE 10dx3" COMMON NAILS w/MIN. 1.5" NAIL PENETRATION INTO FRM'G MEMBERS.
 NOTE: CONTRACTOR TO VERIFY w/TITLE 24 ENERGY REPORT (if one such exists) IF "FOIL FACED SHEATHING" IS REQUIRED FOR ENERGY CONSERVATION. USE 1/2" EXT. GRADE Polatich Lumin'OSB Structural I FOIL FACED SHEATHING or EQUAL (FOIL FACE DOWN).

FLOOR PLYWOOD SHEATHING
 Floor Sheathing: 23/32" APA Rated DOC PS 1 or DOC PS 2 STURD-I -FLOOR sheathing; 48/24 SPAN RATING w/EXPOSURE 1 GLUE; USE 10d COMMON 0.148"x2-3/8" GALVANIZED RING SHANK NAILS @6" o.c. at BOUNDARY & EDGES & 12" o.c. IN THE FIELD; unblocked @ intermediate panel edges U.O.N. on plans.

SHEAR WALL PLYWOOD SHEATHING
 Shear wall plywood sheathing: MIN. 3/8" or 7/16" DOC PS-1 or PS-2 (APA or TECO Performance-Rated) Sheathing (or OSB), 24/0 SPAN RATING; Use 8d nails - 0.131" x2-1/4" HDG Gun nail; Reference shear wall schedule for shear wall type & notes.

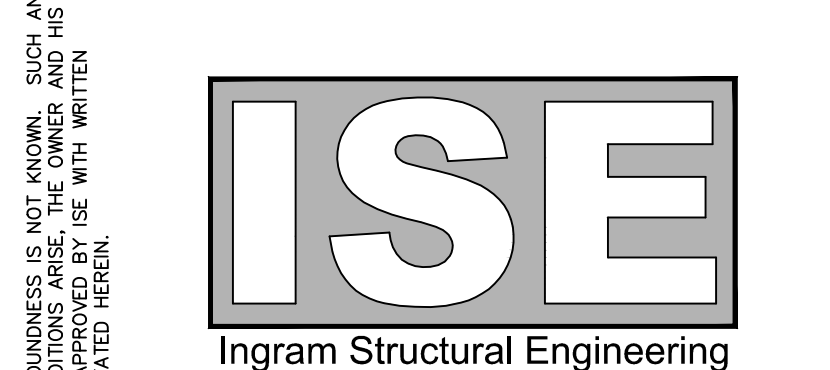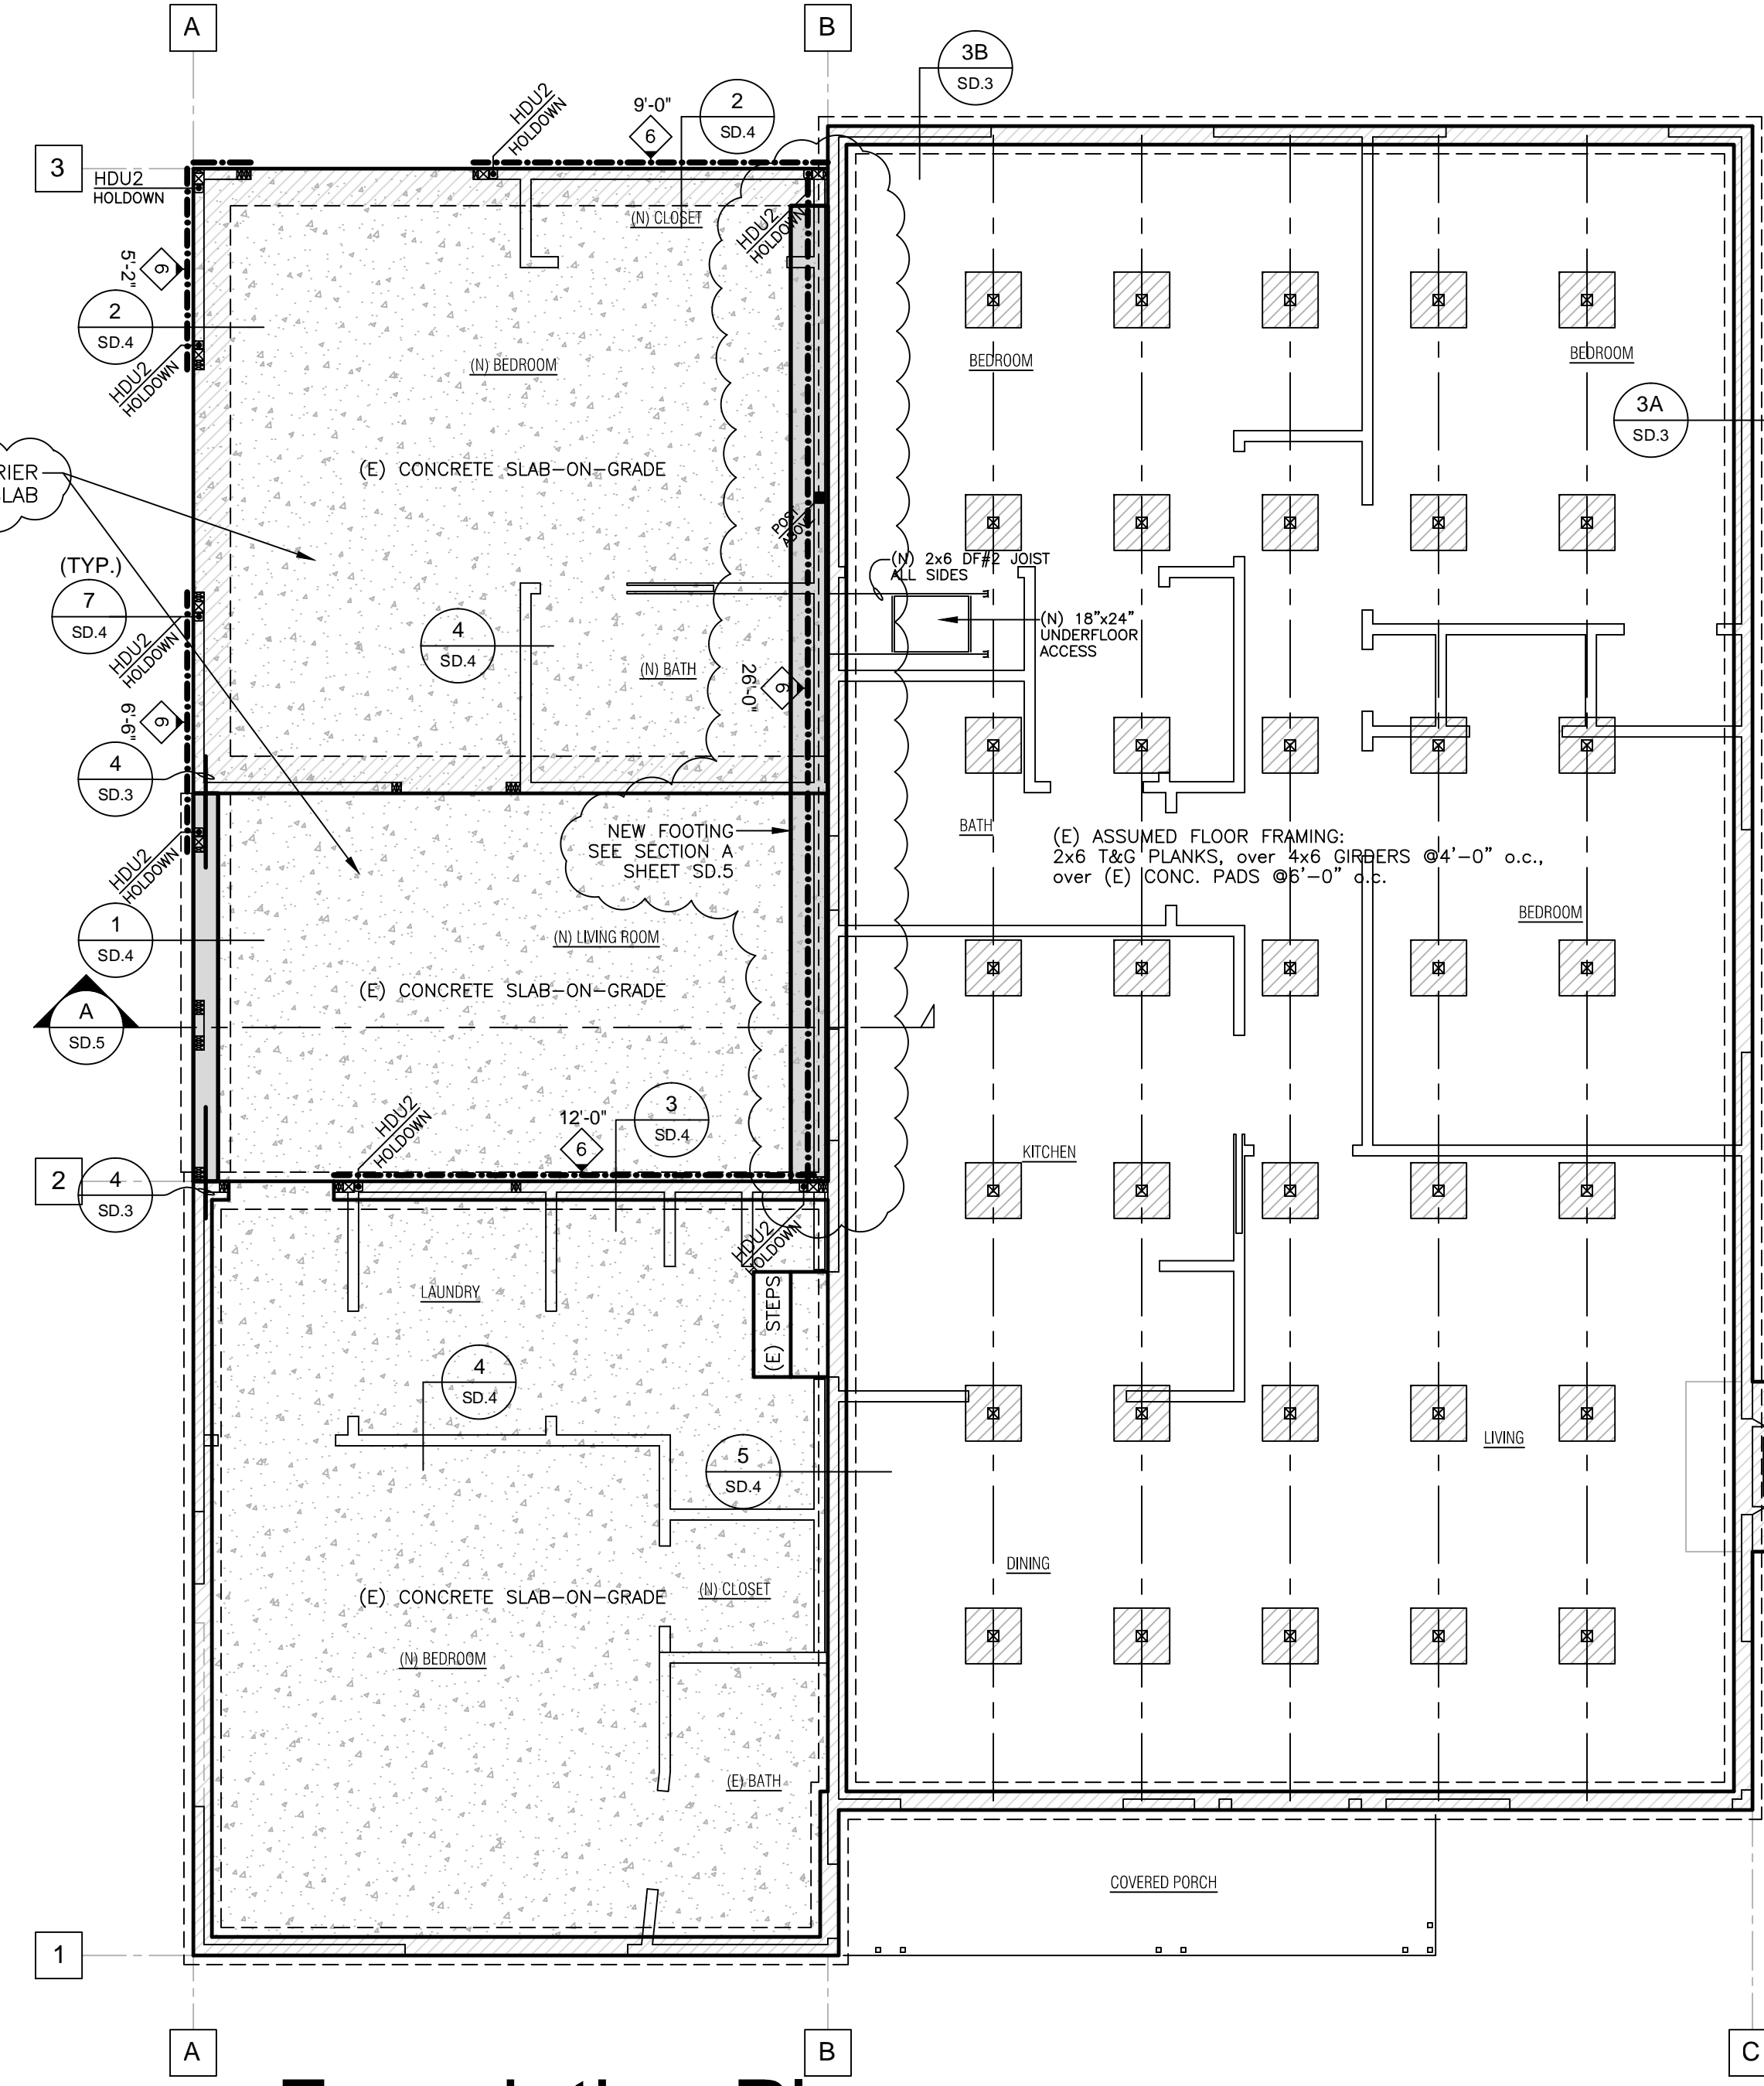

Jeff Ingram, P.E.
 CIVIL ENGINEER
 License No. C 66222
 2570 N. First Street, Suite 200
 San Jose, CA 95131
 (408) 836-6602 (Cell)
 (408) 836-6604 (Office)
 Email: jeff@ingram.com




JOB TITLE
 Vesa Residence
 684 N. Redwood Ave.
 San Jose, CA 95128

DATE ISSUE:
 3/2/2022
 PER BUILDING DEPARTMENT PLAN CHECK

THESE STRUCTURAL DRAWINGS WERE PRODUCED BY ISE. THE USE OF THESE PLANS AND SPECIFICATIONS SHALL BE RESTRICTED TO THE ORIGINAL SITE FOR WHICH THEY WERE PREPARED, AND PUBLICATION THEREOF IS EXPRESSLY LIMITED TO SUCH USE. RE-USE, REPRODUCTION, OR PUBLICATION BY ANY METHOD, IN WHOLE OR IN PART, IS PROHIBITED. FURTHERMORE, TITLE TO THE PLANS AND SPECIFICATIONS REMAINS WITH ISE. VISUAL CONTACT WITH THESE PLANS AND SPECIFICATIONS CONSTITUTE PROOF OF ACCEPTANCE OF ALL RESTRICTIONS.
 Copyright © 2022 ISE Ingram Structural Engineering

PROJECT # 824 SCALE: 1/4"=1'-0"
 DRAWN BY: YI, JI
 PROJECT MANAGER: JI
 ENGINEERED BY: JI
 REVIEWED BY: JI


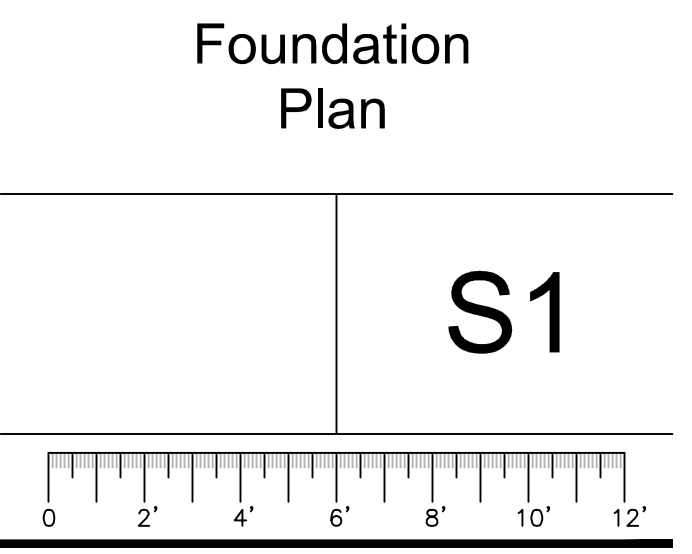


DISCLAIMER: THIS PROJECT IS A REMODEL OR AN ADDITION TO AN EXISTING STRUCTURE. THEN THE FOLLOWING APPLIES: THE INVESTIGATION OF THE MEMBERS OF THE EXISTING STRUCTURE THAT ARE TO BE REUSED IN THE NEW STRUCTURAL SYSTEM IS NOT COVERED BY THIS DESIGN CONTRACT. ENGINEERING SUCH MEMBERS ARE NOT EXPERTS AT THIS TIME. THEIR STRUCTURAL SOUNDNESS IS NOT KNOWN, SUCH AN INVESTIGATION SHOULD BE CONDUCTED BY ANOTHER ENGINEER. THE INVESTIGATION OF THE MEMBERS OF THE EXISTING STRUCTURE THAT ARE TO BE REUSED IN THE NEW STRUCTURAL SYSTEM IS NOT COVERED BY THIS DESIGN CONTRACT. ENGINEERING SUCH MEMBERS ARE NOT EXPERTS AT THIS TIME. THEIR STRUCTURAL SOUNDNESS IS NOT KNOWN, SUCH AN INVESTIGATION SHOULD BE CONDUCTED BY ANOTHER ENGINEER. THE INVESTIGATION OF THE MEMBERS OF THE EXISTING STRUCTURE THAT ARE TO BE REUSED IN THE NEW STRUCTURAL SYSTEM IS NOT COVERED BY THIS DESIGN CONTRACT. ENGINEERING SUCH MEMBERS ARE NOT EXPERTS AT THIS TIME. THEIR STRUCTURAL SOUNDNESS IS NOT KNOWN, SUCH AN INVESTIGATION SHOULD BE CONDUCTED BY ANOTHER ENGINEER.

SHEAR WALL SCHEDULE (See Notes)				2x SILL P		per AWC Table 4.3A		USED IN CALCULATIONS	
SHEAR WALL TYPE	PLYWOOD or OSB SHEATHING (17)	EDGE NAILING (2,13) (14,15)	JOISTS or BLOCKS TO TOP PLATE	SOLE PLATE TO JOISTS or BLK'G	SILL BOLTS TO CONCRETE	NOMINAL UNIT SHEAR	ALLOWABLE UNIT SHEAR	ALLOWABLE UNIT SHEAR	
(SEE PLANS)	APA RATED CDX DOC PS 1 or PS 2	8d Common Nails (23)	SIMPSON ANCHOR (Note 1)	16d COMMON NAILS	5/8" x 7" EMBED. (1,3,16,18) (Note 1)				
6	3/8" or 7/16"	@6" o.c.	A35 at 24" o.c.	@10" o.c.	@4"-0" o.c. 2x SILL PLATE	520 lb/ft	260 lb/ft	260 lb/ft	
4	3/8" or 7/16"	@4" o.c.	A35 at 16" o.c.	@7" o.c.	@3"-9" o.c. 2x SILL PLATE	760 lb/ft	380 lb/ft	380 lb/ft	
3	3/8" or 7/16"	@3" o.c.	A35 at 12" o.c.	@5 1/2" o.c.	@3"-0" o.c. 2x SILL PLATE	980 lb/ft	490 lb/ft	490 lb/ft	
2	3/8" or 7/16"	@2" o.c.	(2) A35 at 16" o.c.	@4" o.c.	@2"-3" o.c. 2x SILL PLATE	1280 lb/ft	640 lb/ft	640 lb/ft	
4	3/8" or 7/16"	@4" o.c.	(SEE DETAILS)	(SEE DETAILS)	(SEE DETAILS)	1520 lb/ft	760 lb/ft	760 lb/ft	
3	3/8" or 7/16"	@3" o.c.	(SEE DETAILS)	(SEE DETAILS)	(SEE DETAILS)	1960 lb/ft	980 lb/ft	980 lb/ft	

- NOTES: (CONTRACTOR SHALL READ & UNDERSTAND THESE NOTES BEFORE CONSTRUCTION)
- In Seismic Design Category D, E, or F, (SEE NOTE #20 FOR SEISMIC DESIGN CATEGORY FOR THIS PROJECT) where shear design values exceed 350 pounds per linear foot, all framing members receiving edge nailing from ABUTTING PANELS shall not be less than a single 3-inch nominal member, USE 3x or 4x (DEPTH TO MATCH WALL FRAMING) MEMBER @ SHEAR ABUTTING PANEL EDGES.
 - Nails shall be 8d COMMON (0.131"x2-1/4" COMMON) with minimum 1.131-inch nail penetration into framing members or blocking.
 - Foundation sill plates shall be Pressure Treated Douglas-Fir Larch No. 2 or equal lumber; See shear schedule for sill plate size. All sill plates bolted to concrete with 5/8" diameter x12" bolts spaced not more than 4'-0" o.c., with a minimum of two bolts for each piece of sill plate. Anchor bolts shall have a 4.5" minimum and a 12" maximum clearance to the end of the sill plate, and 1" minimum embedment into concrete or masonry. Sill plate size & anchorage in Seismic Design Category D, E, or F: Plate washers shall be minimum 0.229" x 3" x 3" in size, between sill plate & nut. The hole in the plate washer is permitted to be diagonally slotted with a width of up to 3/16" larger than the bolt diameter and the slot length not to exceed 1-3/4", provided a standard cut washer is placed between the plate washer and the nut. Sill plates resisting a design load greater than 350 plf using ASD shall not be less than a 3-inch nominal member. See note (16) for exception.
 - Where panels applied on both faces of a wall AND nail spacing is less than 6" o.c. on either side, panel joints shall be offset to fall on different framing members, or framing shall be 3-inch nominal or thicker at adjoining panel edges and nails on each side shall be staggered.
 - All shear wall sheathing shall extend to the bottom of the roof sheathing U.O.N. by the structural details.
 - Provide stud or blocking at unsupported panel edge.
 - Extend shear sheathing over all openings for continuous shear support & uniform wall thickness.
 - Shear wall panels shall not be less than 24" in either direction; EXCEPTION: Shear plywood panel may be less than 24" provided that all edges of the undersized sheath are supported by and fastened to framing members or blocking.
 - Panel edges backed with 2-inch nominal or wider framing. Install panels either horizontally or vertically. Space fasteners maximum 12" o.c. on intermediate supports for studs spaced @16" o.c.
 - All posts receiving hold-downs shall have shear edge nailing full height.
 - Floor plywood shall be glued and fastened to the rim joist or blocking for the use of 16d COMMON shear wall bottom plate fasteners. Glue shall meet the requirements of the APA adhesive spec. AFG-D, and shall be applied as per manufacturer's recommendations; glue may be applied manually or with pneumatic or electric equipment.
 - 15/32" plywood or OSB sheathing may be used in lieu of 3/8" or 7/16".
 - If gun nails (power driven fasteners) are used, then adjust the power such that the nail head does not penetrate the plywood sheathing. The head of shear wall nails shall not penetrate the plywood.
 - When ordering large quantities of nails, verify the carton label or with the manufacturer that the nails have the same length & diameter values as the nails specified in note #2.
 - Framing at adjoining panel edges shall be 3 inches nominal or wider, and nails shall be staggered.
 - VOID
 - Shear plywood sheathing shall be APA rated DOC PS-1 or PS-2 (APA or TECO Performance-Rated) or OSB SHEATHING, 24/0 SPAN RATING for 3/8" 3-ply sheathing, 32/16 span rating for 15/32" sheathing (5-ply or OSB). See plans for more information.
 - Sill plate and anchor bolt is designed as per 2018 NDS Table 12E. For 2x sill plate with 5/8" bolt, allowable shear parallel to grain is (930 lb x1.6)=1490 lb; for 3x sill plate & 5/8" bolt, allowable shear is (1180 lb x1.6)=1890 lb.
 - Plywood shear wall nominal unit shear data was obtained from AWS SDPWS-15 Table 4.3A. Allowable shear equals the nominal shear divided by 2.0 as per SDPWS Section 4.3.3. Allowable shears for 3/8" are permitted to be increased for 15/32" plywood with same nailing provided: (A) Studs are spaced a maximum of 16" on center, or (B) If panels are applied with long dimension across studs. SDPWS-15 Table 4.3A footnote 2.
 - Seismic Design Category = D

- ADDITIONAL SHEAR WALL NOTES:
- CONTRACTOR SHALL REVIEW ALL TYPICAL SHEAR WALL CONNECTION DETAILS & NOTES PRIOR TO CONSTRUCTION.
 - A) SAME as NOTE #2 ABOVE.
 - B) HDG=HOT-DIPPED GALVANIZED NAILS SHALL BE USED FOR ALL SILL PLATE NAILING (i.e. TO P.T. LUMBER, TYP.)
 - A) ALL SHEAR WALL PLYWOOD NAILING EDGES SHALL BE FASTENED TO SOLID FRAMING MEMBERS OR BLOCKING.
 - B) SHEAR PLYWOOD SHALL BE FASTENED DIRECTLY TO THE STUDS, AND STUDS SHALL BE SPACED NOT MORE THAN 16" o.c.
 - C) DO NOT "OVER-NAIL" THE SHEAR WALL. SPACE NAILING IN ACCORDANCE TO THE SHEAR WALL SCHEDULE.
 - D) DO NOT "OVER-SHOOT" THE NAILS INTO THE PLYWOOD, THE HEAD OF THE NAILS SHOULD BE FLUSH WITH THE FACE OF PLYWOOD. IF POWER-DRIVEN NAILING IS DONE, RECOMMEND ADJUSTING THE POWER SUCH THAT THE HEAD OF THE NAILS DO NOT PENETRATE THROUGH THE PLYWOOD, AND THE USE OF A HAMMER TO FINISH OFF THE NAILING.
 - E) AT SHEAR WALL ABUTTING PANEL EDGES, RECOMMEND 4x (DEPTH TO MATCH WALL FRAMING) TO RECEIVE NAILING FROM EACH PLYWOOD SHEET. MINIMUM ONE 2x STUD IS ACCEPTABLE FOR TYPE 1 SHEAR WALL ONLY @ ABUTTING PANEL EDGES. FOR SHEAR WALL TYPES 2, 3, 4, ... ETC. 3x OR 4x MEMBER IS MANDATORY AT ABUTTING PANEL EDGES.
 - AT EXISTING FOUNDATION CONDITIONS FOR SILL 'SHEAR' BOLTS: USE 5/8" diameter HDG ALL-THREAD x7" EMBEDMENT, DRILL & CLEAN-OUT HOLES WITH USE SHIELDING NET-UP ABOVE. NOTE THAT SOME CITY BUILDING DEPARTMENTS MAY WANT SPECIAL INSPECTION DURING THIS PROCESS- THIS SHOULD BE VERIFIED BY THE CONTRACTOR PRIOR TO THE PLACEMENT OF EPOXY. IN LIEU OF THE USE OF EPOXY FOR SILL ANCHOR SHEAR BOLTS ONLY, 5/8" dia. x(7" EMBED.) Titen HD SCREWS MAY BE USED; TITEN BOLTS SHALL BE HOT-DIPPED GALVANIZED and the TYPICAL 3/8"x1/4" HDG PLATE WASHERS SHALL BE USED.
 - AT EXISTING FOUNDATION CONDITIONS FOR EPOXY RETROFIT HOLD-DOWNS- SPECIAL INSPECTION IS MANDATORY DURING THE INSTALLATION, REFERENCE DETAILS or PLANS FOR INSTALLATION INFO.
 - ALL SIMPSON PRODUCTS ARE TO BE INSTALLED AS PER MANUFACTURER'S RECOMMENDATIONS.
 - A) LENGTH OF SHEAR WALL IS DEFINED AS THE EDGE OF PLYWOOD SHEET, AND THE MINIMUM SHEAR WALL LENGTH IS SPECIFIED ON THE PLANS.
 - PROVIDE E.N.=EDGE NAILING AT EACH PLYWOOD SHEET PERIMETER; AT CONDITIONS WHERE HOLD-DOWN OCCURS, E.N. TO BOTH THE HEADER BEARING STUD(S) AND TO THE FULL-HIT. POST RECEIVING THE HOLD-DOWN.

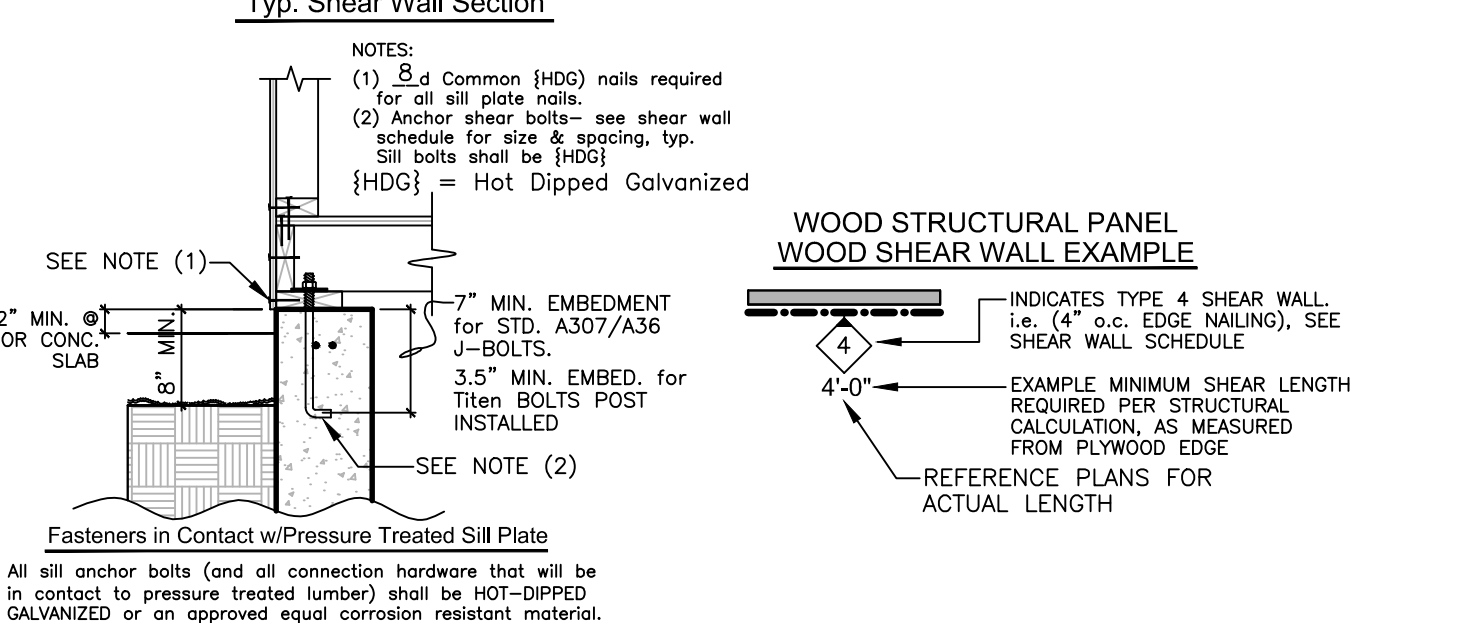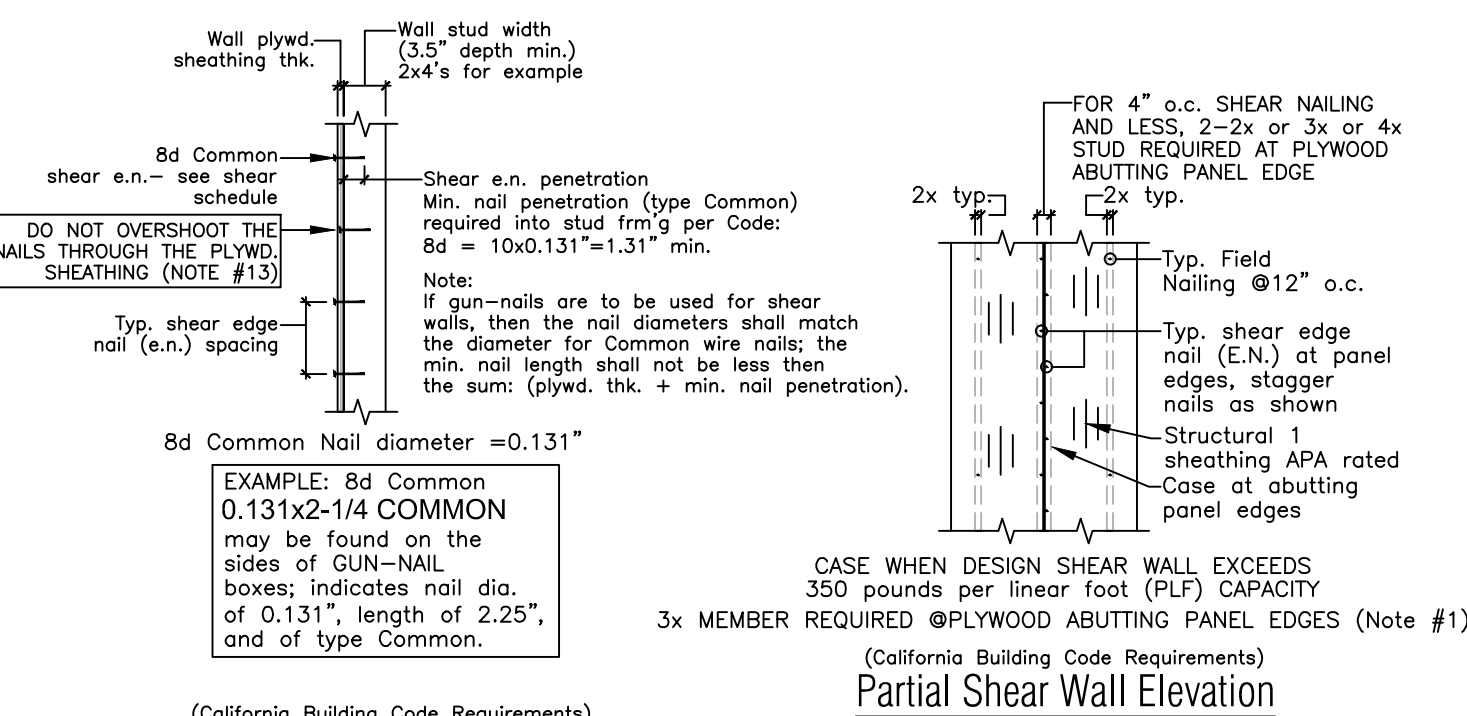

<<< Use 8d COMMON nails for shear wall nailing >>>
 <<< Use 8d COMMON HOT-DIPPED GALVANIZED nails for shear sill plate nailing >>>

SHEAR WALL SCHEDULE

- NOTES:
- HEADERS: SEE HEADER SCHEDULE SHEET SD.2, TYP. U.O.N. ON PLANS.
 - PROVIDE 2x SOLID BLOCKING BELOW ALL BEARING WALLS PERPENDICULAR TO JOISTS.
 - PROVIDE DBL. JOISTS BELOW ALL BEARING WALLS PARALLEL TO JOISTS.
 - SEE SHEET SD.1 FOR GENERAL NOTES & STRUCTURAL SPECIFICATIONS.
 - FIELD VERIFY ALL EXISTING DIMENSIONS IN FIELD PRIOR TO CONSTRUCTION. ANY SIGNIFICANT DISCREPANCIES, STOP CONSTRUCTION & NOTIFY ARCHITECT & ENGINEER IN WRITING.
 - SEE ARCHITECTURAL PLANS FOR DIMENSIONS.
 - ALL METAL ANCHORS, FASTENERS, CONNECTORS, ETC. THAT WILL BE IN CONTACT WITH PRESSURE TREATED LUMBER (OR EXPOSED TO WEATHER CONDITIONS) SHALL BE HOT-DIPPED GALVANIZED, SILICONE BRONZE, STAINLESS STEEL or COPPER.
 - ALL HARDWARE TO BE "SIMPSON" or EQUAL PRODUCT U.O.N. ON PLANS.


- AVOIDING TROUBLES & PROBLEMS NOTES:
- If a discrepancy arises between the drawings and field conditions, or where a detail is doubtful or interpretation or an unanticipated field condition is encountered, the engineer shall be immediately contacted for procedure to be followed. Such instructions shall be confirmed in writing and distributed to all affected parties, see "disclaimer" @right-side of sheet.
 - Wherever there is a conflict between details and specifications, or between details, or where doubtful of interpretation, the most restrictive shall govern as determined by the Engineer of Record.

PLYWOOD: Plywood sheathing (floor, & shear walls) shall not be less than 24" in either direction unless all edges of the undersized sheets are supported by and fastened to framing members or blocking. MIN. DIMENSION OF ROOF SHEATHING TO BE 24"

ROOF PLYWOOD SHEATHING
 Roof Sheathing: 15/32" DOC PS-1 or DOC PS-2 Sheathing, EXP 1 with 32/16 Span Rating, APA Rated Plywood or OSB, Use 10d nails: 0.148"x2-1/4" HDG Gun nail @6" o.c. at BOUNDARY & EDGES & 12" o.c. IN THE FIELD; unblocked @intermediate panel edges U.O.N. on plans.
 NOTE: FOR NEW PLYWOOD INSTALLED OVER EXISTING 1x SKIP-SHEATHING, USE 10dx3" COMMON NAILS w/MIN. 1.5" NAIL PENETRATION INTO FRM'G MEMBERS.

FLOOR PLYWOOD SHEATHING
 Floor Sheathing: 23/32" APA Rated DOC PS 1 or DOC PS 2 STURD-I -FLOOR sheathing; 48/24 SPAN RATING w/EXPOSURE 1 GLUE; USE 10d COMMON 0.148"x2-3/8" GALVANIZED RING SHANK NAILS @6" o.c. at BOUNDARY & EDGES & 12" o.c. IN THE FIELD; unblocked @ intermediate panel edges U.O.N. on plans.

SHEAR WALL PLYWOOD SHEATHING
 Shear wall plywood sheathing: MIN. 3/8" or 7/16" DOC PS-1 or PS-2 (APA or TECO Performance-Rated) Sheathing (or OSB), 24/0 SPAN RATING; Use 8d nails - 0.131" x2-1/4" HDG Gun nail; Reference shear wall schedule for shear wall type & notes.

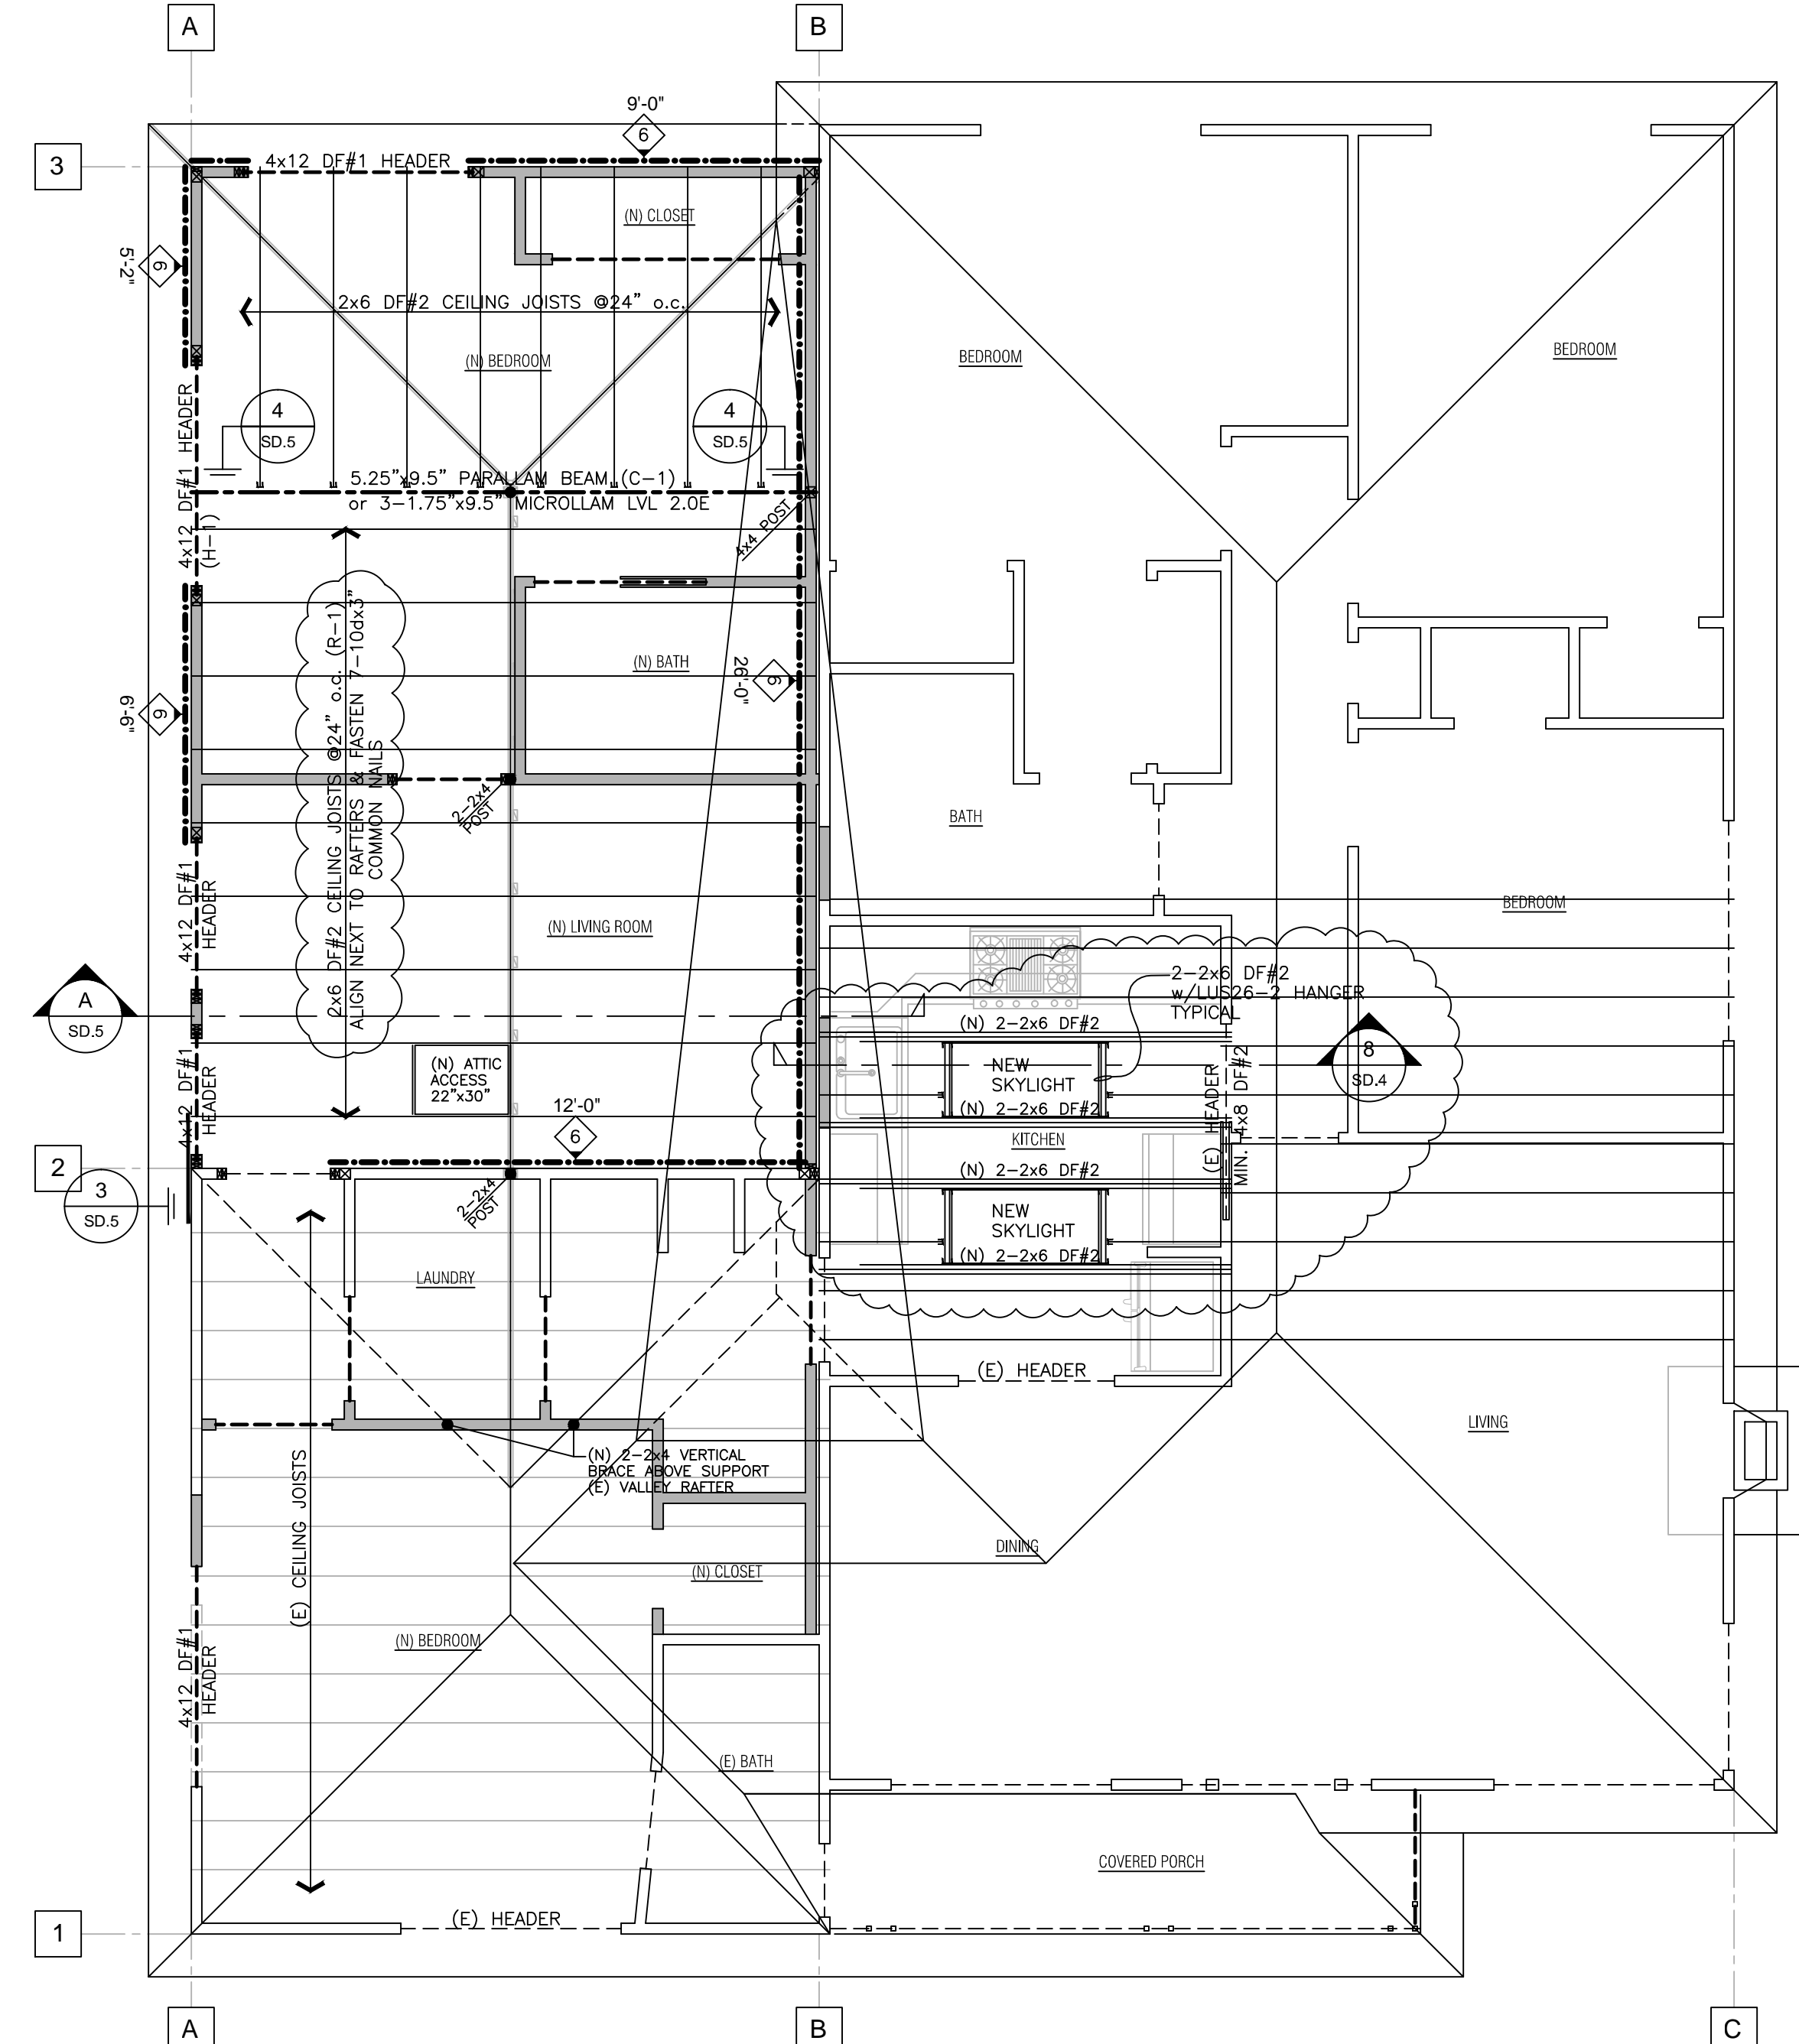


Ceiling Framing Plan



SCALE: 1/4"=1'-0"

DISCLAIMER: THIS PROJECT IS A REMODEL OR AN ADDITION TO AN EXISTING STRUCTURE. THEN THE FOLLOWING APPLIES: THE INVESTIGATION OF THE MEMBERS OF THE EXISTING STRUCTURE THAT ARE TO BE REUSED IN THE NEW STRUCTURAL SYSTEM IS NOT COVERED BY THIS DESIGN CONTRACT. SUCH MEMBERS ARE NOT EXPOSED AT THIS TIME. THEIR STRUCTURAL SOUNDNESS IS NOT KNOWN, SUCH AN INVESTIGATION SHOULD BE CONDUCTED BY AN ENGINEER (NOT INGRAM) IN WRITING. OUR OFFICE WILL BE DEVIATED FROM THE CITY APPROVED PLANS BASED ON THE HONOR SYSTEM BASED ON THE CURRENT WORK LOAD AT SUCH TIME. ANY STRUCTURAL FRAMING THAT IS TO BE DEVIATED FROM THE CITY APPROVED PLANS MUST BE APPROVED BY USE OF WRITTEN DOCUMENTATION STAMPED AND SIGNED BY USE PRIOR TO FURTHER CONSTRUCTION AT SUCH AREA OR AREAS AFFECTED BY SUCH REVISION. FAILURE TO NOTIFY THIS ENGINEER WILL RELEASE THIS ENGINEER OF ANY LIABILITY. BY ACCEPTING THIS WORK, BOTH THE OWNER AND THE CONTRACTOR CONFIRM THE ACCEPTANCE OF THEIR RESPONSIBILITIES, AS STATED HEREIN.

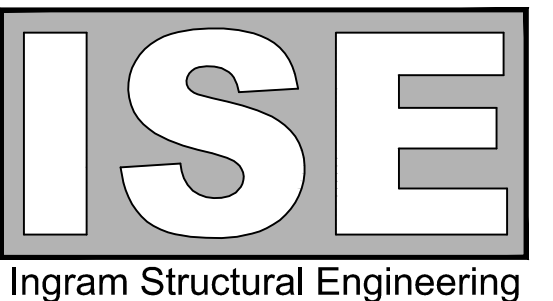

Jeff Ingram, P.E.
 CIVIL ENGINEER
 License No. C 66222
 2570 N. First Street, Suite 200
 San Jose, CA 95131
 (408) 836-6602 (Cell)
 (408) 836-6604 (Office)
 Email: jeff@ingram.com



JOB TITLE
 Vesa Residence
 684 N. Redwood Ave.
 San Jose, CA 95128

DATE ISSUE:
 3/2/2022
 PER BUILDING DEPARTMENT PLAN CHECK


1/9/2023

THESE STRUCTURAL DRAWINGS WERE PRODUCED BY ISE. THE USE OF THESE PLANS AND SPECIFICATIONS SHALL BE RESTRICTED TO THE ORIGINAL SITE FOR WHICH THEY WERE PREPARED, AND PUBLICATION THEREOF IS EXPRESSLY LIMITED TO SUCH USE. RE-USE, REPRODUCTION, OR PUBLICATION BY ANY METHOD, IN WHOLE OR IN PART, IS PROHIBITED. FURTHERMORE, TITLE TO THE PLANS AND SPECIFICATIONS REMAINS WITH ISE. VISUAL CONTACT WITH THESE PLANS AND SPECIFICATIONS CONSTITUTE PROOF OF ACCEPTANCE OF ALL RESTRICTIONS.
 Copyright © 2022 ISE Ingram Structural Engineering

PROJECT # 824 SCALE: 1/4"=1'-0"
 DRAWN BY: YI, JI
 PROJECT MANAGER: JI
 ENGINEERED BY: JI
 REVIEWED BY: JI

Ceiling Framing Plan

S2

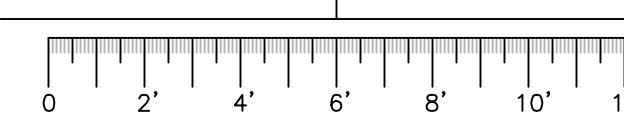


SHEAR WALL SCHEDULE (See Notes)				2x SILL P		per AWC SDPWS-15 Table 4.3A		USED IN CALCULATIONS	
SHEAR WALL TYPE	PLYWOOD or OSB SHEATHING (17)	EDGE NAILING (2,13) (14,15)	JOISTS or BLOCKS TO TOP PLATE	SOLE PLATE TO JOISTS or BLK'G	SILL BOLTS TO CONCRETE	NOMINAL UNIT SHEAR	ALLOWABLE UNIT SHEAR	ALLOWABLE UNIT SHEAR	
(SEE PLANS)	APA RATED CDX DOC PS 1 or PS 2	8d Common Nails (23)	SIMPSON ANCHOR (Note 1)	16d COMMON NAILS	3/4"Ø x 7" EMBED. (1,3,16,18)				
6	3/8" or 7/16" (12)	@6" o.c.	A35 at 24" o.c.	@10" o.c.	@4"-0" o.c. 2x SILL PLATE	520 lb/ft	260 lb/ft	260 lb/ft	
4	3/8" or 7/16" (12)	@4" o.c.	A35 at 16" o.c.	@7" o.c.	@3"-9" o.c. 2x SILL PLATE	760 lb/ft	380 lb/ft	380 lb/ft	
3	3/8" or 7/16" (12)	@3" o.c.	A35 at 12" o.c.	@5 1/2" o.c.	@3"-0" o.c. 2x SILL PLATE	980 lb/ft	490 lb/ft	490 lb/ft	
2	3/8" or 7/16" (12)	@2" o.c.	(2) A35 at 16" o.c.	@4" o.c.	@2"-3" o.c. 2x SILL PLATE	1280 lb/ft	640 lb/ft	640 lb/ft	
4	3/8" or 7/16" (12)	@4" o.c.	(SEE DETAILS)	(SEE DETAILS)	(SEE DETAILS)	1520 lb/ft	760 lb/ft	760 lb/ft	
3	3/8" or 7/16" (12)	@3" o.c.	(SEE DETAILS)	(SEE DETAILS)	(SEE DETAILS)	1960 lb/ft	980 lb/ft	980 lb/ft	

ALL FIELD NAILING SHALL BE 8d COMMON at 12" o.c.
 (1) AT ROOF SPACE SHEAR CLIP BETWEEN EACH RAFTER BAY @ 6" PITCH (MINIMUM EXTERIOR WALLS, U.O.N.) (2) SILL ANCHOR BOLTS SHALL BE HOT-DIPPED GALVANIZED

- NOTES:** (CONTRACTOR SHALL READ & UNDERSTAND THESE NOTES BEFORE CONSTRUCTION)
- In Seismic Design Category D, E, or F, (SEE NOTE #20 FOR SEISMIC DESIGN CATEGORY FOR THIS PROJECT) where shear design values exceed 350 pounds per linear foot, all framing members receiving edge nailing from ABUTTING PANELS shall not be less than a single 3-inch nominal member, USE 3x or 4x (DEPTH TO MATCH WALL FRAMING) MEMBER @ SHEAR ABUTTING PANEL EDGES.
 - Nails shall be 8d COMMON (0.131"x2-1/4" COMMON) with minimum 1.131-inch nail penetration into framing members or blocking.
 - Foundation sill plates shall be Pressure Treated Douglas-Fir Larch No. 2 or equal lumber; See shear schedule for sill plate size. All sill plates bolted to concrete with 5/8" diameter x12" bolts spaced not more than 4'-0" o.c., with a minimum of two bolts for each piece of sill plate. Anchor bolts shall have a 4.5" minimum and a 12" maximum clearance to the end of the sill plate, and 1" minimum embedment into concrete or masonry. Sill plate size & anchorage in Seismic Design Category D, E, or F: Plate washers shall be minimum 0.229" x 3" x 3" in size, between sill plate & nut. The hole in the plate washer is permitted to be diagonally slotted with a width of up to 3/16" larger than the base diameter and the slot length not to exceed 1-3/4", provided a standard cut washer is placed between the plate washer and the nut. Sill plates resisting a design load greater than 350 plf using ASD shall not be less than a 3-inch nominal member. See note (16) for exception.
 - Where panels applied on both faces of a wall AND nail spacing is less than 6" o.c. on either side, panel joints shall be offset to fall on different framing members, or framing shall be 3-inch nominal or thicker at adjoining panel edges and nails on each side shall be staggered.
 - All shear wall sheathing shall extend to the bottom of the roof sheathing U.O.N. by the structural details.
 - Provide stud or blocking at unsupported panel edge.
 - Extend shear sheathing over all openings for continuous shear support & uniform wall thickness.
 - Shear wall panels shall not be less than 24" in either direction; EXCEPTION: Shear plywood panel may be less than 24" provided that all edges of the undersized sheath are supported by and fastened to framing members or blocking.
 - Panel edges backed with 2-inch nominal or wider framing. Install panels either horizontally or vertically. Space fasteners maximum 12" o.c. on intermediate supports for studs spaced @16" o.c.
 - All posts receiving hold-downs shall have shear edge nailing full height.
 - Floor plywood shall be glued and fastened to the rim joist or blocking for the use of 16d COMMON shear wall bottom plate fasteners. Glue shall meet the requirements of the APA adhesive spec. AFG-DI, and shall be applied as per manufacturer's recommendations; glue may be applied manually or with pneumatic or electric equipment.
 - 15/32" plywood or OSB sheathing may be used in lieu of 3/8" or 7/16".
 - If gun nails (power driven fasteners) are used, then adjust the power such that the nail head does not penetrate the plywood sheathing. The head of shear wall nails shall not penetrate the plywood.
 - When ordering large quantities of nails, verify the carton label or with the manufacturer that the nails have the same length & diameter values as the nails specified in note #2.
 - Framing at adjoining panel edges shall be 3 inches nominal or wider, and nails shall be staggered.
 - VOID
 - Shear plywood sheathing shall be APA rated DOC PS-1 or PS-2 (APA or TECO Performance-Rated) or OSB SHEATHING, 24/0 SPAN RATING for 3/8" 3-ply sheathing, 32/16 span rating for 15/32" sheathing (5-ply or OSB). See plans for more information.
 - Sill plate and anchor bolt is designed as per 2018 NDS Table 12E. For 2x sill plate with 5/8" bolt, allowable shear parallel to grain is (930 lb x1.6)=1490 lb; for 3x sill plate & 5/8" bolt, allowable shear is (1180 lb x1.6)=1890 lb.
 - Plywood shear wall nominal unit shear data was obtained from AWS SDPWS-15 Table 4.3A. Allowable shear equals the nominal shear divided by 2.0 as per SDPWS Section 4.3.3. Allowable shears for 3/8" are permitted to be increased for 15/32" plywood with same nailing provided: (A) Stud spacing a maximum of 16" on center, or (B) if panels are applied with long dimension across studs. SDPWS-15 Table 4.3A footnote 2.
 - Seismic Design Category = D

- ADDITIONAL SHEAR WALL NOTES:**
- CONTRACTOR SHALL REVIEW ALL TYPICAL SHEAR WALL CONNECTION DETAILS & NOTES PRIOR TO CONSTRUCTION.
 - A) SAME AS NOTE #2 ABOVE.
 - B) HDG=HOT-DIPPED GALVANIZED NAILS SHALL BE USED FOR ALL SILL PLATE NAILING (i.e. TO P.T. LUMBER, TYP.)
 - A) ALL SHEAR WALL PLYWOOD NAILING EDGES SHALL BE FASTENED TO SOLID FRAMING MEMBERS OR BLOCKING.
 - SHEAR PLYWOOD SHALL BE FASTENED DIRECTLY TO THE STUDS, AND STUDS SHALL BE SPACED NOT MORE THAN 16" o.c.
 - DO NOT "OVER-NAIL" THE SHEAR WALL. SPACE NAILING IN ACCORDANCE TO THE SHEAR WALL SCHEDULE.
 - DO NOT "OVER-SHOOT" THE NAILS INTO THE PLYWOOD, THE HEAD OF THE NAILS SHOULD BE FLUSH WITH THE FACE OF PLYWOOD. IF POWER-DRIVEN NAILING IS DONE, RECOMMEND ADJUSTING THE POWER SUCH THAT THE HEAD OF THE NAILS DO NOT PENETRATE THROUGH THE PLYWOOD, AND THE USE OF A HAMMER TO FINISH OFF THE NAILING.
 - AT SHEAR WALL ABUTTING PANEL EDGES, RECOMMEND 4x (DEPTH TO MATCH WALL FRAMING) TO RECEIVE NAILING FROM EACH PLYWOOD SHEET. MINIMUM ONE 2x STUD IS ACCEPTABLE FOR TYPE 1 SHEAR WALL ONLY @ ABUTTING PANEL EDGES. FOR SHEAR WALL TYPES 2, 3, 4, ... ETC. 3x OR 4x MEMBER IS MANDATORY AT ABUTTING PANEL EDGES.
 - AT EXISTING FOUNDATION CONDITIONS FOR SILL "SHEAR" BOLTS: USE 5/8" diameter HDG ALL-THREAD x7" EMBEDMENT, DRILL & CLEAN-OUT HOLES WITH USE OF AIR. NOTE THAT SOME CITY BUILDING DEPARTMENTS MAY WANT SPECIAL INSPECTION DURING THIS PROCESS- THIS SHOULD BE VERIFIED BY THE CONTRACTOR PRIOR TO THE PLACEMENT OF EPOXY. IN LIEU OF THE USE OF EPOXY FOR SILL ANCHOR SHEAR BOLTS ONLY, 5/8" dia. x7" EMBED.) Titen HD SCREWS MAY BE USED; TITEN BOLTS SHALL BE HOT-DIPPED GALVANIZED and the TYPICAL 3"x4" HDG PLATE WASHERS SHALL BE USED.
 - AT EXISTING FOUNDATION CONDITIONS FOR EPOXY TIE-ROTT HOLD-DOWNS- SPECIAL INSPECTION IS MANDATORY DURING THE INSTALLATION, REFERENCE DETAILS OR PLANS FOR INSTALLATION INFO.
 - ALL SIMPSON PRODUCTS ARE TO BE INSTALLED AS PER MANUFACTURER'S RECOMMENDATIONS.
 - A) LENGTH OF SHEAR WALL IS DEFINED AS THE EDGE OF PLYWOOD SHEET, AND THE MINIMUM SHEAR WALL LENGTH IS SPECIFIED ON THE PLANS.
 B) PROVIDE E.N.=EDGE NAILING AT EACH PLYWOOD SHEET PERIMETER; AT CONDITIONS WHERE HOLD-DOWN OCCURS, E.N. TO BOTH THE HEADER BEARING STUD(S) AND TO THE FULL-HI. POST RECEIVING THE HOLD-DOWN.

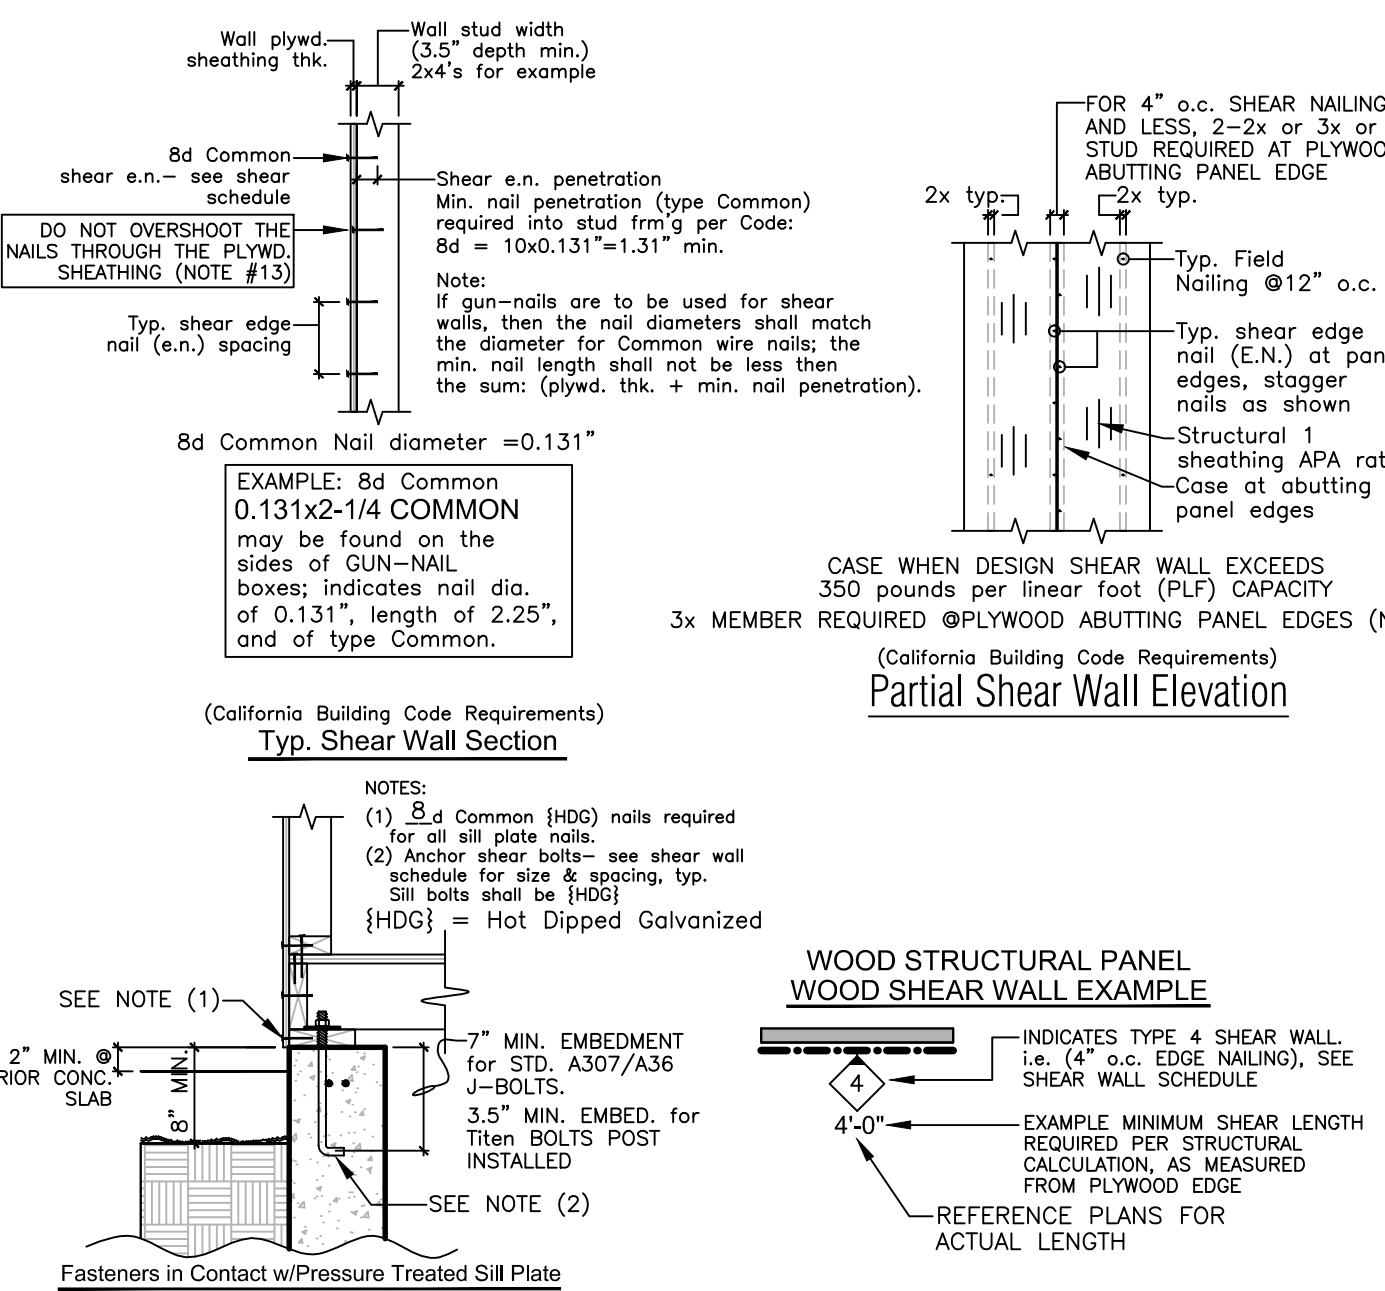

<<< Use 8d COMMON nails for shear wall nailing >>>
 <<< Use 8d COMMON HOT-DIPPED GALVANIZED nails for shear sill plate nailing >>>
SHEAR WALL SCHEDULE


- NOTES:**
- HEADERS: SEE HEADER SCHEDULE SHEET SD.2, TYP. U.O.N. ON PLANS.
 - PROVIDE 2x SOLID BLOCKING BELOW ALL BEARING WALLS PERPENDICULAR TO JOISTS.
 - PROVIDE DBL. JOISTS BELOW ALL BEARING WALLS PARALLEL TO JOISTS.
 - SEE SHEET SD.1 FOR GENERAL NOTES & STRUCTURAL SPECIFICATIONS.
 - FIELD VERIFY ALL EXISTING DIMENSIONS IN FIELD PRIOR TO CONSTRUCTION, ANY SIGNIFICANT DISCREPANCIES, STOP CONSTRUCTION & NOTIFY ARCHITECT & ENGINEER IN WRITING.
 - SEE ARCHITECTURAL PLANS FOR DIMENSIONS.
 - ALL METAL ANCHORS, FASTENERS, CONNECTORS, ETC. THAT WILL BE IN CONTACT WITH PRESSURE TREATED LUMBER (OR EXPOSED TO WEATHER CONDITIONS) SHALL BE HOT-DIPPED GALVANIZED, SILICONE BRONZE, STAINLESS STEEL OR COPPER.
 - ALL HARDWARE TO BE "SIMPSON" or EQUAL PRODUCT U.O.N. ON PLANS.

- AVOIDING TROUBLES & PROBLEMS NOTES:**
- If a discrepancy arises between the drawings and field conditions, or where a detail is doubtful of interpretation or an unanticipated field condition is encountered, the engineer shall be immediately contacted for procedure to be followed. Such instructions shall be confirmed in writing and distributed to all affected parties, see "disclaimer" @ right-side of sheet.
 - Wherever there is a conflict between details and specifications, or between details, or where doubtful of interpretation, the most restrictive shall govern as determined by the Engineer of Record.

PLYWOOD: Plywood sheathing (floor, & shear walls) shall not be less than 24" in either direction unless all edges of the undersized sheets are supported by and fastened to framing members or blocking.
 MIN. DIMENSION OF ROOF SHEATHING TO BE 24"

ROOF PLYWOOD SHEATHING
 Roof Sheathing: 15/32" DOC PS-1 or DOC PS-2 Sheathing, EXP 1 with 32/16 Span Rating, APA Rated Plywood or OSB, Use 10d nails: 0.148"x2-1/4" HDG Gun nail @6" o.c. at BOUNDARY & EDGES & 12" o.c. IN THE FIELD; unblocked @ intermediate panel edges U.O.N. on plans.
 NOTE: FOR NEW PLYWOOD INSTALLED OVER EXISTING 1x SKIP-SHEATHING, USE 10d x3" COMMON NAILS w/MIN. 1.5" NAIL PENETRATION INTO FRM'G MEMBERS.
 NOTE: CONTRACTOR TO VERIFY w/TITLE 24 ENERGY REPORT (if one such exists) IF "FOIL FACED SHEATHING" IS REQUIRED FOR ENERGY CONSERVATION, USE 1/2" EXT. GRADE Polatich Lumin® OSB Structural I FOIL FACED SHEATHING or EQUAL (FOIL FACE DOWN).

FLOOR PLYWOOD SHEATHING
 Floor Sheathing: 23/32" APA Rated DOC PS 1 or DOC PS 2 STURD-I -FLOOR sheathing; 48/24 SPAN RATING w/EXPOSURE 1 GLUE; USE 10d COMMON 0.148"x2-3/8" GALVANIZED RING SHANK NAILS @6" o.c. at BOUNDARY & EDGES & 12" o.c. IN THE FIELD; unblocked @ intermediate panel edges U.O.N. on plans.
SHEAR WALL PLYWOOD SHEATHING
 Shear wall plywood sheathing: MIN. 3/8" or 7/16" DOC PS-1 or PS-2 (APA or TECO Performance-Rated) Sheathing (or OSB), 24/0 SPAN RATING; Use 8d nails - 0.131" x2-1/4" HDG Gun nail; Reference shear wall schedule for shear wall type & notes.

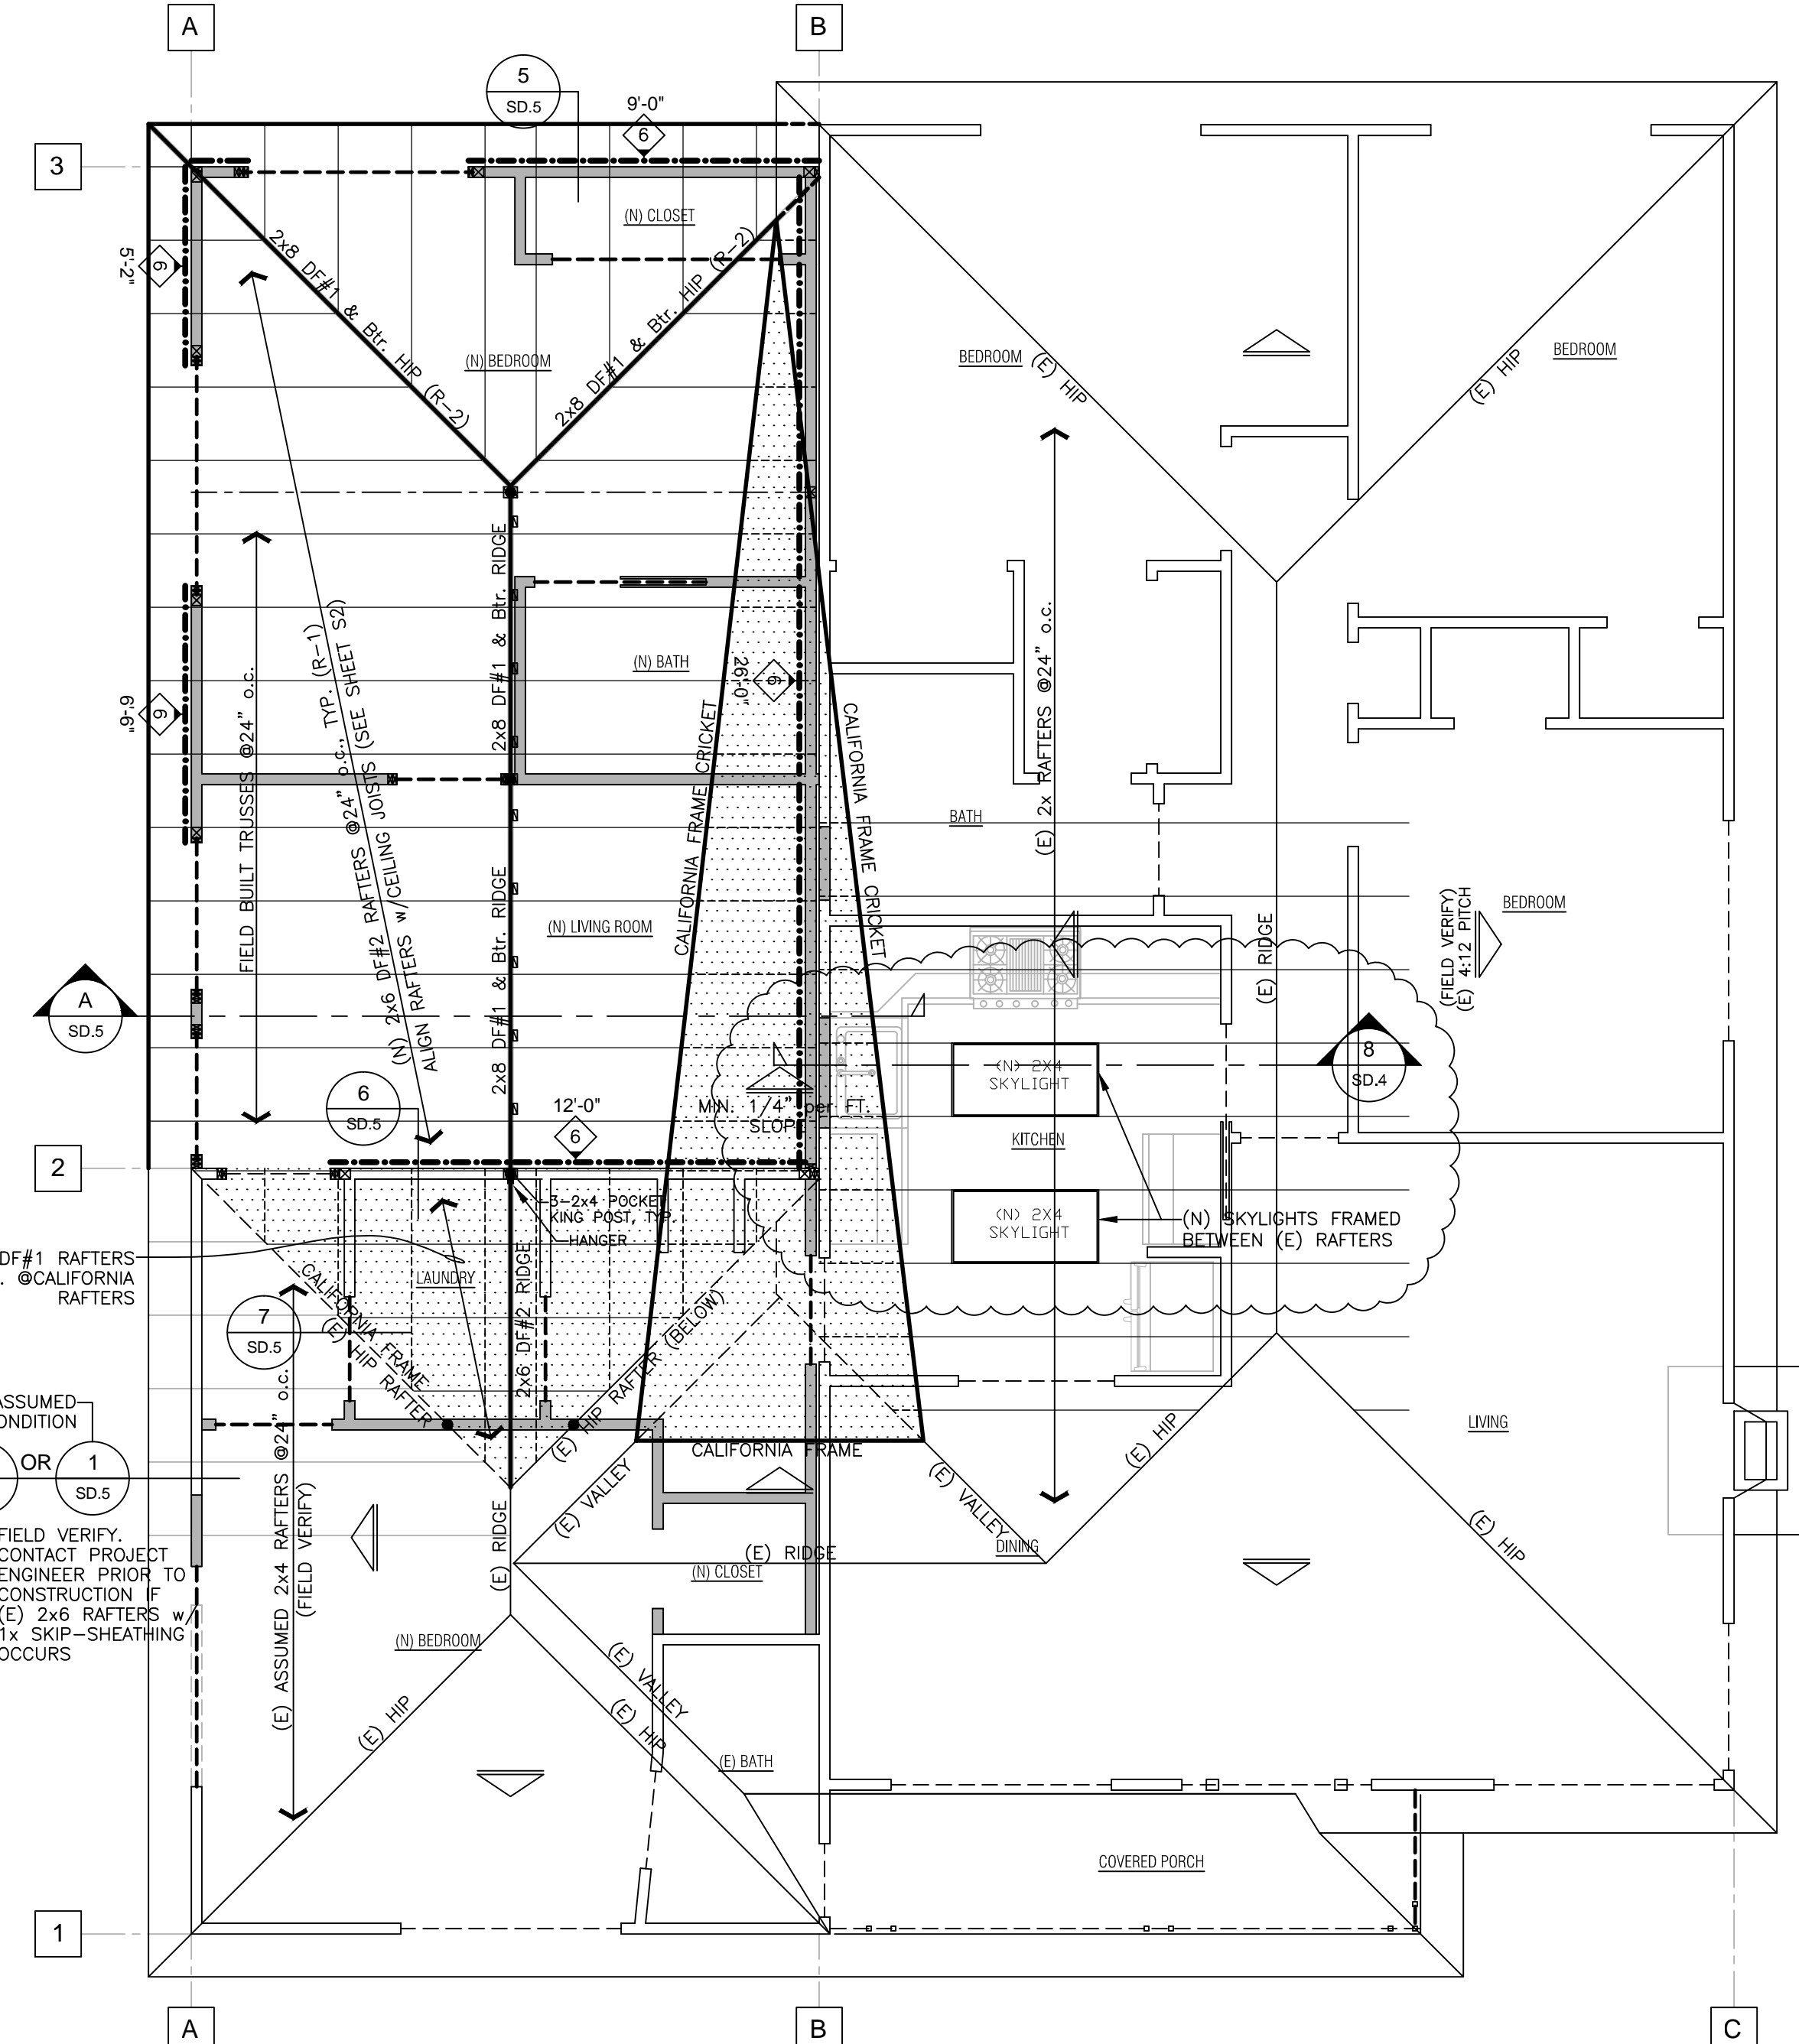

Roof Framing Plan
 NOTE: 1. This structure was engineered for Composition Roof Shingles installed weight not to exceed 4.0 psf (or 400 lb. per square max.).
 SCALE: 1/4"=1'-0"

ISE
 Ingram Structural Engineering

Jeff Ingram, P.E.
 CIVIL ENGINEER
 License No. C 66222
 2570 N. First Street, Suite 200
 San Jose, CA 95131
 (408) 836-6602 (Cell)
 (408) 836-6604 (Office)
 Email: jeff@ingramse.com



JOB TITLE
 Vesa Residence
 684 N. Redwood Ave.
 San Jose, CA 95128

DATE ISSUE:
 3/2/2022
 PER BUILDING DEPARTMENT PLAN CHECK
 1/9/2023

THESE STRUCTURAL DRAWINGS WERE PRODUCED BY ISE. THE USE OF THESE PLANS AND SPECIFICATIONS SHALL BE RESTRICTED TO THE ORIGINAL SITE FOR WHICH THEY WERE PREPARED, AND PUBLICATION THEREOF IS EXPRESSLY LIMITED TO SUCH USE. RE-USE, REPRODUCTION, OR PUBLICATION BY ANY METHOD, IN WHOLE OR IN PART, IS PROHIBITED. FURTHERMORE, TITLE TO THE PLANS AND SPECIFICATIONS REMAINS WITH ISE. VISUAL CONTACT WITH THESE PLANS AND SPECIFICATIONS CONSTITUTE PROOF OF ACCEPTANCE OF ALL RESTRICTIONS.
 Copyright © 2022 ISE Ingram Structural Engineering

PROJECT #: 824 SCALE: 1/4"=1'-0"
 DRAWN BY: YI, JI
 PROJECT MANAGER: JI
 ENGINEERED BY: JI
 REVIEWED BY: JI

Roof Framing Plan

S3

DISCLAIMER: THIS PROJECT IS A REVISION OF AN EXISTING STRUCTURE. THE INVESTIGATION OF THE MEMBERS OF THE EXISTING STRUCTURE THAT ARE TO BE REUSED IN THE NEW STRUCTURAL SYSTEM IS NOT COVERED BY THIS DESIGN CONTRACT. ENGINEERING SUCH MEMBERS ARE NOT EXPERTS AT THIS TIME. THEIR STRUCTURAL SOUNDNESS IS NOT KNOWN, SUCH AN INVESTIGATION SHOULD BE CONDUCTED BY ANOTHER ENGINEER. THE INVESTIGATION OF THE MEMBERS OF THE EXISTING STRUCTURE THAT ARE TO BE REUSED IN THE NEW STRUCTURAL SYSTEM IS NOT COVERED BY THIS DESIGN CONTRACT. ENGINEERING SUCH MEMBERS ARE NOT EXPERTS AT THIS TIME. THEIR STRUCTURAL SOUNDNESS IS NOT KNOWN, SUCH AN INVESTIGATION SHOULD BE CONDUCTED BY ANOTHER ENGINEER. THE INVESTIGATION OF THE MEMBERS OF THE EXISTING STRUCTURE THAT ARE TO BE REUSED IN THE NEW STRUCTURAL SYSTEM IS NOT COVERED BY THIS DESIGN CONTRACT. ENGINEERING SUCH MEMBERS ARE NOT EXPERTS AT THIS TIME. THEIR STRUCTURAL SOUNDNESS IS NOT KNOWN, SUCH AN INVESTIGATION SHOULD BE CONDUCTED BY ANOTHER ENGINEER.

GENERAL NOTES

—THE FOLLOWING SPECIFICATIONS SHALL CONFORM TO THE 2019 CALIFORNIA BUILDING CODE AND ANY OTHER CITY ORDINANCES WHICH ARE IN FORCE AT THE TIME OF THIS PROJECT.

—CONTRACTOR SHALL VERIFY ALL DIMENSIONS, ELEVATIONS, AND CONDITIONS PRIOR TO STARTING ANY FIELD WORK.

—ANY DEVIATION CALLED BY THE FIELD CONDITIONS, OR ANY CONDITIONS DIFFERENT FROM THOSE INDICATED ON PLANS SHALL BE BROUGHT TO THE ENGINEER'S ATTENTION. ANY DISCREPANCY NOT REPORTED TO THE ENGINEER, WILL ABSOLVE THE ENGINEER FROM ANY LIABILITY.

—TYPICAL DETAILS SHALL APPLY WHERE NO SPECIFIC DETAILS OR SECTIONS ARE PROVIDED.

—DIMENSIONS SHOWN ON PLANS OR DETAILS TAKE PRECEDENCE OVER SCALES SHOWN.

—THE CONTRACTOR SHALL BE RESPONSIBLE FOR THE SATISFACTORY COMPLETION OF ALL WORK IN ACCORDANCE WITH THE PROJECT PLANS AND SPECIFICATIONS.

—THE CONTRACTOR SHALL PROVIDE ADEQUATE FLASHING AND WATERPROOFING TO PREVENT ANY ROOF AND/OR BALCONY RAIN WATER SEEPAGE.

—IF TRUSSES ARE TO BE USED IN LIEU OF CONVENTIONAL FRAMING, SHOP DRAWINGS AND CALCULATIONS SHALL BE PROVIDED TO THE CITY FOR APPROVAL BEFORE FABRICATION.

—IF AN ALTERNATE SHEAR WALL TIEDOWN SYSTEM IS TO BE USED IN LIEU OF SIMPSON HOLDOWNS, SHOP DRAWINGS AND CALCULATIONS SHALL BE PROVIDED TO THE CITY FOR APPROVAL BEFORE FABRICATION.

STRUCTURAL STEEL

—STRUCTURAL STEEL SHALL CONFORM TO A.S.T.M. (A-36) SPECIFICATIONS AND TO THE A.I.S.C. SPECIFICATIONS FOR FABRICATION AND ERECTION.

—ALL BOLTS SHALL CONFORM TO A.S.T.M. (A-307) FOR UNFINISHED BOLTS.

—ALL BOLT HOLES IN STEEL MEMBERS SHALL BE TRUE, BURNING OF HOLES FOR CONNECTIONS WILL NOT BE PERMITTED.

—PROVIDE FULL BEARING ON UNTHREADED PORTION OF BOLT SHANK FOR ALL STEEL CONNECTIONS.

—PROVIDE LEVELING NUTS FOR ALL BOLTS AT BEAM SEATS AND COLUMN BASE PLATES.

—ALL NUTS FOR STRUCTURAL STEEL CONNECTIONS SHALL BE HEAVY HEXAGONAL NUTS.

—ALL WELDING SHALL BE AS INDICATED ON THE DETAILS AND PERFORMED BY A QUALIFIED SHOP UNDER CONTINUOUS INSPECTION PER CBC 1704. FIELD WELDING, OTHER THAN MISCELLANEOUS TACK WELDING, IS NOT PERMITTED, UNLESS NOTED OTHERWISE IN THE DETAILS. THE FABRICATION SHOP SHALL BE "REGISTERED & APPROVED BY THE CITY BUILDING DEPARTMENT".

LUMBER

—WOOD MEMBERS LESS THAN 5" IN WIDTH SHALL BE DOUGLAS FIR NO. 2 AND 5" OR WIDER SHALL BE DOUGLAS FIR NO.1, UNLESS NOTED OTHERWISE ON PLANS.

—UNLESS NOTED OTHERWISE ON PLANS, ALL NAILING SHALL BE PER 2019 CALIFORNIA BUILDING CODE, TABLE 2304.10.1

—ALL CONNECTING HARDWARE SHALL BE SIMPSON COMPANY TYPE OR EQUAL, AND INSTALLATION SHALL BE IN ACCORDANCE WITH MANUFACTURER'S RECOMMENDATIONS UNLESS NOTED OTHERWISE ON PLANS.

—GLUED LAMINATED TIMBER BEAMS SHALL HAVE A MINIMUM BENDING STRESS OF 2400 psi. PROVIDE STANDARD CAMBER UNLESS NOTED OTHERWISE ON PLANS.

—ROOF PLYWOOD SHEATHING SHALL BE MINIMUM 1/2" APA RATED CDX WITH EXTERIOR GLUE, GROUP 2. EXPOSED SHEATHING AT ROOF OVERHANG SHALL BE AS INDICATED ON THE ARCHITECTURAL PLANS.

—WALL PLYWOOD SHEATHING, IF REQUIRED, SHALL BE MINIMUM 3/8" APA RATED CDX WITH EXTERIOR GLUE, GROUP 2, U.O.N. ON PLANS.

—FLOOR PLYWOOD SHEATHING SHALL BE T&G INT-APA WITH EXTERIOR GLUE, GROUP 2. SEE PLANS FOR SIZE.

—BEARING AND NONBEARING WALLS SHALL HAVE DOUBLE TOP PLATES, LAPPED AT INTERSECTIONS. PLATE JOISTS SHALL BE STAGGERED 4'-0" MINIMUM AS INDICATED ON THE STRUCTURAL DETAILS.

—UNLESS NOTED OTHERWISE ON PLANS, WALLS SHALL BE OF 2x4 STUDS (STUD GRADE OR GREATER) SPACED AT 16" ON CENTER.

—ALL HEADERS ARE AS NOTED ON PLANS.

—ALL WOOD BEARING ON CONCRETE OR MASONRY SHALL BE PRESSURE TREATED DOUGLAS FIR OR LARCH EXCEPT: POST BRACING ON PILES MAY BE DOUGLAS FIR OR LARCH PROVIDED THAT A PROPER BASE CAP AND MIN. 6" ABOVE SOIL ARE PROVIDED.

—HOLES FOR BOLTS SHALL BE DRILLED WITH A BIT 1/16" LARGER THAN THE NOMINAL BOLT HOLE DIAMETER. FLAT WASHERS SHALL BE PROVIDED AT ALL HEADS AND NUTS WHICH WOULD OTHERWISE BARE DIRECTLY ON WOOD. ALL BOLTS SHALL BE TIGHTENED TO A SNUG CONDITION, AND RETIGHTENED UPON JOB COMPLETION.

—STRUCTURAL MEMBERS (BEAMS, SHEAR WALL PLATES, OR POSTS USED AT HOLDOWNS) SHALL NOT BE CUT FOR PIPES, ECT., UNLESS SPECIFICALLY NOTED OR DETAILED.

—2x SOLID BLOCKING SHALL BE PLACED BETWEEN JOISTS OR RAFTERS AT ALL SUPPORTS.

CONCRETE

—CONCRETE SHALL HAVE A MINIMUM COMPRESSIVE STRENGTH OF 2500 psi AT 28 DAYS.

—AGGREGATES SHALL BE NATURAL SAND & ROCK CONFORMING TO ASTM C33 (WITH MAXIMUM AGGREGATE SIZE OF 3/4")

—MAXIMUM SLUMP SHALL BE 4"

—CEMENT SHALL BE PORTLAND CEMENT CONFORMING TO ASTM C-150, TYPE II. MINIMUM CEMENT CONTENT SHALL BE 5 SACKS PER CUBIC YARD FOR 2500 psi CONCRETE.

—ANCHOR BOLTS, HOLDOWN BOLTS, DOWELS, AND OTHER REQUIRED INSERTS, ETC., SHALL BE POSITIONED AND FIRMLY SECURED IN PLACE BEFORE CONCRETE IS PLACED.

—CONTRACTOR SHALL TAKE ALL THE NECESSARY MEASURES TO PROVIDE A PROPER COMPACTION OF THE CONCRETE.

—MIX REINFORCEMENT COVER FOR CAST-IN-PLACE CONCRETE:

1. CONCRETE CAST AGAINST & PERMANENTLY EXPOSED TO EARTH.....3"

2. CONCRETE FORMED BELOW GRADE OR EXPOSED TO WEATHER
No. 6 BARS & GREATER.....3"

No. 6 BARS & SMALLER.....1.5"

3. CONCRETE NOT EXPOSED TO WEATHER OR IN CONTACT WITH EARTH:
SLABS, WALLS, AND JOISTS: NO. 11 BARS & SMALLER.....1.5"

BEAMS & COL. PRIMARY REINFORCEMENT, TIES, STRIPPUS, SPIRALS.....1.5"

REINFORCING STEEL

—REINFORCING STEEL SHALL BE DEFORMED BARS, CONFORMING TO ASTM A615-40 REQUIREMENTS AND WELDED WIRE MESH PER ASTM SPECIFICATION A-185.

—BARS NO. 4 AND SMALLER SHALL BE OF GRADE 40, AND BARS NO. 5 AND GREATER SHALL BE OF GRADE 60. LAP BARS 48 DIAMETERS AT SPICES.

—ALL REINFORCING BARS SHALL BE CLEAN OF ANY RUST OR FOREIGN MATERIALS.

—CONCRETE COVER FOR REINFORCEMENT SHALL BE:

a) 3" WHERE POURED AGAINST FORMS

b) 2" WHERE POURED AGAINST FORMS

c) 1" FOR SLABS POURED AGAINST FORMS

—SEAL PLANS FOR QUANTITY AND LOCATION OF ANCHOR BOLTS. LOCATE BOLTS WITHIN 12" FROM CORNERS AND BUTT JOINTS.

CONCRETE MASONRY

—ALL MASONRY WORK SHALL BE REINFORCED GROUTED MASONRY AND CONFORM TO THE 2019 CALIFORNIA BUILDING CODE AND SHALL BE 8x8x16 LIGHTWEIGHT UNITS WITH MAXIMUM LINEAR SHRINKAGE OF 0.05%, PER A.S.T.M. (C-9-52), GRADE A. NO CONTINUOUS INSPECTION REQUIRED.

—MOTAR MIX SHALL BE COMPOSED OF ONE PART PORTLAND CEMENT TO NOT MORE THAN THREE PARTS SAND. GROUT MIX SHALL BE COMPOSED OF ONE PART PORTLAND CEMENT TO NOT MORE THAN THREE PARTS SAND AND NOT LESS THAN TWO PARTS PEA GRAVEL.

—WALLS TO BE GROUTED IN 4" MAXIMUM LIFTS, UNLESS HIGH LIFT GROUT PROCEDURES (WITH BLOCKOUTS) ARE USED. ALL REINFORCING SHALL HAVE A MINIMUM COVERAGE OF 1/2" OF GROUT. ALL BOLTS SHALL HAVE A MINIMUM COVERAGE OF 1" OF GROUT.

—NO PIPES OR DUCTS SHALL BE PLACED IN MASONRY WALLS UNLESS SPECIFICALLY NOTED OR DETAILED.

—DOWELS IN CONCRETE FOR MASONRY WALLS SHALL BE 2-#4 OR AS INDICATED ON THE DETAILS.

—ALL RETAINING BLOCK WALLS SHALL BE PROVIDED WITH AN APPROVED MOISTURE BARRIER ON THE SOIL SIDE. SEE ARCHITECT'S DRAWINGS.

—REFERENCE FOUNDATION FOR ADDITIONAL MASONRY NOTES & SPECIFICATIONS AS/IF CMU MASONRY IS APPLICABLE FOR THIS JOB.

LOADING

SEISMIC DESIGN:

DATA OBTAINED FROM: https://hazards.atccouncil.org

DESCRIPTION	DATA
SEISMIC FORCE RESISTING SYSTEM	Light-framed walls sheathed with wood structural panels rated for shear resistance
RESPONSE MODIFICATION FACTOR	R = 6.5
RISK CATEGORY	II
IMPORTANCE FACTOR	I_p = 1.0
SITE CLASS	D
LATITUDE	37.3285542 °N
LONGITUDE	-121.9459334 °W
MAPPED SPECTRAL RESPONSE ACCELERATION-SHORT PERIOD	S_s = 1.5 g
MAPPED SPECTRAL RESPONSE ACCELERATION-1sec. PERIOD	S₁ = 0.6 g
SHORT-PERIOD SITE COEFFICIENT	F_s = 1.2
LONG PERIOD SITE COEFFICIENT	F_v = --
DESIGN SPECTRAL RESPONSE ACCELERATION-SHORT PERIOD	S_{DS} = 1.2 g
DESIGN SPECTRAL RESPONSE ACCELERATION-1sec.	S_{DI} = --
SEISMIC DESIGN CATEGORY	D
SEISMIC FORCE AMPLIFICATION FACTOR	Ω = 2.5
SEISMIC RESPONSE COEFFICIENT	C_v = 0.185
DESIGN BASE SHEAR	V_e = 10.9 Kips
---	---
ANALYSIS PROCEDURE USED	Equivalent Lateral Force Procedure ASCE7-16, Section 12.8

WIND DESIGN:

DESCRIPTION	DATA
BASIC WIND SPEED	95 mph ZONE
EXPOSURE	B
RISK CATEGORY	II

GRAVITY LOADING:

LEVEL	D.L. (psf)	L.L. (psf)
ROOF	10	20
CEILING	6	10
2nd FLOOR	N.A.	N.A.
DECKS	N.A.	N.A.
1st FLOOR	10	40

SPREAD FOOTING DESIGN DATA: NO SOIL REPORT PROVIDED

SOIL	q (psf)	SOIL BEARING
D-4	1500	
ALL LOAD	1995	

EXISTING CONDITIONS

THE CONTRACTOR OR SUBCONTRACTOR SHALL FIELD VERIFY ALL EXISTING CONDITIONS PRIOR TO BEGINNING CONSTRUCTION AND/OR ORDERING MATERIAL. ANY DISCREPANCIES DISCOVERED SHALL BE BROUGHT TO THE ATTENTION OF THE ENGINEER IMMEDIATELY.

IF THIS PROJECT IS A REMODEL OR AN ADDITION TO AN EXISTING STRUCTURE, THEN THE FOLLOWING APPLIES. THE INVESTIGATION OF THE MEMBERS OF THE EXISTING STRUCTURE THAT ARE TO BE REPLACED IN THE NEW STRUCTURAL SYSTEM IS NOT COVERED BY THIS DESIGN CONTRACT. SINCE SUCH MEMBERS ARE NOT EXPOSED AT THIS TIME, THEIR STRUCTURAL SOUNDNESS IS NOT KNOWN. SUCH AN INVESTIGATION MAY TAKE PLACE AFTER THE COMPLETION OF THE CONSTRUCTION PROCESS. AT THE TIME THE FRAMING WILL BE EXPOSED, THE OWNER, WITH HIS CONTRACTOR, HAVE THE RESPONSIBILITY TO CONDUCT SUCH AN INVESTIGATION. SHOULD ANY DISCREPANCY BETWEEN THE SPECIFIED DESIGN ASSUMPTIONS FOR THESE STRUCTURAL MEMBERS AND THE ACTUAL CONDITIONS ARISE, THE OWNER AND HIS CONTRACTOR SHOULD NOTIFY THIS ENGINEER (Jeff Ingram) IN WRITING. OUR OFFICE WILL THEN RECOMMEND THE APPROPRIATE SOLUTIONS. THE WORK WILL BE ADDRESSED IN A TIMELY FASHION BASED ON THE HONOR SYSTEM GIVEN THE CURRENT WORK LOAD AT SUCH TIME. ANY STRUCTURAL FRAMING THAT IS TO BE DEVIATED FROM THE CITY APPROVED PLANS MUST BE APPROVED BY THE CITY ENGINEER. THE CONTRACTOR SHALL BE RESPONSIBLE TO NOTIFY THIS ENGINEER WITH WRITTEN DOCUMENTATION STAMPED AND SIGNED BY USE PRIOR TO FURTHER CONSTRUCTION AT SUCH AREA OR AREAS AFFECTED BY SUCH REVISION. FAILURE TO NOTIFY THIS ENGINEER WILL RELEASE THIS ENGINEER OF ANY LIABILITY, BY ACCEPTING THIS WORK, BOTH THE OWNER AND THE CONTRACTOR CONFIRM THE ACCEPTANCE OF THEIR RESPONSIBILITIES, AS STATED HEREIN.

CONSTRUCTION LIABILITY
CONSTRUCTION CONTRACTOR AND HIS SUBCONTRACTORS AGREE THAT IN ACCORDANCE WITH GENERALLY ACCEPTED CONSTRUCTION PRACTICES, THE CONSTRUCTION CONTRACTOR AND HIS SUBCONTRACTORS WILL BE RESPONSIBLE TO ASSUME SOLE AND COMPLETE RESPONSIBILITY FOR JOB SITE CONDITIONS DURING THE COURSE OF THE CONSTRUCTION OF THE PROJECT, INCLUDING THE SAFETY OF ALL PERSONS AND PROPERTY; THAT THIS REQUIREMENT SHALL BE MADE TO APPLY CONTINUOUSLY AND NOT LIMITED TO NORMAL WORKING HOURS, AND CONSTRUCTION CONTRACTOR AND HIS SUBCONTRACTORS FURTHER AGREE TO DEFEND, INDEMNIFY AND HOLD DESIGN PROFESSIONAL HARMLESS FROM ANY AND ALL LIABILITY, REAL OR ALLEGED, IN CONNECTION WITH THE PERFORMANCE OF WORK ON THIS PROJECT.

NOTIFICATION TO ENGINEER FOR CHANGES OR SUBSTITUTIONS:
DO NOT DEVIATE FROM THE STRUCTURAL PLANS, IF IN THE EVENT ANY STRUCTURAL OR STRUCTURAL FRAMING IS TO BE REVISED OR IGNORED, OR ALTERNATE FRAMING OF SUBSTITUTIONS OR CONNECTIONS OR WHATEVER IN LIEU OF WHAT IS SPECIFIED ON THE STRUCTURAL PLANS AND DETAILS, THEN THE OWNER AND HIS/HER CONTRACTOR SHALL NOTIFY THIS PROJECT ENGINEER (Jeff Ingram) IN WRITING BEFORE CONSTRUCTION, AND SUCH REVISION IS CONSIDERED A CHANGE ORDER. A PHONE CALL OR PHONE MESSAGE TO THE PROJECT ENGINEER OF RECORD IS NOT OFFICIAL NOTIFICATION. ALL CHANGE ORDERS SHALL FIRST BE APPROVED BY THE OWNER, AND THEN DOCUMENTED IN WRITING AND AGREED UPON BY THE PROJECT ENGINEER (Jeff Ingram) AND ALL RESPONSIBLE PARTIES BEFORE ANY CHANGE ORDER IS VALID. FAILURE TO PROPERLY NOTIFY THIS ENGINEER WILL RELEASE THIS ENGINEER FROM ANY LIABILITY. BY ACCEPTING THIS WORK, BOTH THE OWNER AND CONTRACTOR CONFIRM THE ACCEPTANCE OF THEIR RESPONSIBILITIES AS STATED HEREIN.

REINFORCING STEEL
—REINFORCING STEEL SHALL BE DEFORMED BARS, CONFORMING TO ASTM A615-40 REQUIREMENTS AND WELDED WIRE MESH PER ASTM SPECIFICATION A-185.
—BARS NO. 4 AND SMALLER SHALL BE OF GRADE 40, AND BARS NO. 5 AND GREATER SHALL BE OF GRADE 60. LAP BARS 48 DIAMETERS AT SPICES.
—ALL REINFORCING BARS SHALL BE CLEAN OF ANY RUST OR FOREIGN MATERIALS.
—CONCRETE COVER FOR REINFORCEMENT SHALL BE:
a) 3" WHERE POURED AGAINST FORMS
b) 2" WHERE POURED AGAINST FORMS
c) 1" FOR SLABS POURED AGAINST FORMS
—SEAL PLANS FOR QUANTITY AND LOCATION OF ANCHOR BOLTS. LOCATE BOLTS WITHIN 12" FROM CORNERS AND BUTT JOINTS.

CONCRETE MASONRY
—ALL MASONRY WORK SHALL BE REINFORCED GROUTED MASONRY AND CONFORM TO THE 2019 CALIFORNIA BUILDING CODE AND SHALL BE 8x8x16 LIGHTWEIGHT UNITS WITH MAXIMUM LINEAR SHRINKAGE OF 0.05%, PER A.S.T.M. (C-9-52), GRADE A. NO CONTINUOUS INSPECTION REQUIRED.
—MOTAR MIX SHALL BE COMPOSED OF ONE PART PORTLAND CEMENT TO NOT MORE THAN THREE PARTS SAND. GROUT MIX SHALL BE COMPOSED OF ONE PART PORTLAND CEMENT TO NOT MORE THAN THREE PARTS SAND AND NOT LESS THAN TWO PARTS PEA GRAVEL.
—WALLS TO BE GROUTED IN 4" MAXIMUM LIFTS, UNLESS HIGH LIFT GROUT PROCEDURES (WITH BLOCKOUTS) ARE USED. ALL REINFORCING SHALL HAVE A MINIMUM COVERAGE OF 1/2" OF GROUT. ALL BOLTS SHALL HAVE A MINIMUM COVERAGE OF 1" OF GROUT.
—NO PIPES OR DUCTS SHALL BE PLACED IN MASONRY WALLS UNLESS SPECIFICALLY NOTED OR DETAILED.
—DOWELS IN CONCRETE FOR MASONRY WALLS SHALL BE 2-#4 OR AS INDICATED ON THE DETAILS.
—ALL RETAINING BLOCK WALLS SHALL BE PROVIDED WITH AN APPROVED MOISTURE BARRIER ON THE SOIL SIDE. SEE ARCHITECT'S DRAWINGS.
—REFERENCE FOUNDATION FOR ADDITIONAL MASONRY NOTES & SPECIFICATIONS AS/IF CMU MASONRY IS APPLICABLE FOR THIS JOB.

STRUCTURAL SPECIFICATIONS

PLYWOOD:

Plywood sheathing (floor, & shear walls) shall not be less than 24" in either direction unless all edges of the undersheet are supported by and fastened to framing members or blocking.

MIN. DIMENSION OF ROOF SHEATHING TO BE 24"

ROOF PLYWOOD SHEATHING



Ingram Structural Engineering

Jeff Ingram, P.E.
 CIVIL ENGINEER
 License No. C 66222
 2570 N. First Street, Suite 200
 San Jose, CA 95131
 (408) 836-6602 (Cell)
 (408) 836-6604 (Office)
 Email: jeff@ingramse.com



JOB TITLE
 Vesa Residence
 684 N. Redwood Ave.
 San Jose, CA 95128


DATE ISSUE:
 7/6/2022
 1/9/2023 PER BUILDING DEPARTMENT PLAN CHECK

THESE STRUCTURAL DRAWINGS WERE PRODUCED BY ISE. THE USE OF THESE PLANS AND SPECIFICATIONS SHALL BE RESTRICTED TO THE ORIGINAL SITE FOR WHICH THEY WERE PREPARED, AND PUBLICATION THEREOF IS EXPRESSLY LIMITED TO SUCH USE. RE-USE, REPRODUCTION, OR PUBLICATION BY ANY METHOD, IN WHOLE OR IN PART, IS PROHIBITED. FURTHERMORE, TITLE TO THE PLANS AND SPECIFICATIONS REMAINS WITH ISE. VISUAL CONTACT WITH THESE PLANS AND SPECIFICATIONS CONSTITUTE PROOF OF ACCEPTANCE OF ALL RESTRICTIONS.
 Copyright © 2022 ISE Ingram Structural Engineering

PROJECT #: 824 SCALE: 1/4"=1'-0"
 DRAWN BY: YI, JI
 PROJECT MANAGER: JI
 ENGINEERED BY: JI
 REVIEWED BY: JI

Typical Details





SD.2

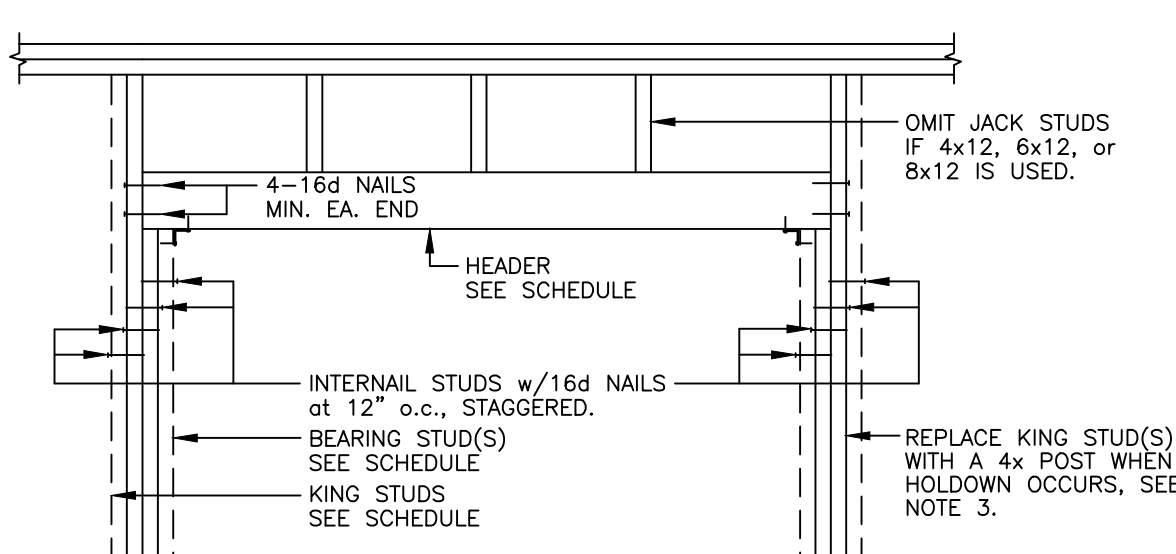


HEADER SCHEDULE

WIDTH OF OPENING	STUD WIDTH	NO. BEARING STUDS REQ'D	NO. KING STUDS REQ'D
3'-0" MAX.	4x6	2x8	1
5'-0" MAX.	4x8	6x8	1
7'-0" MAX.	4x10	6x10	2
10'-0" MAX.	4x12	6x10	2

- NOTES:**
- AT EXTERIOR AND INTERIOR WALLS, A 4x12 DF#2 HEADER MAY BE USED IN LIEU OF THE HEADERS NOTED IN THE TABLE. OMIT JACK STUDS IF 4x12 IS USED, TYPICAL.
 - HEADERS NOTED IN THE TABLE SHALL BE PROVIDED OVER ALL WINDOWS, DOORS, AND OTHER OPENINGS UNLESS OTHERWISE NOTED ON PLANS.
 - WHEN HOLDOWN BETWEEN FLOORS OR AT FOUNDATION OCCURS, REPLACE 2x KING STUD(S) WITH A 4x POST- DEPTH TO MATCH STUDS. THE A35 CLIP MAY BE NEGLECTED AT THE FOUNDATION LEVEL WHEN HOLDOWN IS USED.
 - FOR HEADERS SUPPORTING ROOF OR FLOOR ONLY, ONE BEARING STUD MAY BE USED IN LIEU OF TWO UNLESS OTHERWISE NOTED ON PLANS. FOR HEADERS SUPPORTING BEAMS, USE TWO BEARING STUDS.

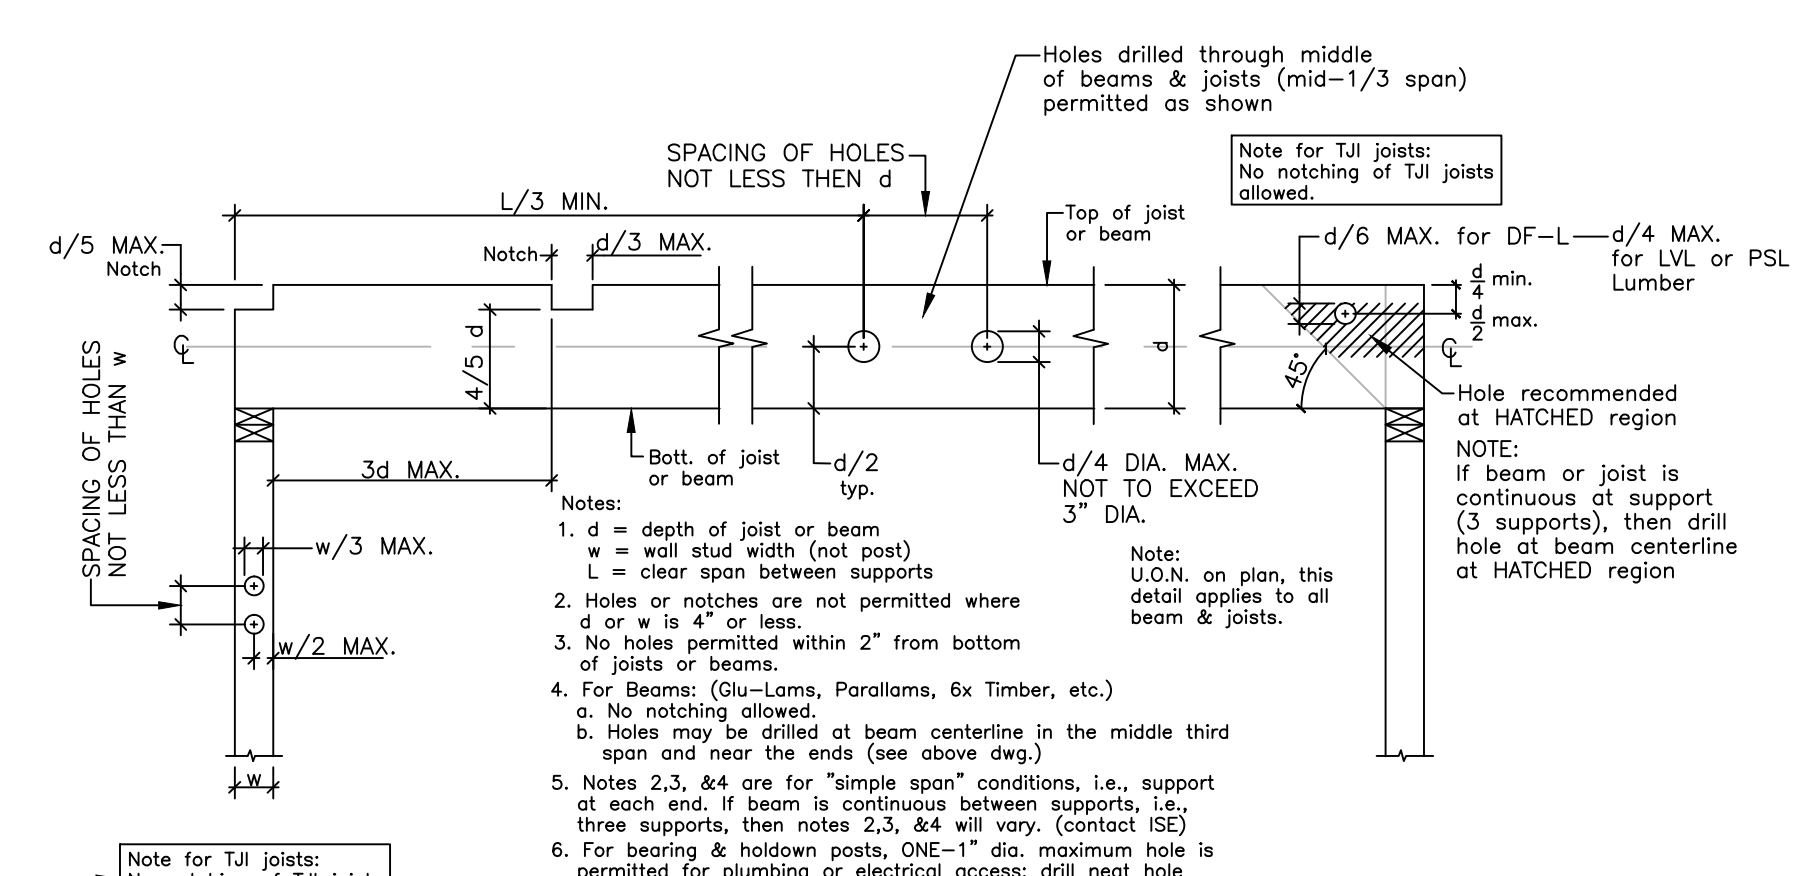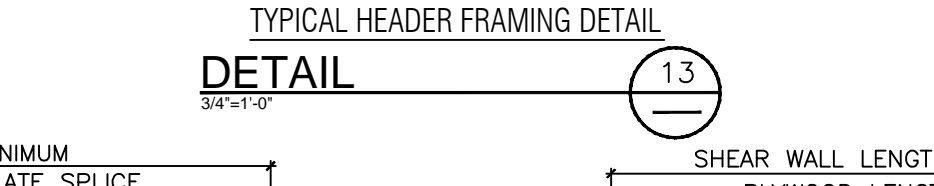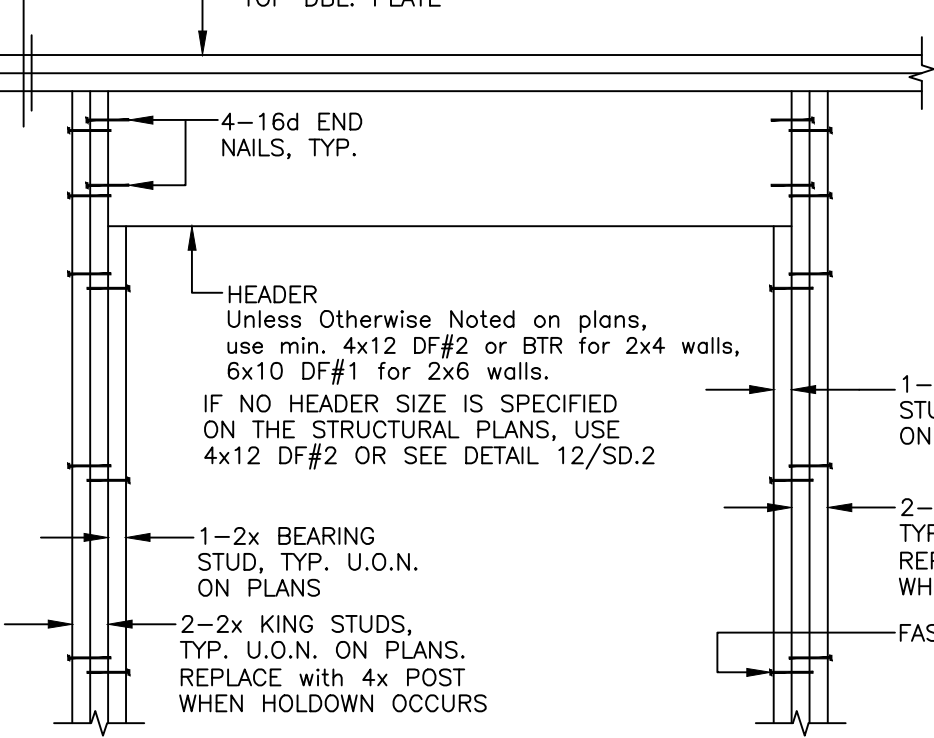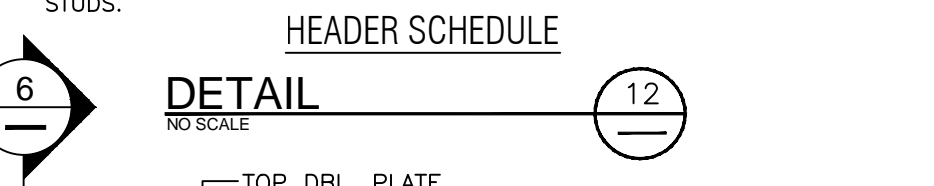


TYPICAL DRILLED HOLES IN JOISTS/BEAMS


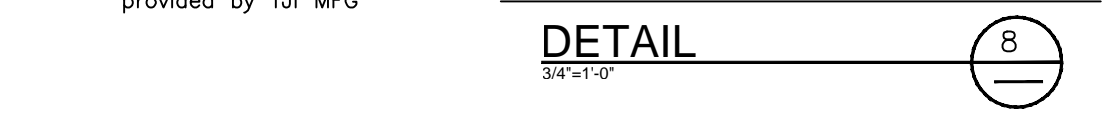


FOR PLUMBING or ELECTRICAL


NOTE: THIS DETAIL DOES NOT APPLY TO ROOF TRUSSES, NO CUTS OR NOTCHES ALLOWED IN ROOF TRUSSES

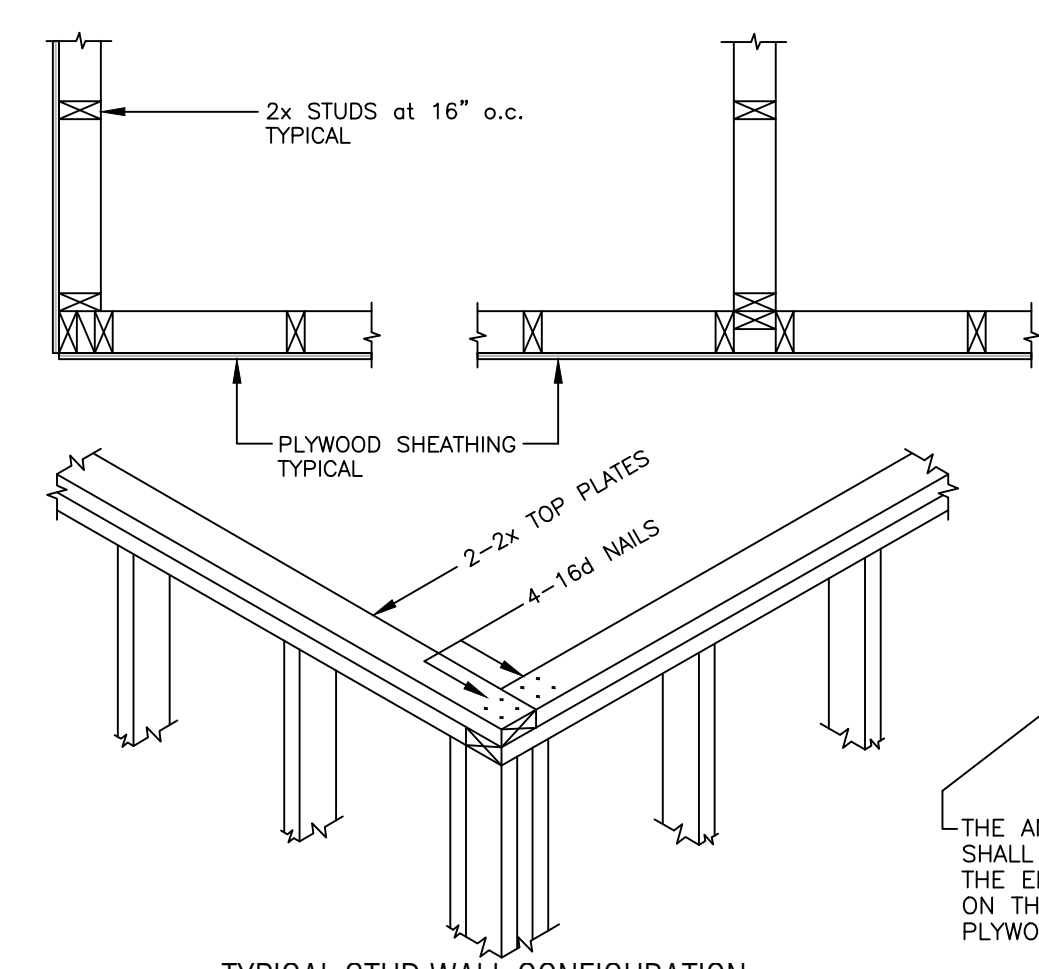


TYPICAL STUD WALL CONFIGURATION

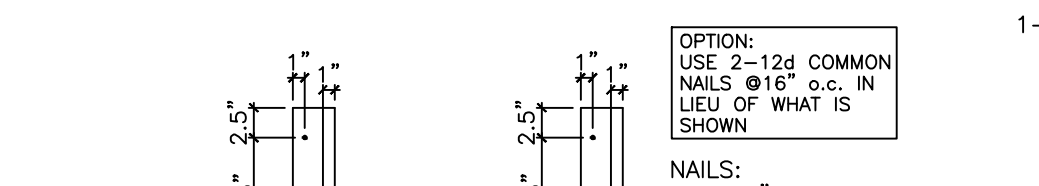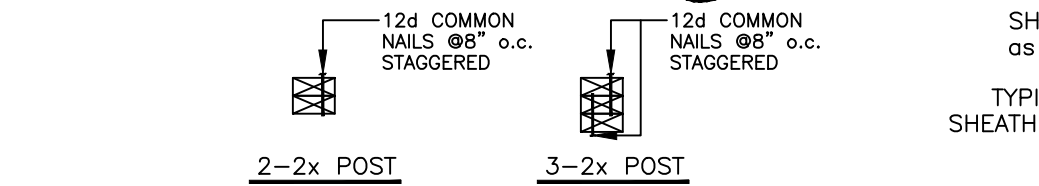


TYPICAL BUILT-UP 2x POST MEMBERS

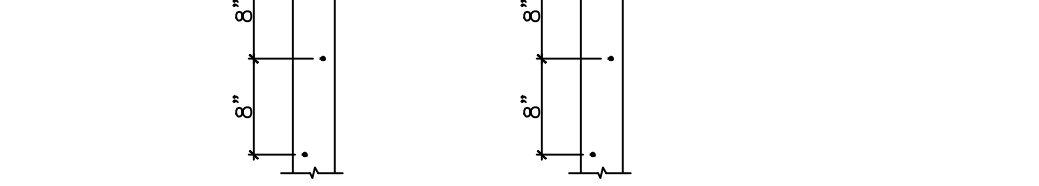


TYPICAL SHEAR WALL ELEVATION

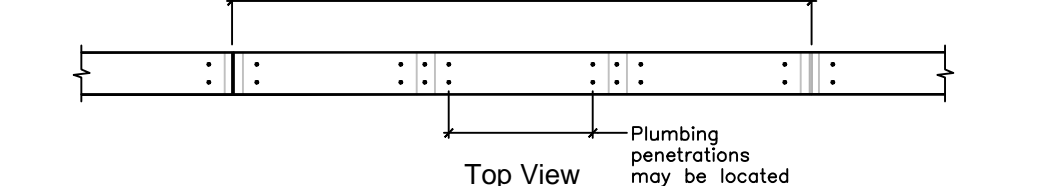


PLUMBING PENETRATION @ STRUCTURAL WALL

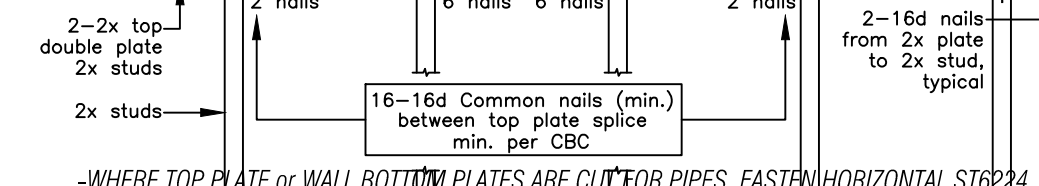


TYPICAL BUILT-UP 2x JOIST/BEAM MEMBERS

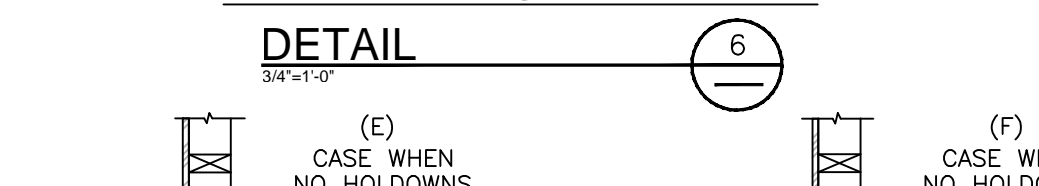


TYPICAL STRUCTURAL WALL FRAMING

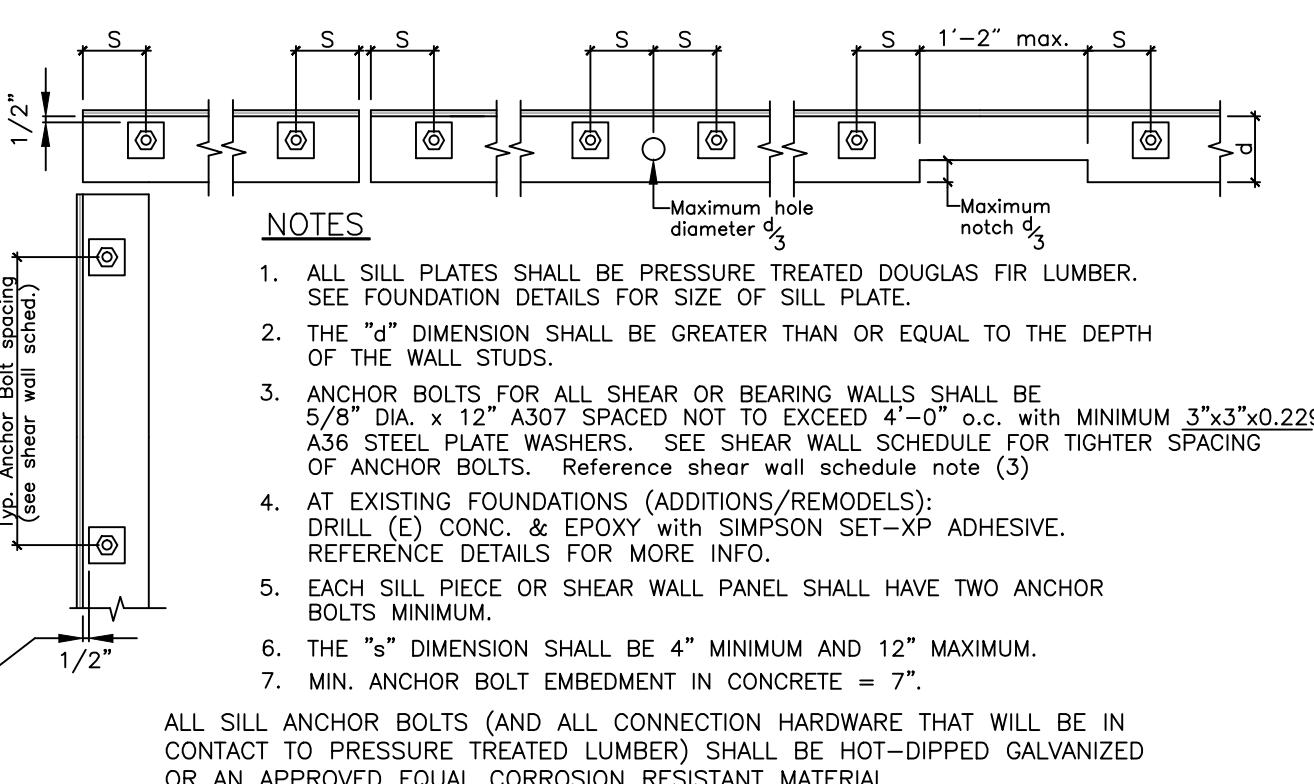


TYPICAL FOUNDATION SILL PLATE DETAIL

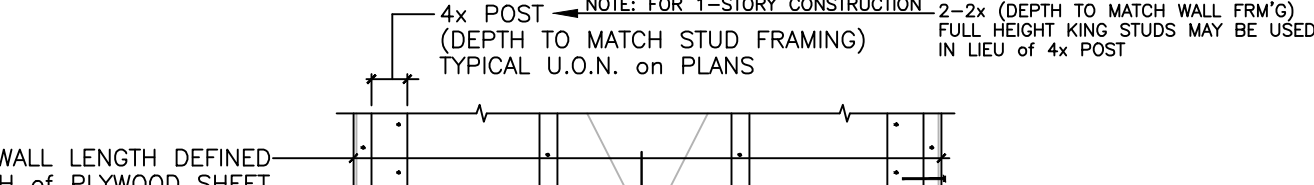


TYPICAL HOLDOWN @ FOUNDATION

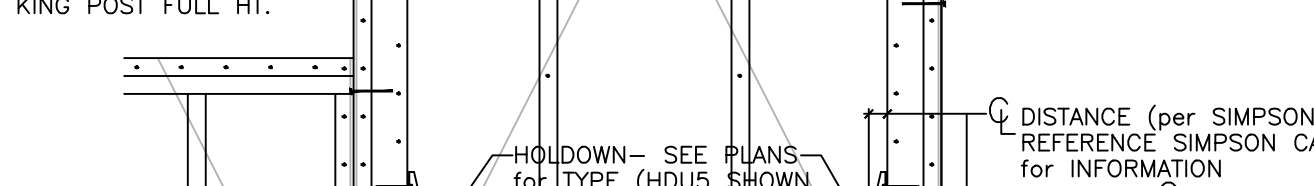


TYPICAL BAR BEND & LAPS

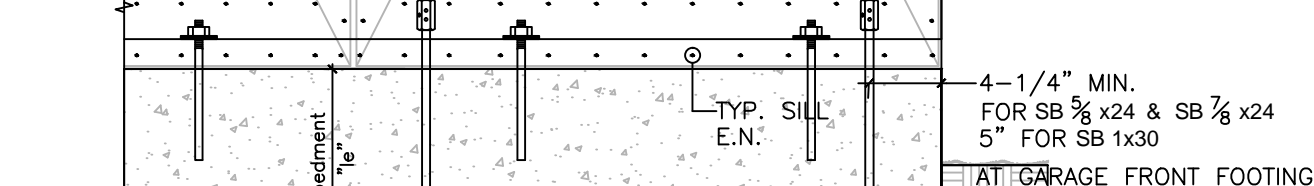


TYPICAL SHEAR WALL CORNERS & INTERSECTIONS

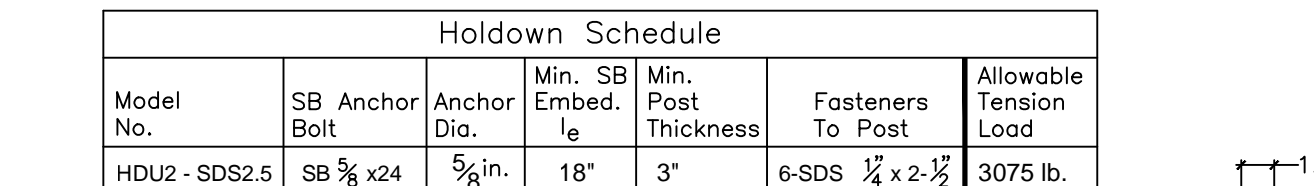


TYPICAL TOP PLATE @ STRUCTURAL WALL

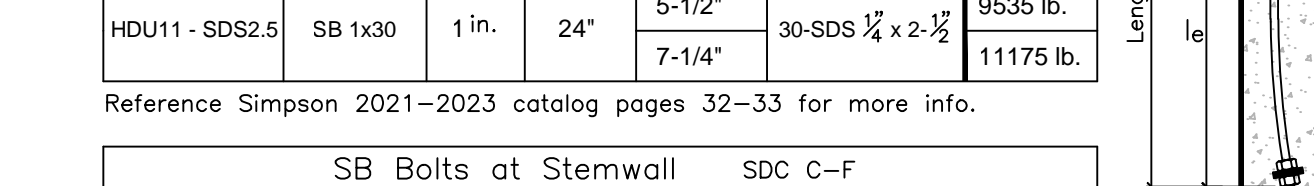


TYPICAL HOLDOWN @ FOUNDATION

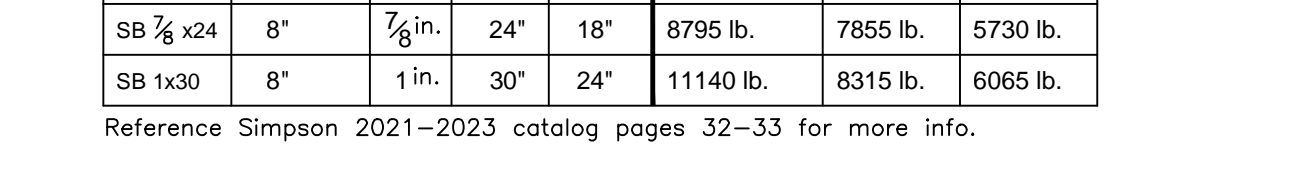


TYPICAL SHEAR WALL CORNERS & INTERSECTIONS

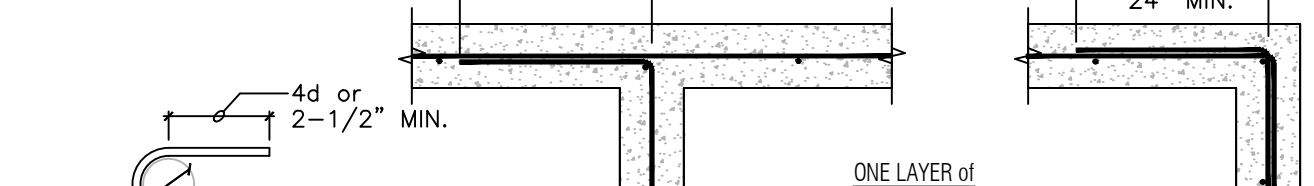

TYPICAL SHEAR WALL ELEVATION

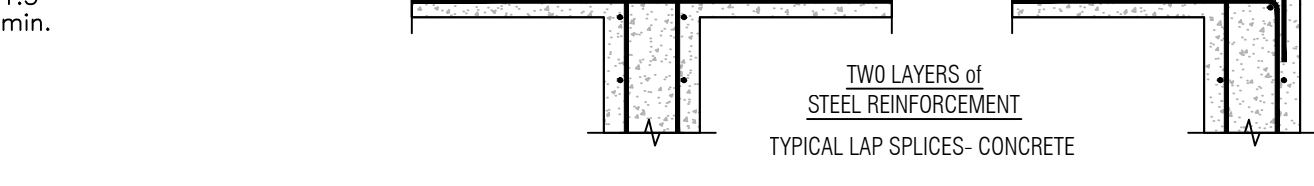

TYPICAL SHEAR WALL ELEVATION

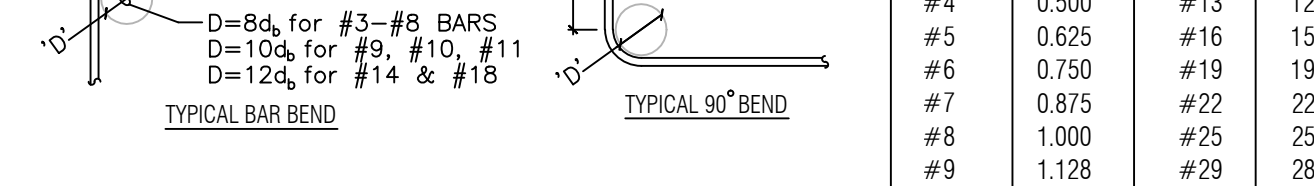

TYPICAL SHEAR WALL ELEVATION



TYPICAL SHEAR WALL ELEVATION

Holddown Schedule

Model No.	SB Anchor Bolt	Anchor Dia.	Min. Embed. le	Min. Post Thickness	Fasteners To Post	Allowable Tension Load
HDU2 - SDS2.5	SB 3/8" x 24	5/8" in.	18"	3"	6-SDS 1/4" x 2-1/2"	3075 lb.
HDU5 - SDS2.5	SB 3/8" x 24	5/8" in.	18"	3"	14-SDS 1/4" x 2-1/2"	5645 lb.
HDU8 - SDS2.5	SB 3/8" x 24	7/8" in.	18"	3-1/2"	20-SDS 1/4" x 2-1/2"	6970 lb.
HDU11 - SDS2.5	SB 1/2" x 30	1 in.	24"	5-1/2"	30-SDS 1/4" x 2-1/2"	9535 lb.
				7-1/4"		11175 lb.

SB Bolts at Stenwall SDC C-F

Model No.	Dimensions (in.)			Allowable Tension Loads (lbs.)		
	Stenwall Width (min)	Dia.	Length	CONTINUOUS (Midwall)	CORNER (Corner)	ENDS (End Wall)
SB 3/8" x 24	6"	5/8" in.	24"	6675 lb.	5730 lb.	5730 lb.
SB 3/8" x 24	8"	7/8" in.	24"	8795 lb.	7855 lb.	5730 lb.
SB 1/2" x 30	8"	1 in.	30"	11140 lb.	8315 lb.	6065 lb.

Reference Simpson 2021-2023 catalog pages 32-33 for more info.

Reference Simpson 2021-2023 catalog pages 32-33 for more info.




Reference Simpson 2021-2023 catalog pages 32-33 for more info.

Reference Simpson 2021-2023 catalog pages 32-33 for more info.





Reference Simpson 2021-2023 catalog pages 32-33 for more info.

Reference Simpson 2021-2023 catalog pages 32-33 for more info.

Reference Simpson 2021-2023 catalog pages

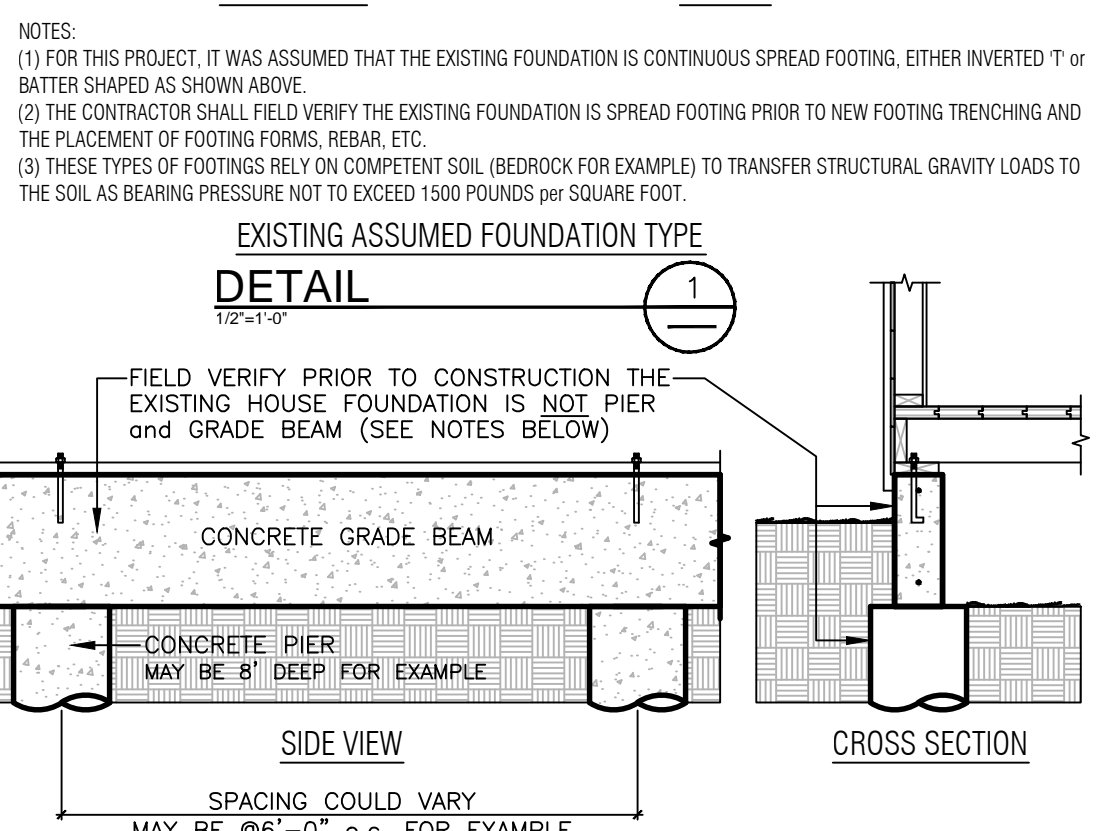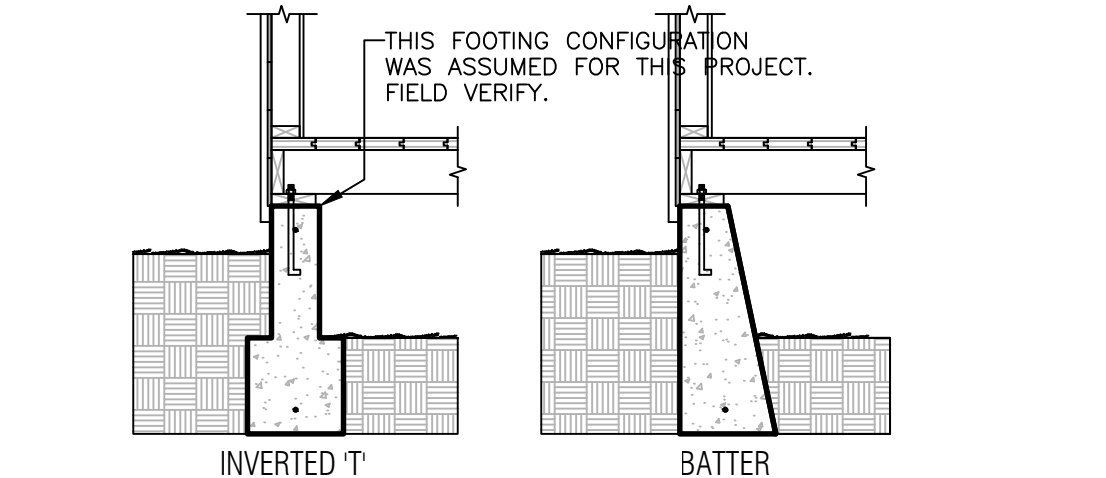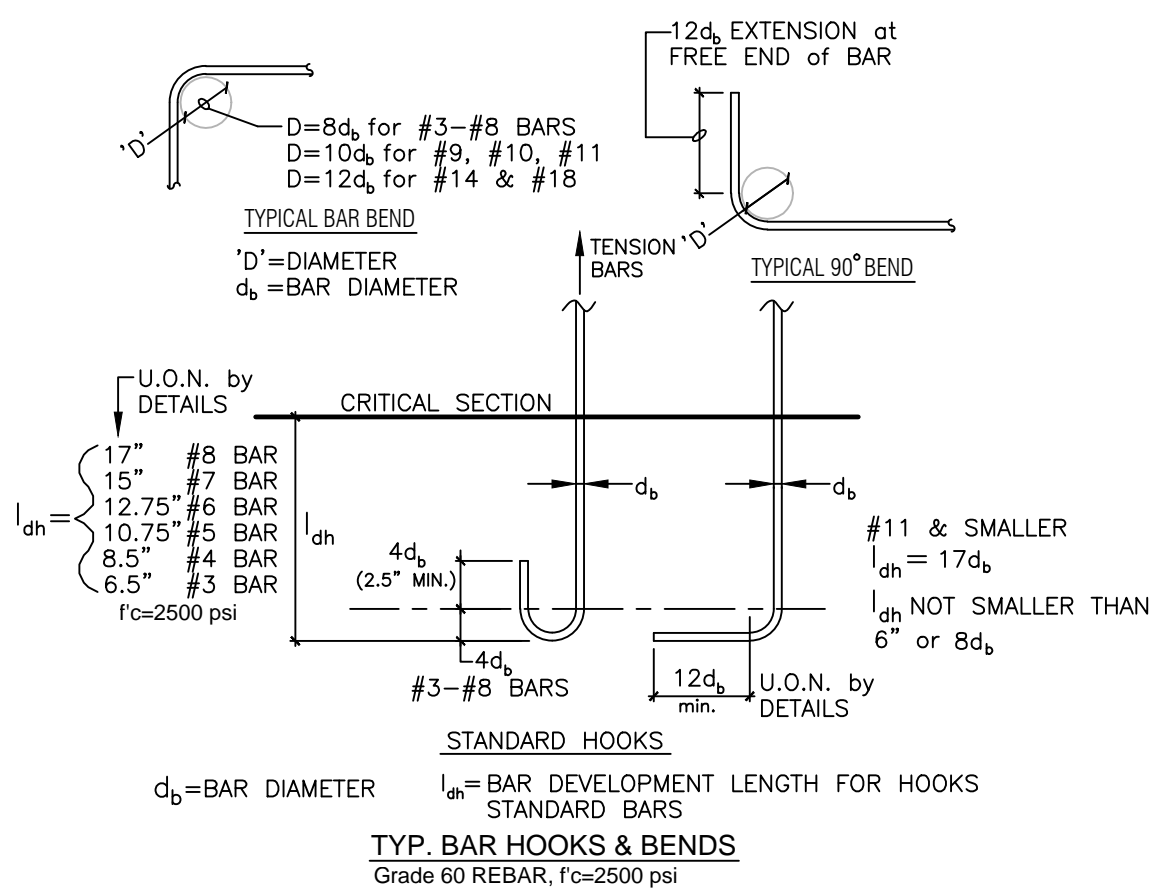






NOTES:
 (1) THE CONTRACTOR SHALL FIELD VERIFY (PRIOR TO ANY NEW FOOTING TRENCH WORK, AND PRIOR TO THE PLACEMENT OF NEW FOUNDATION FORMS, REBAR, ETC.) THAT PIER & GRADE BEAM FOUNDATION DOES NOT OCCUR.
 (2) IF THE EXISTING FOUNDATION SYSTEM FOR THIS PROJECT IS DISCOVERED IN THE FIELD TO BE PIER & GRADE BEAM, THEN STOP CONSTRUCTION AND NOTIFY THE PROJECT ENGINEER IMMEDIATELY. THIS NEEDS TO BE VERIFIED PRIOR TO ANY NEW FOUNDATION WORK AS STATED ON THE FOUNDATION PLAN AND RELATED DETAILS.
 (3) IF THE EXISTING FOUNDATION IS PIER & GRADE BEAM, THEN A SOIL ENGINEER MUST BE HIRED BY THE PROPERTY OWNER (HOME OWNER) AS A CONSULTANT FOR RECOMMENDATIONS TO ANY NEW FOOTINGS, AND THEREFORE THE CURRENT DESIGNED FOUNDATION PLAN AND RELATED DETAILS COULD AND MAY CHANGE.

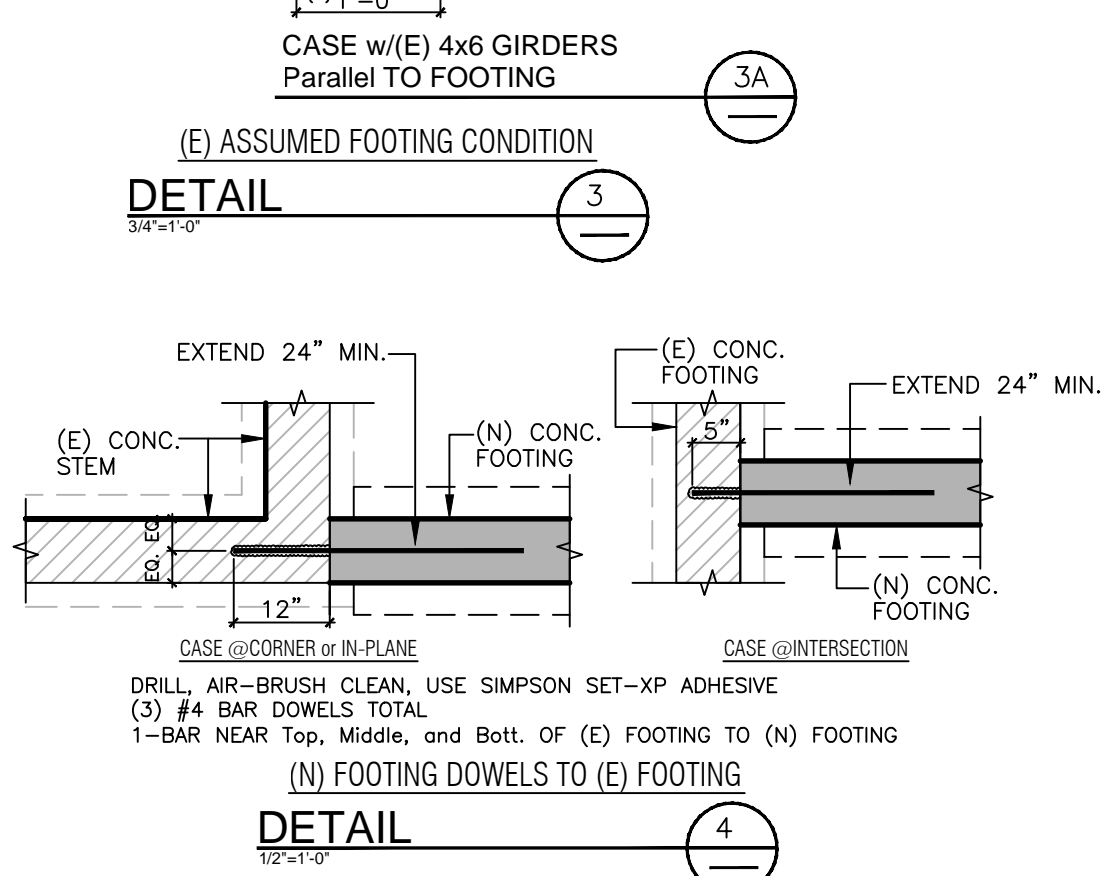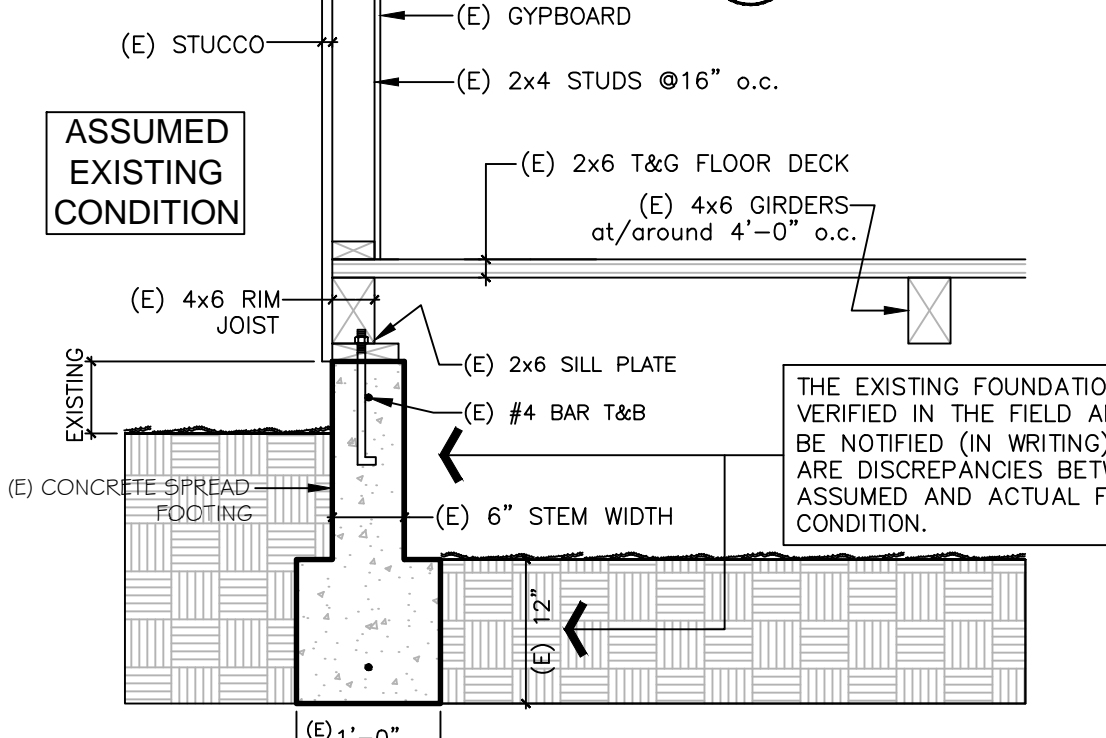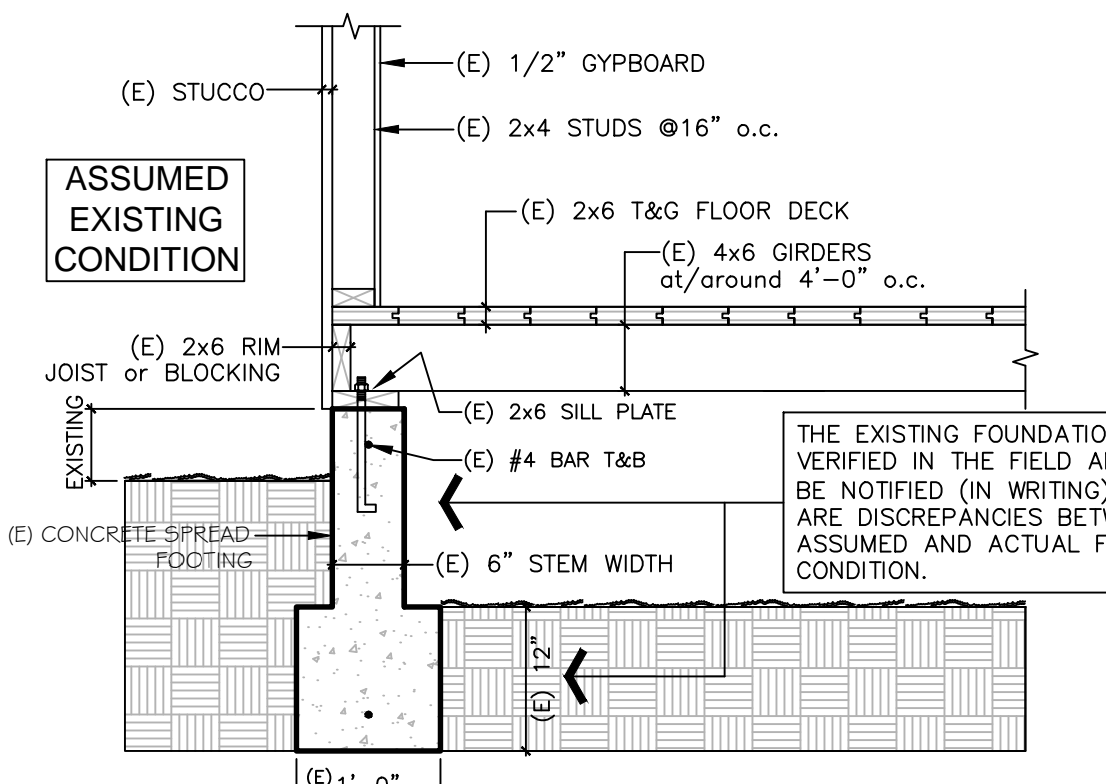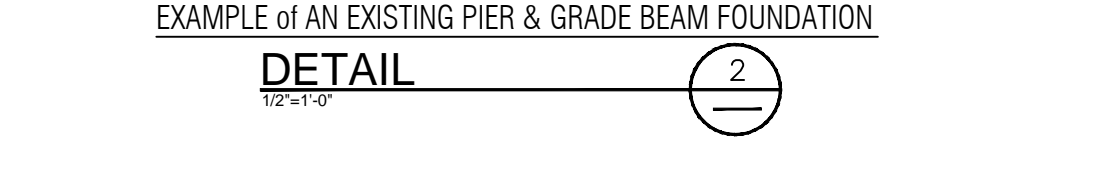

DESCRIPTION	Edges (inches)	Intermediate supports (inches)
28. Joist to band joist or rim joist	3-16d common ($2 \frac{1}{2} \times 0.162$) or 4-10d box (3×0.128) or 4-3" x 0.131" nails, or 4-3" 14 gage staples, $7/16"$ crown	End nail
29. Bridging or blocking to joist, rafter or truss	2-8d common ($2 \frac{1}{2} \times 0.131$) or 2-10d box (3×0.128) or 2-3" x 0.131" nails, or 2-3" 14 gage staples, $7/16"$ crown	Each end, toenail
Wood structural panels (WSP), subfloor, roof and interior wall sheathing to framing and particleboard wall sheathing to framing		
	6d common or deformed (2×0.113) (subfloor and wall)	6 12
	8d common or deformed ($2 \frac{1}{2} \times 0.131$) (roof) or RSRS-01 ($2 \frac{1}{2} \times 0.131$) nail (roof)	6 12
	2 $1 \frac{1}{2} \times 0.113$ nail (subfloor and wall)	6 12
	1 $1 \frac{1}{2} \times 16$ gage staple, $7/16"$ crown (subfloor and wall)	4 8
	2 $1 \frac{1}{2} \times 0.113$ nail (roof)	4 8
	1 $1 \frac{1}{2} \times 16$ gage staple, $7/16"$ crown (roof)	3 6
	8d common ($2 \frac{1}{2} \times 0.131$) or 8d deformed (2×0.113) (subfloor and wall)	6 12
	8d common or deformed ($2 \frac{1}{2} \times 0.131$) (roof) or RSRS-01 ($2 \frac{1}{2} \times 0.131$) nail (roof)	6 12
	2 $1 \frac{1}{2} \times 0.113$ nail, or 2" 16 gage staple, $7/16"$ crown	4 8
	10d common (3×0.148) or 8d deformed ($2 \frac{1}{2} \times 0.131$)	6 12
Other exterior wall sheathing		
	1 $1 \frac{1}{2} \times 16$ gage staple with $7/16"$ or 1" crown	3 6
	1 $1 \frac{1}{2} \times 16$ gage staple with $7/16"$ or 1" crown	3 6
Wood structural panels, combination subfloor underlayment to framing		
	8d common ($2 \frac{1}{2} \times 0.131$) or 8d deformed (2×0.113)	6 12
	8d common ($2 \frac{1}{2} \times 0.131$) or 8d deformed ($2 \frac{1}{2} \times 0.131$)	6 12
	10d common (3×0.148) or 8d deformed ($2 \frac{1}{2} \times 0.131$)	6 12
Panel siding to framing		
	6d corrosion-resistant siding ($1 \frac{1}{2} \times 0.106$) or 6d corrosion-resistant casing (2×0.099)	6 12
	8d corrosion-resistant siding ($2 \frac{1}{2} \times 0.128$) or 8d corrosion-resistant casing ($2 \frac{1}{2} \times 0.118$)	6 12
Wood structural panels (WSP), subfloor, roof and interior wall sheathing to framing and particleboard wall sheathing to framing		
Interior paneling		
	4d casing ($1 \frac{1}{2} \times 0.089$) or 4d mesh ($1 \frac{1}{2} \times 0.077$)	6 12
	6d casing (2×0.099) or 6d mesh (panel supports at 24 inches)	6 12

2019 CBC TABLE 2304.10.1 FASTENER SCHEDULE

DESCRIPTION OF BUILDING ELEMENTS	NUMBER AND TYPE OF FASTENER	SPACING AND LOCATION
Roof		
1. Blocking between ceiling joists, rafters or trusses to top plate or other framing below	3-8d common ($2 \frac{1}{2} \times 0.131$) or 3-10d box (3×0.128) or 3-3" x 0.131" nails, or 3-3" 14 gage staples, $7/16"$ crown	Each end, toenail
Blocking between rafters or truss not at the wall top plate, to rafter or truss	2-8d common ($2 \frac{1}{2} \times 0.131$) or 2-3" x 0.131" nails, or 2-3" 14 gage staples	Each end, toenail
Flat blocking to truss and web filler	2-16 d common ($2 \frac{1}{2} \times 0.162$) or 2-3" x 0.131" nails, or 2-3" 14 gage staples	End nail
2. Ceiling joists to top plate	3-8d common ($2 \frac{1}{2} \times 0.131$) or 3-10d box (3×0.128) or 3-3" x 0.131" nails, or 3-3" 14 gage staples, $7/16"$ crown	Each joint, toenail
3. Ceiling joist not attached to parallel rafter, laps over girders (no truss)	3-16d common ($3 \frac{1}{2} \times 0.162$) or 4-10d box (3×0.128) or 4-3" x 0.131" nails, or 4-3" 14 gage staples, $7/16"$ crown	Face nail
4. Ceiling joist attached to parallel rafter (heel joint)	Per Table 2308.7.3.1	Face nail
5. Collar tie to rafter	3-10d common (3×0.148) or 3-10d box (3×0.128) or 3-3" x 0.131" nails, or 3-3" 14 gage staples, $7/16"$ crown	Face nail
6. Rafter or roof truss to top plate (see Section 2308.7.3, Table 2308.7.3)	3-10d common (3×0.148) or 3-10d box (3×0.128) or 3-3" x 0.131" nails, or 3-3" 14 gage staples, $7/16"$ crown	Toenail
7. Roof rafters to ridge valley or hip rafters or roof rafter to 2-inch ridge beam	3-10d common (3×0.148) or 3-10d box (3×0.128) or 3-3" x 0.131" nails, or 3-3" 14 gage staples, $7/16"$ crown; or 3-10d common (3×0.148) or 3-10d box (3×0.128) or 3-3" x 0.131" nails, or 3-3" 14 gage staples, $7/16"$ crown	Toenail
Wall		
8. Stud to stud (at braced wall panels)	16d common ($3 \frac{1}{2} \times 0.162$) or 10d box (3×0.128) or 3" x 0.131" nails, or 3-3" 14 gage staples, $7/16"$ crown	24" o.c. face nail
9. Stud to stud and abutting studs at intersecting wall corners (at braced wall panels)	16d common ($3 \frac{1}{2} \times 0.162$) or 10d box (3×0.128) or 3" x 0.131" nails, or 3-3" 14 gage staples, $7/16"$ crown	16" o.c. face nail
10. Stud to stud and abutting studs at intersecting wall corners (at braced wall panels)	16d common ($3 \frac{1}{2} \times 0.162$) or 10d box (3×0.128) or 3" x 0.131" nails, or 3-3" 14 gage staples, $7/16"$ crown	12" o.c. face nail
11. Continuous header to stud	16d common ($3 \frac{1}{2} \times 0.162$) or 10d box (3×0.128) or 3" x 0.131" nails, or 3-3" 14 gage staples, $7/16"$ crown	16" o.c. each edge, face nail
12. Top plate to top plate	16d common ($3 \frac{1}{2} \times 0.162$) or 10d box (3×0.128) or 3" x 0.131" nails, or 3-3" 14 gage staples, $7/16"$ crown	16" o.c. face nail
13. Top plate to top plate, at end joints	8-16d common ($3 \frac{1}{2} \times 0.162$) or 12-10d box (3×0.128) or 12-3" x 0.131" nails, or 12-3" 14 gage staples, $7/16"$ crown	Each side of end joint, face nail (minimum 24" lap splice length with side of end joint)
14. Bottom plate to joist, rim joist, band joist or blocking (not at braced wall panels)	16d common ($3 \frac{1}{2} \times 0.162$) or 10d box (3×0.128) or 3" x 0.131" nails, or 3-3" 14 gage staples, $7/16"$ crown	16" o.c. face nail
15. Bottom plate to joist, rim joist, band joist or blocking at braced wall panels	3-16d common ($2 \frac{1}{2} \times 0.162$) or 3-16d box (3×0.130) or 4-3" x 0.131" nails, or 4-3" 14 gage staples, $7/16"$ crown	16" o.c. face nail
16. Stud to top or bottom plate	4-8d common ($2 \frac{1}{2} \times 0.131$) or 4-10d box (3×0.128) or 4-3" x 0.131" nails, or 4-3" 14 gage staples, $7/16"$ crown; or 2-16d common ($3 \frac{1}{2} \times 0.162$) or 2-10d box (3×0.128) or 2-3" x 0.131" nails, or 2-3" 14 gage staples, $7/16"$ crown	Toenail
17. Top plates, laps at corners and intersections	2-16d common ($3 \frac{1}{2} \times 0.162$) or 2-10d box (3×0.128) or 2-3" x 0.131" nails, or 2-3" 14 gage staples, $7/16"$ crown	Face nail
18. 1" brace to each stud and plate	2-8d common ($2 \frac{1}{2} \times 0.131$) or 2-10d box (3×0.128) or 2-3" x 0.131" nails, or 2-3" 14 gage staples, $7/16"$ crown	Face nail
19. 1" x 4" sheathing to each bearing	2-8d common ($2 \frac{1}{2} \times 0.131$) or 2-10d box (3×0.128)	Face nail
20. 1" x 4" and wider sheathing to each bearing	3-8d common ($2 \frac{1}{2} \times 0.131$) or 3-10d box (3×0.128)	Face nail
Floor		
21. Joist to sill, top plate, or girder	3-8d common ($2 \frac{1}{2} \times 0.131$) or floor 3-10d box (3×0.128) or 3" x 0.131" nails, or 3" 14 gage staples, $7/16"$ crown	Toenail
22. Rim joist, band joist, or blocking to top plate, sill or other framing below	8d common ($2 \frac{1}{2} \times 0.131$) or 10d box (3×0.128) or 3" x 0.131" nails, or 3" 14 gage staples, $7/16"$ crown	6" o.c., toenail
23. 1" x 4" subfloor or less to each joist	2-8d common ($2 \frac{1}{2} \times 0.131$) or 2-10d box (3×0.128)	Face nail
24. 2" subfloor to joist or girder	2-16d common ($3 \frac{1}{2} \times 0.162$)	Face nail
25. 2" planks (joists & beam - floor & roof)	3-16d common ($3 \frac{1}{2} \times 0.162$)	Each bearing, face nail
26. Built-up girders and beams, 2" lumber layers	20d common (4×0.192) or 10d box (3×0.128) or 3" x 0.131" nails, or 3" 14 gage staples, $7/16"$ crown	32" o.c. face nail at top and bottom staggered on opposite sides
	And: 2-20d common (4×0.192) or 2-10d box (3×0.128) or 2-3" x 0.131" nails, or 2-3" 14 gage staples, $7/16"$ crown	Ends and at each splice, face nail
27. Ledger strip supporting joists or rafters	3-16d common ($3 \frac{1}{2} \times 0.162$) or 4-10d box (3×0.128) or 4-3" x 0.131" nails, or 4-3" 14 gage staples, $7/16"$ crown	Each joint or rafter, face nail

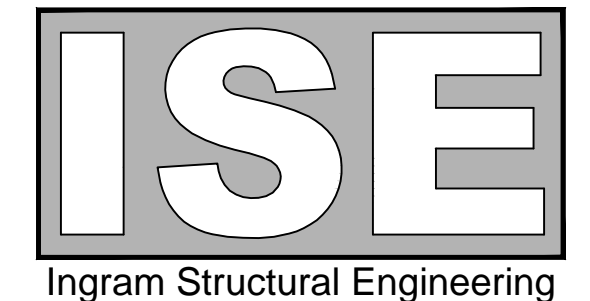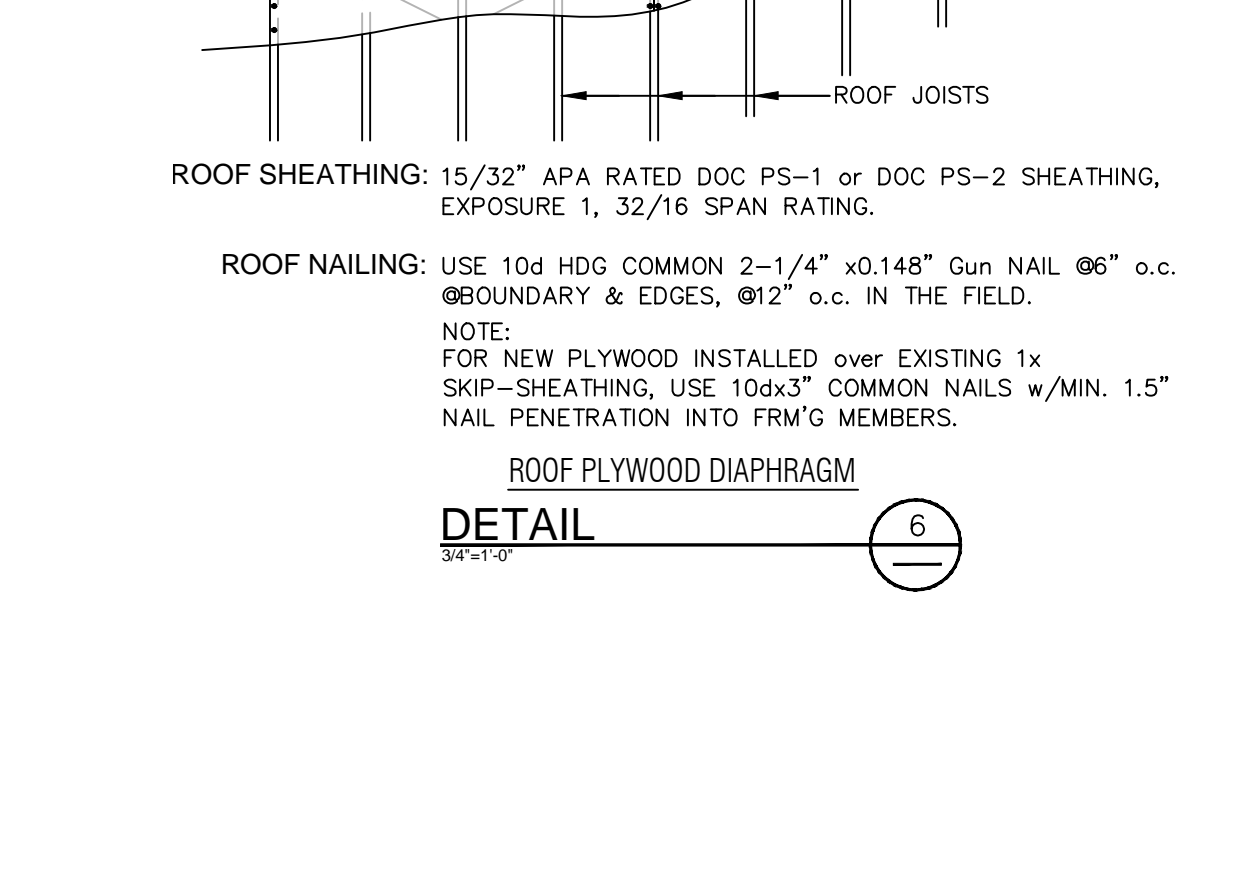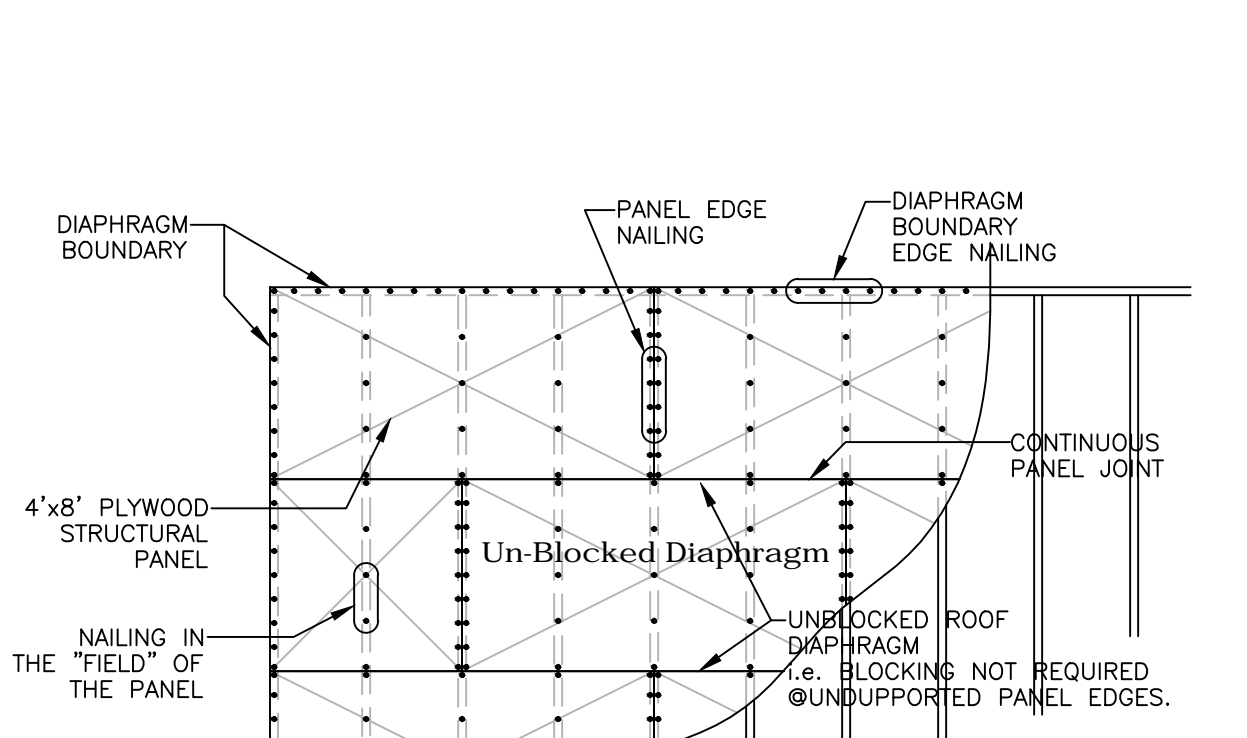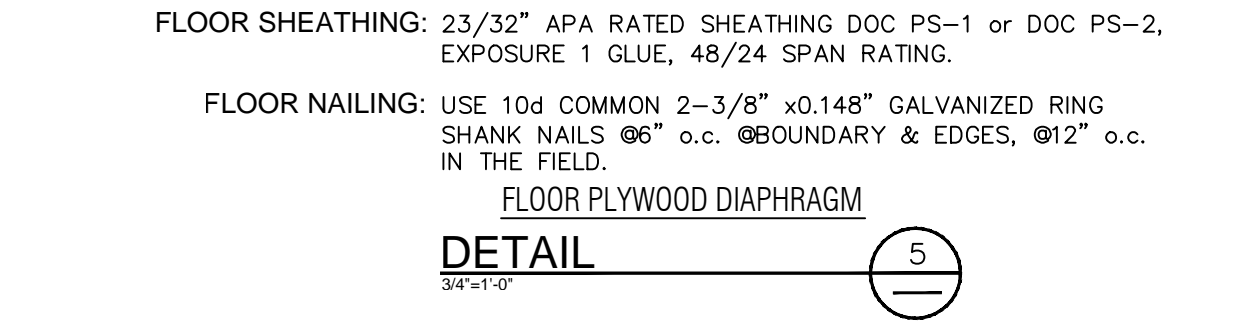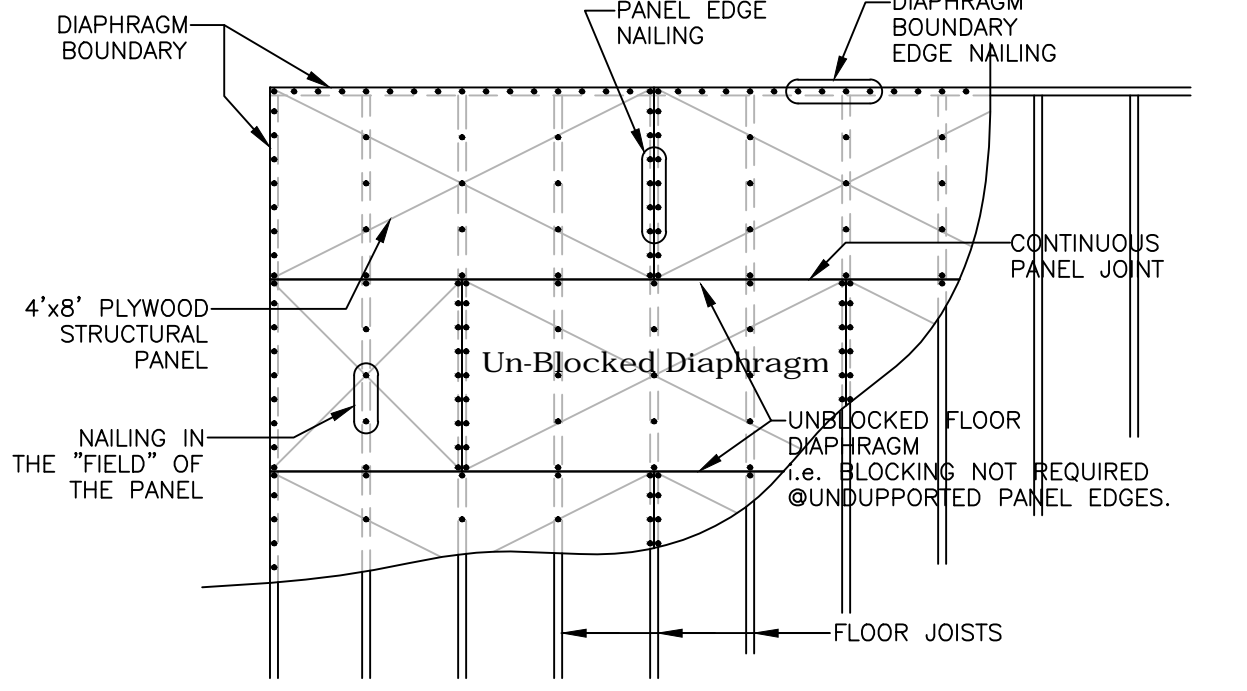

Jeff Ingram, P.E.
 CIVIL ENGINEER
 License No. C 66222
 2570 N. First Street, Suite 200
 San Jose, CA 95131
 (408) 836-6602 (Cell)
 (408) 836-6604 (Office)
 Email: jeff@ingram.com



JOB TITLE
 Vesa Residence
 684 N. Redwood Ave.
 San Jose, CA 95128

DATE ISSUE:
 7/6/2022

1/9/2023 PER BUILDING DEPARTMENT PLAN CHECK

THESE STRUCTURAL DRAWINGS WERE PRODUCED BY ISE. THE USE OF THESE PLANS AND SPECIFICATIONS SHALL BE RESTRICTED TO THE ORIGINAL SITE FOR WHICH THEY WERE PREPARED, AND PUBLICATION THEREOF IS EXPRESSLY LIMITED TO SUCH USE. RE-USE, REPRODUCTION, OR PUBLICATION BY ANY METHOD, IN WHOLE OR IN PART, IS PROHIBITED. FURTHERMORE, TITLE TO THE PLANS AND SPECIFICATIONS REMAINS WITH ISE. VISUAL CONTACT WITH THESE PLANS AND SPECIFICATIONS CONSTITUTE PROOF OF ACCEPTANCE OF ALL RESTRICTIONS.
 Copyright © 2022 ISE Ingram Structural Engineering

PROJECT #: 824 SCALE: 1/4"=1'-0"
 DRAWN BY: YI, JI
 PROJECT MANAGER: JI
 ENGINEERED BY: JI
 REVIEWED BY: JI

Structural Details

SD.3



Ingram Structural Engineering

Jeff Ingram, P.E.

CIVIL ENGINEER
License No. C 66222
2570 N. First Street, Suite 200
San Jose, CA 95131
(408) 836-6602 (Cell)
(408) 836-6604 (Office)
Email: jeff@ingramse.com



JOB TITLE

Vesa Residence
684 N. Redwood Ave.
San Jose, CA 95128

DATE ISSUE:

7/6/2022

1/9/2023 PER BUILDING DEPARTMENT PLAN CHECK

THESE STRUCTURAL DRAWINGS WERE PRODUCED BY ISE. THE USE OF THESE PLANS AND SPECIFICATIONS SHALL BE RESTRICTED TO THE ORIGINAL SITE FOR WHICH THEY WERE PREPARED, AND PUBLICATION THEREOF IS EXPRESSLY LIMITED TO SUCH USE. RE-USE, REPRODUCTION, OR PUBLICATION BY ANY METHOD, IN WHOLE OR IN PART, IS PROHIBITED. FURTHERMORE, TITLE TO THE PLANS AND SPECIFICATIONS REMAINS WITH ISE. VISUAL CONTACT WITH THESE PLANS AND SPECIFICATIONS CONSTITUTE PROOF OF ACCEPTANCE OF ALL RESTRICTIONS.
Copyright © 2022 ISE Ingram Structural Engineering

PROJECT #: 824 SCALE: 1/4"=1'-0"

DRAWN BY: YI, JI

PROJECT MANAGER: JI

ENGINEERED BY: JI

REVIEWED BY: JI

Structural
Details










SD.4

Grading, General Surface Drainage

-On graded sites the top of (N) exterior foundation shall extend above the elevation of the street gutter at point of discharge (or the inlet of any approved drainage device) a min. of 12" plus 2% per 2019 CRC sec. R403.1.7.3

-Surface Drainage: Provide rough and finish grading for 5% min. slope (2% min. at paved areas) for 10' away from all structures (min.) per sec. R401.3, 2019 CRC.

ALL SILL ANCHOR BOLTS (AND ALL CONNECTION HARDWARE THAT WILL BE IN CONTACT TO PRESSURE TREATED LUMBER) SHALL BE HOT-DIPPED GALVANIZED [HDG] OR AN APPROVED EQUAL CORROSION RESISTANT MATERIAL.
-All holdowns & anchor bolts (all hardware) must be secured in place prior to foundation inspection, and all anchor bolts shall be re-tightened prior to the final installation of gypsum board or inside coverings for the shear walls.
-Hot-dipped, zinc-coated, galvanized, or aluminum alloy corrosion resistant anchor bolts shall be used on pressure treated wood plates.

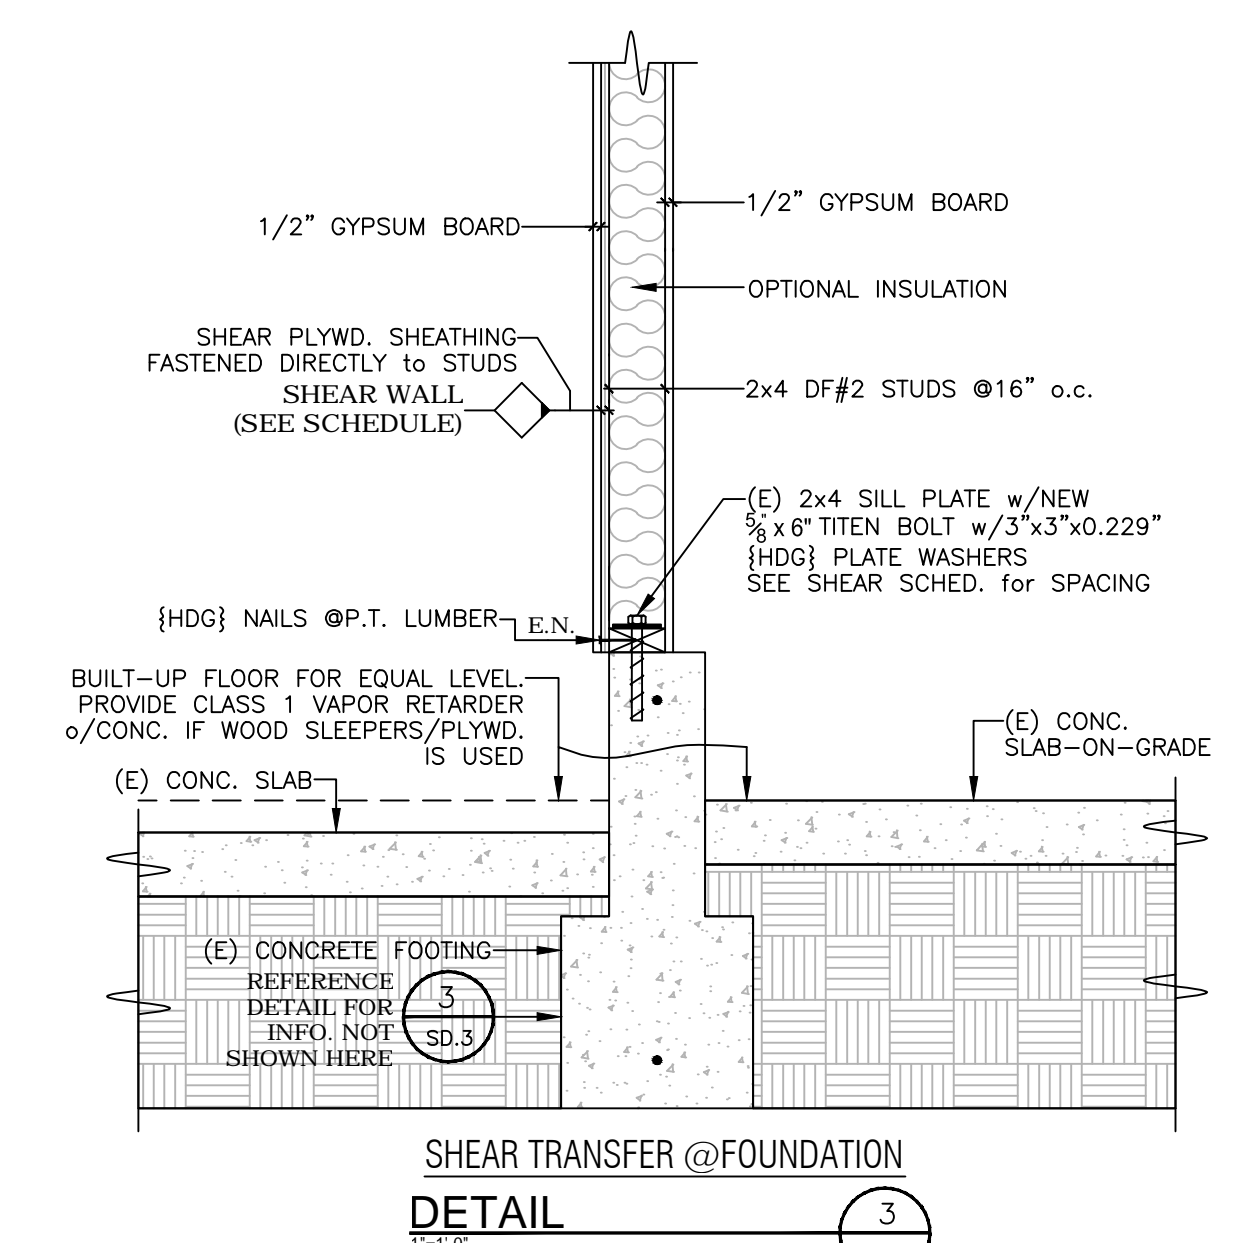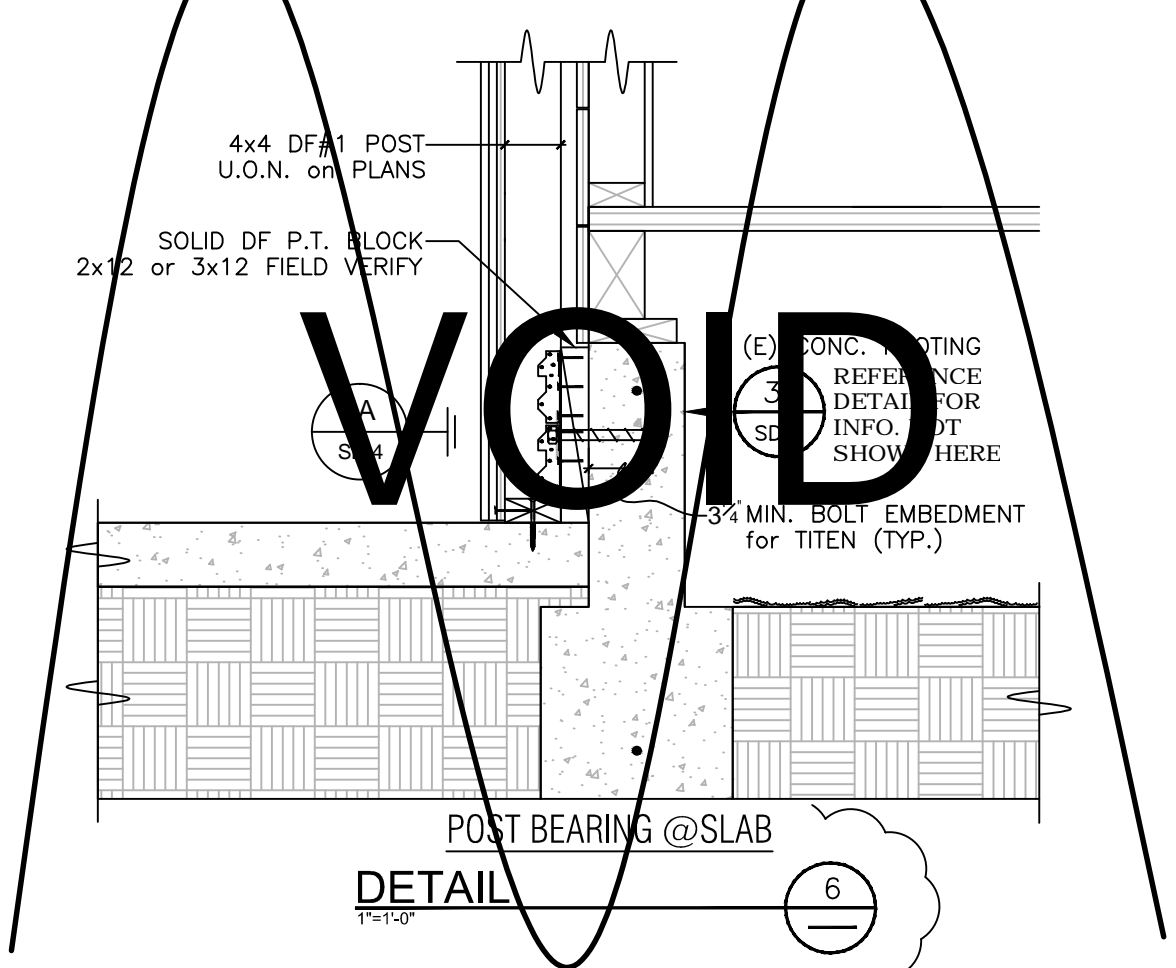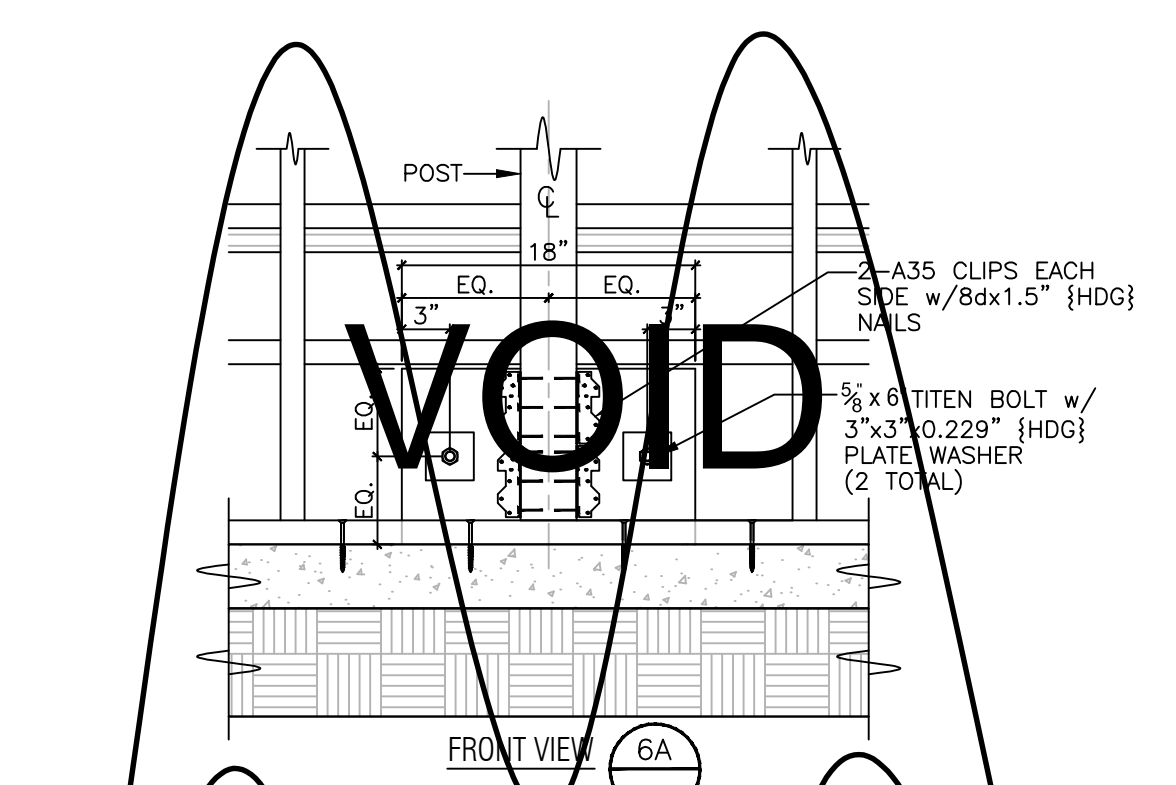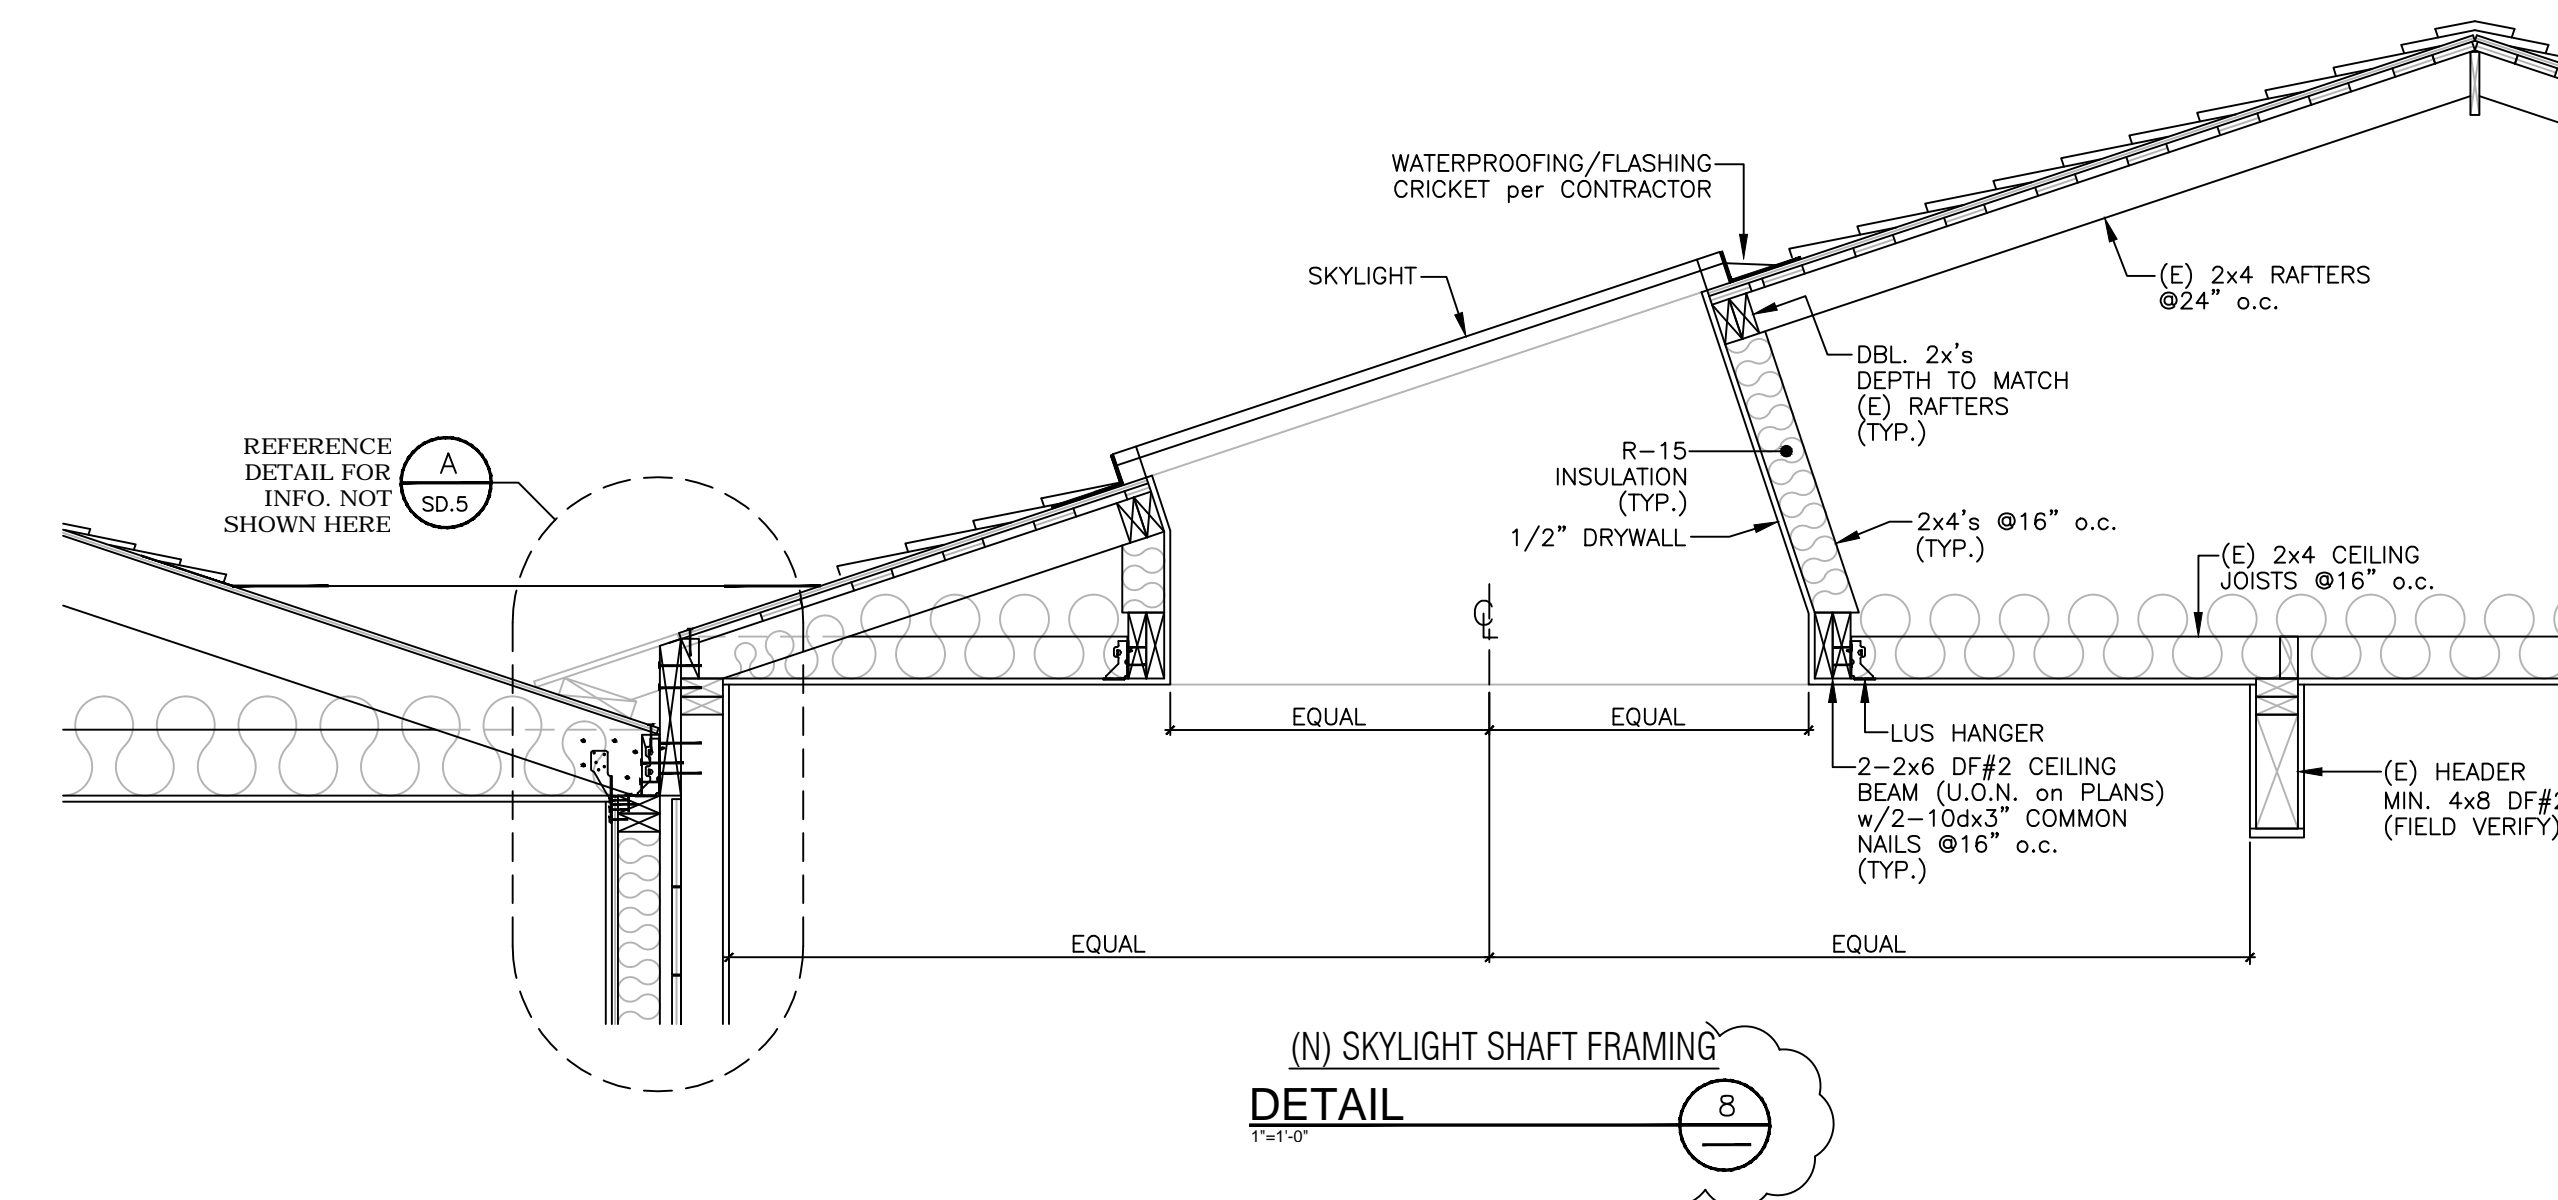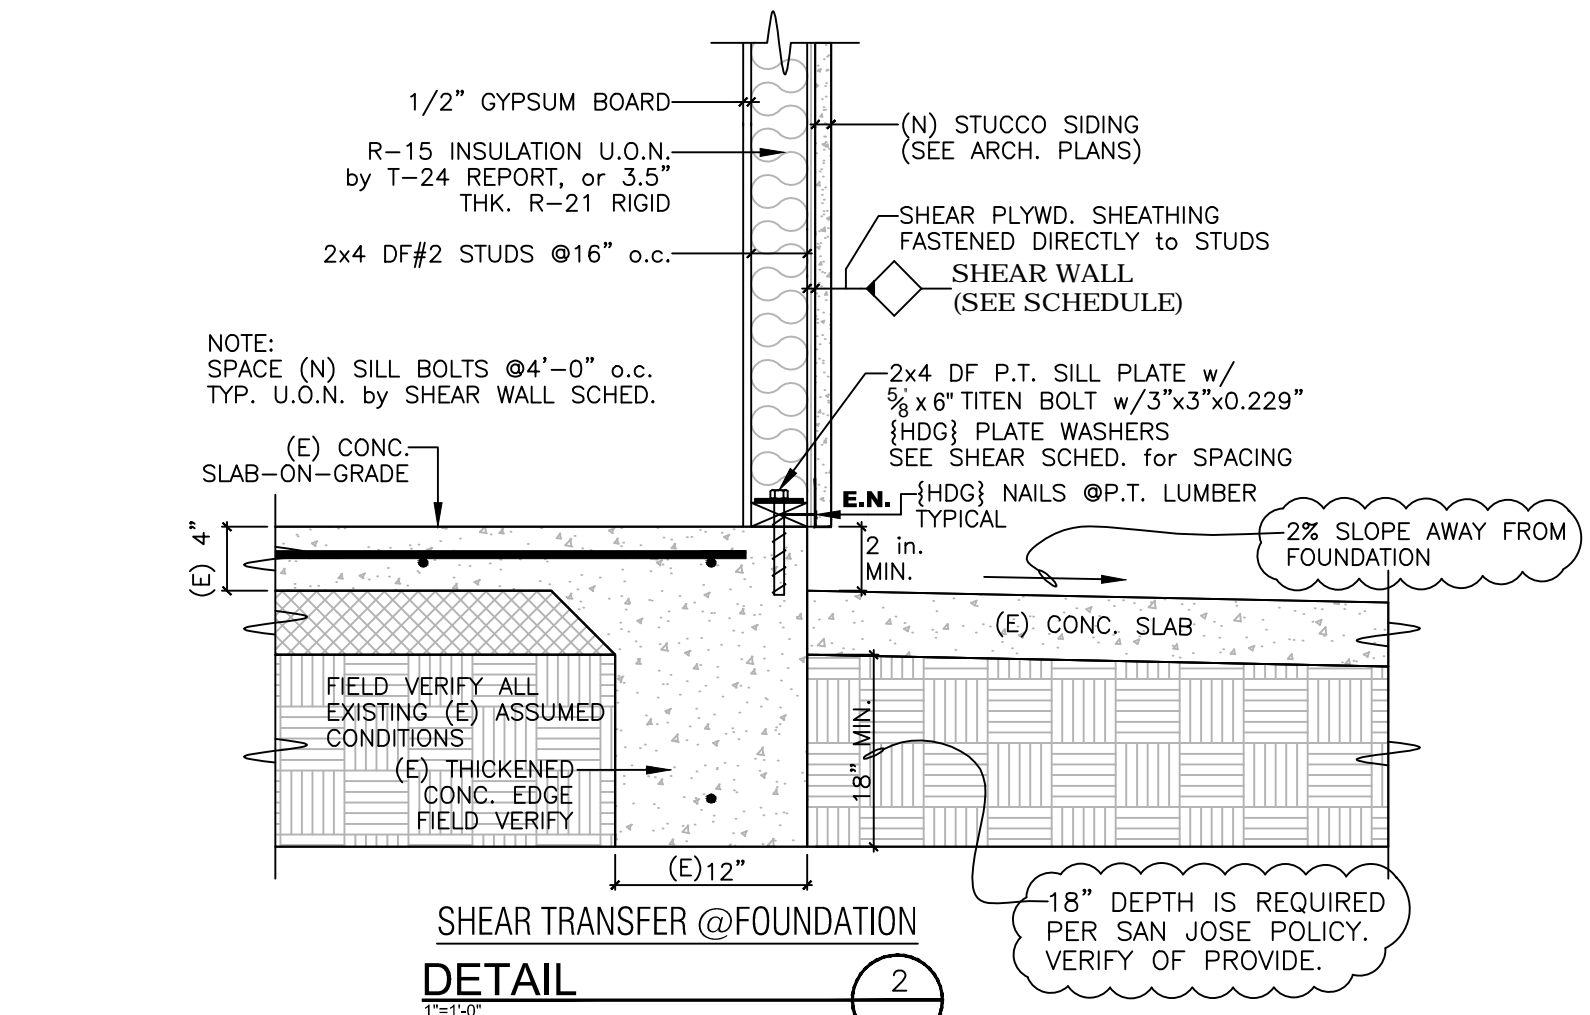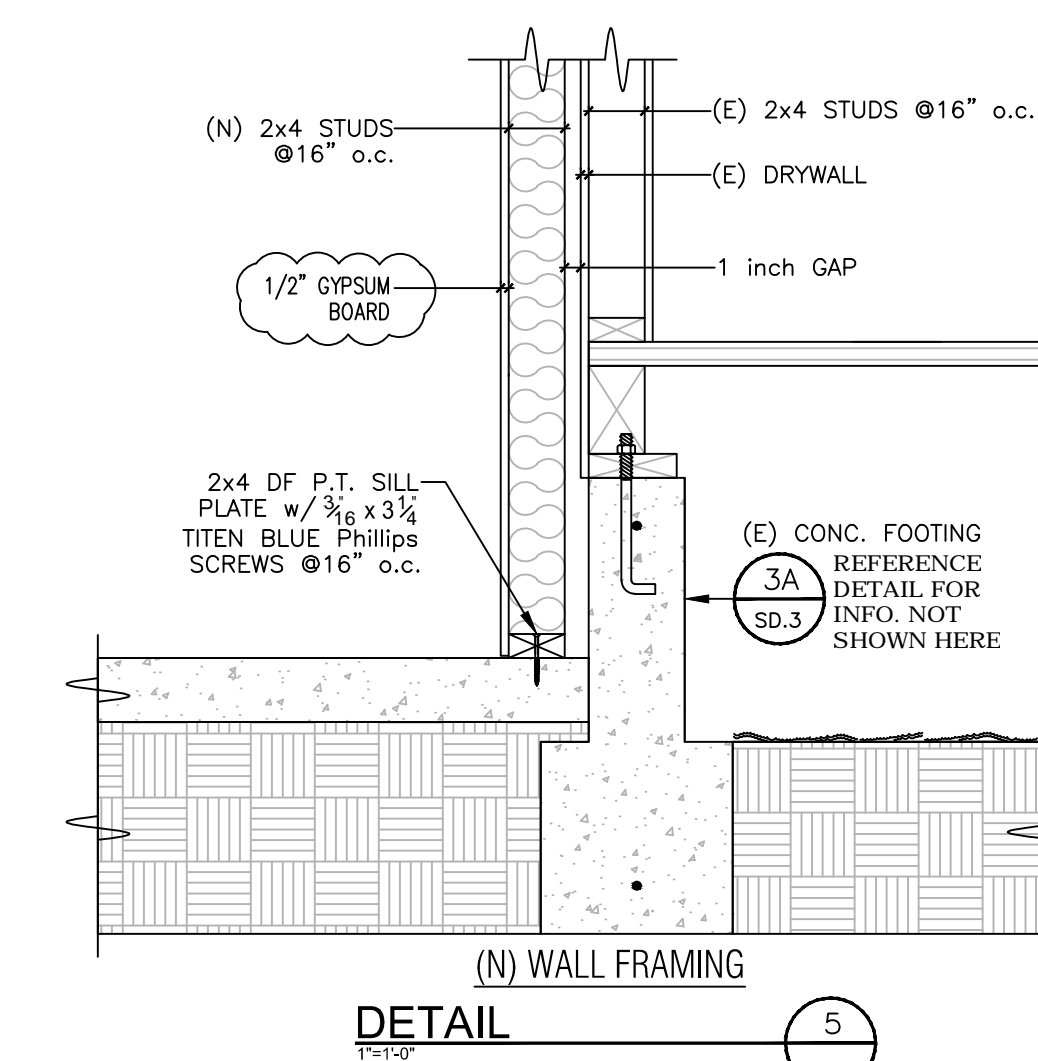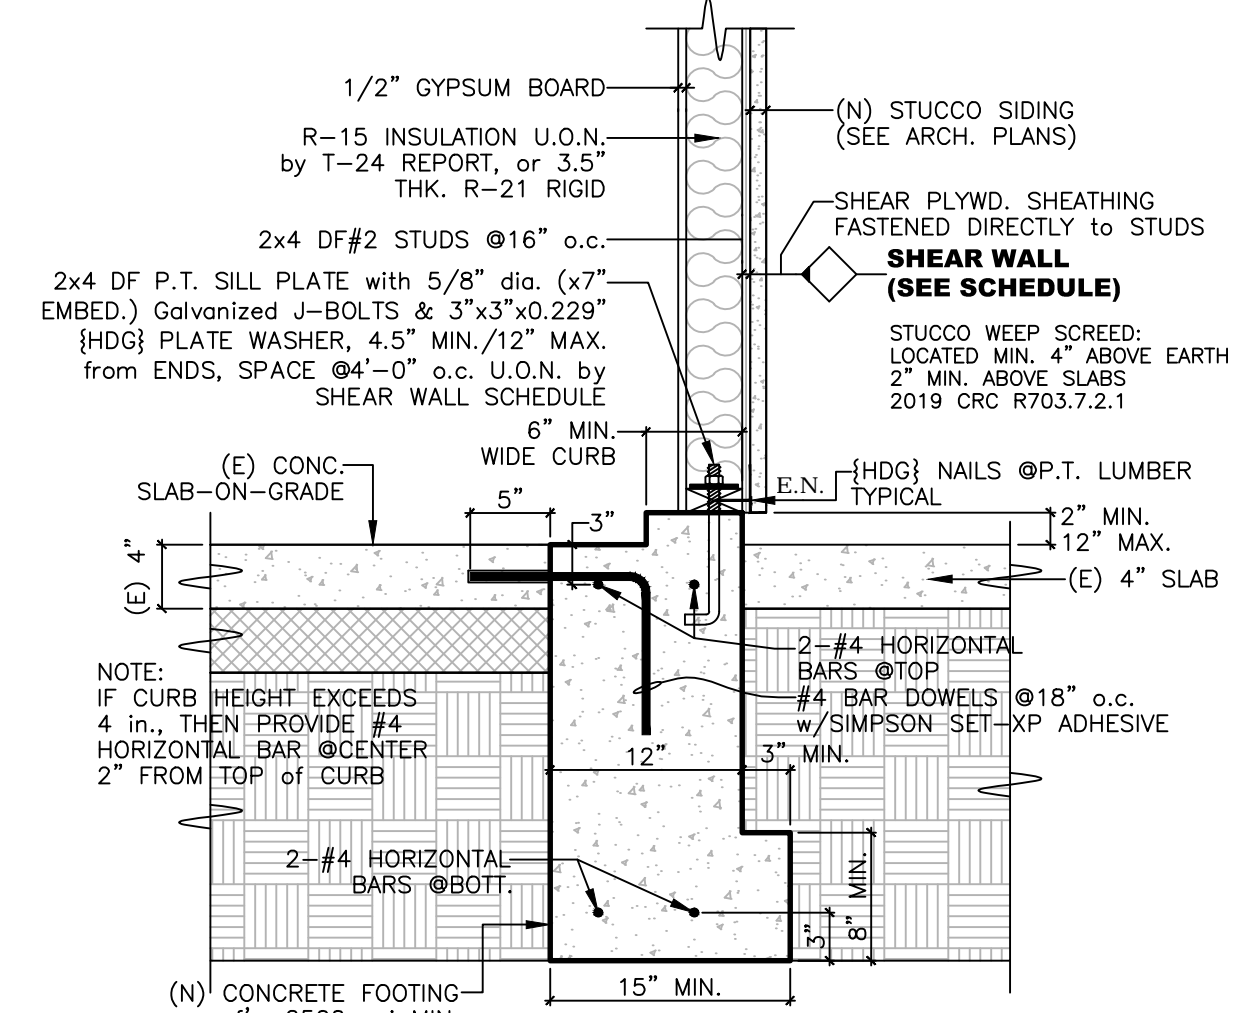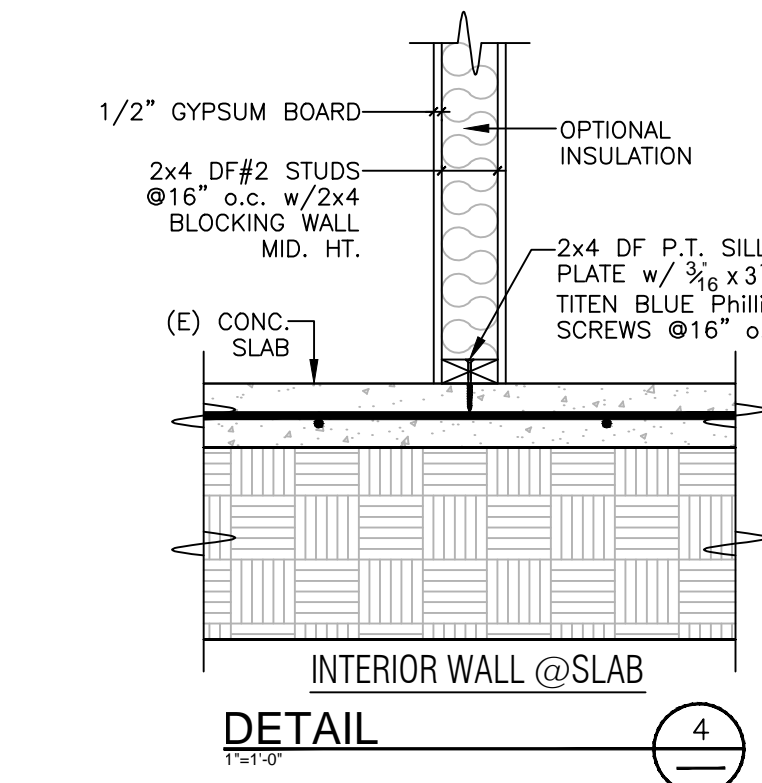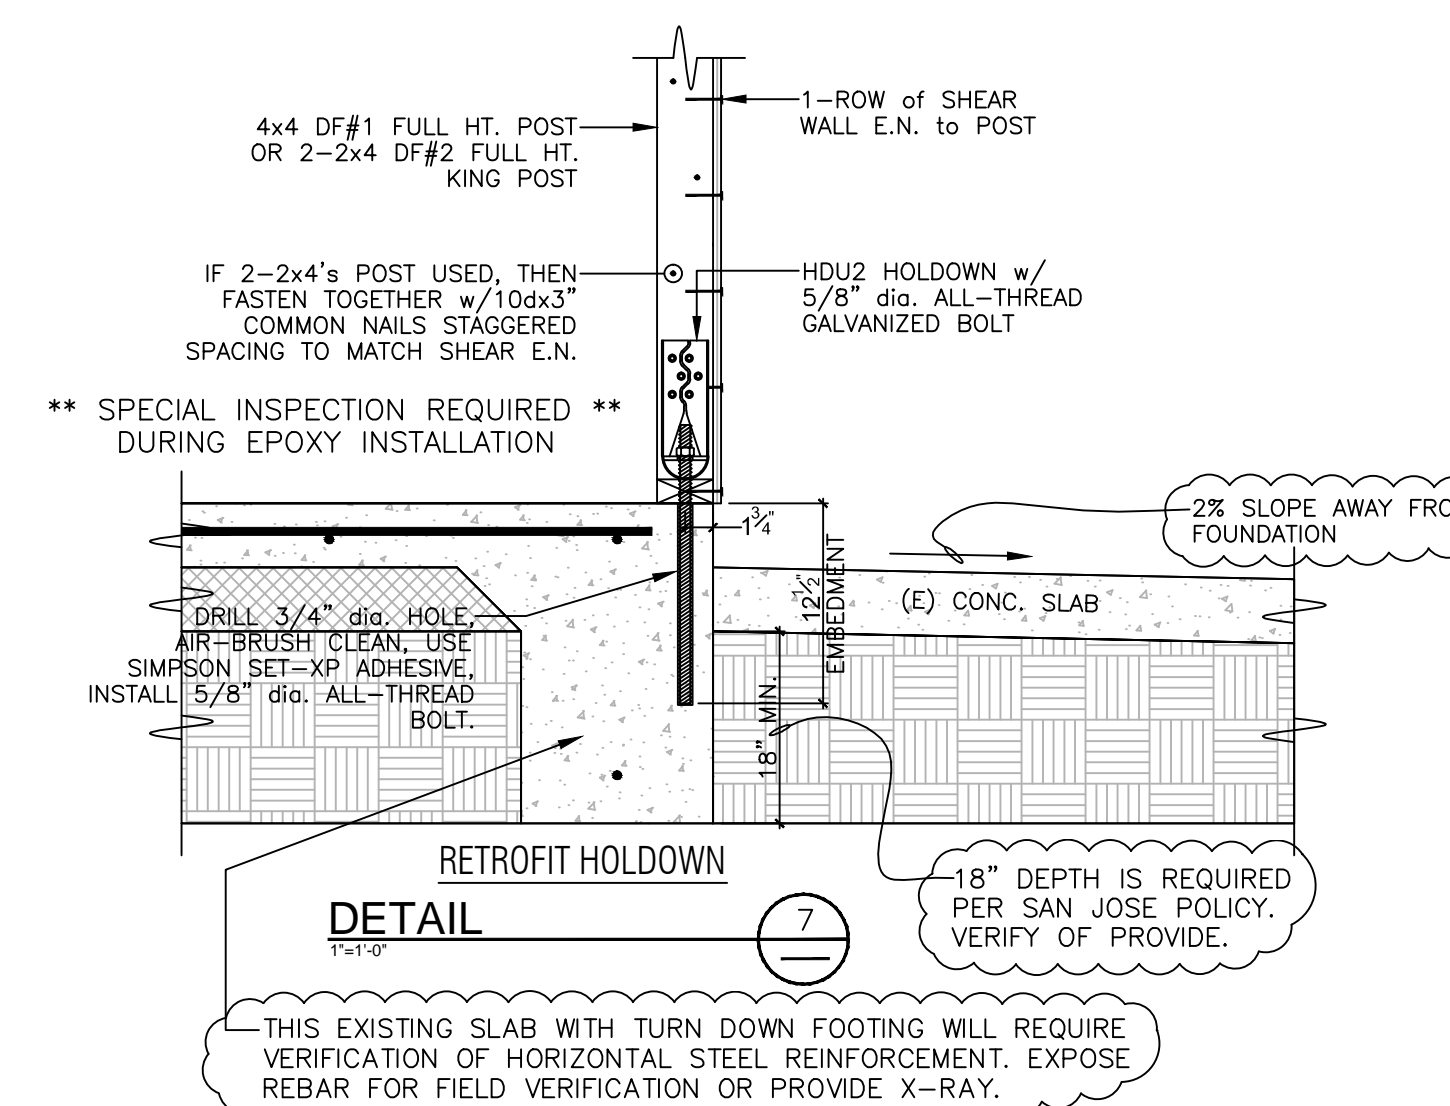

PROJECT #: 824 SCALE: 1/4"=1'-0"
DRAWN BY: YI, JI
PROJECT MANAGER: JI
ENGINEERED BY: JI
REVIEWED BY: JI

Structural
Details

SD.4



JOB TITLE
 Vesa Residence
 684 N. Redwood Ave.
 San Jose, CA 95128


DATE ISSUE:
 7/6/2022
 1/9/2023 PER BUILDING DEPARTMENT PLAN CHECK

THESE STRUCTURAL DRAWINGS WERE PRODUCED BY ISE. THE USE OF THESE PLANS AND SPECIFICATIONS SHALL BE RESTRICTED TO THE ORIGINAL SITE FOR WHICH THEY WERE PREPARED, AND PUBLICATION THEREOF IS EXPRESSLY LIMITED TO SUCH USE. RE-USE, REPRODUCTION, OR PUBLICATION BY ANY METHOD, IN WHOLE OR IN PART, IS PROHIBITED. FURTHERMORE, TITLE TO THE PLANS AND SPECIFICATIONS REMAINS WITH ISE. VISUAL CONTACT WITH THESE PLANS AND SPECIFICATIONS CONSTITUTE PROOF OF ACCEPTANCE OF ALL RESTRICTIONS.
 Copyright © 2022 ISE Ingram Structural Engineering






PROJECT #: 824 SCALE: 1/4"=1'-0"
 DRAWN BY: YI, JI
 PROJECT MANAGER: JI
 ENGINEERED BY: JI
 REVIEWED BY: JI

Structural Details

SD.5

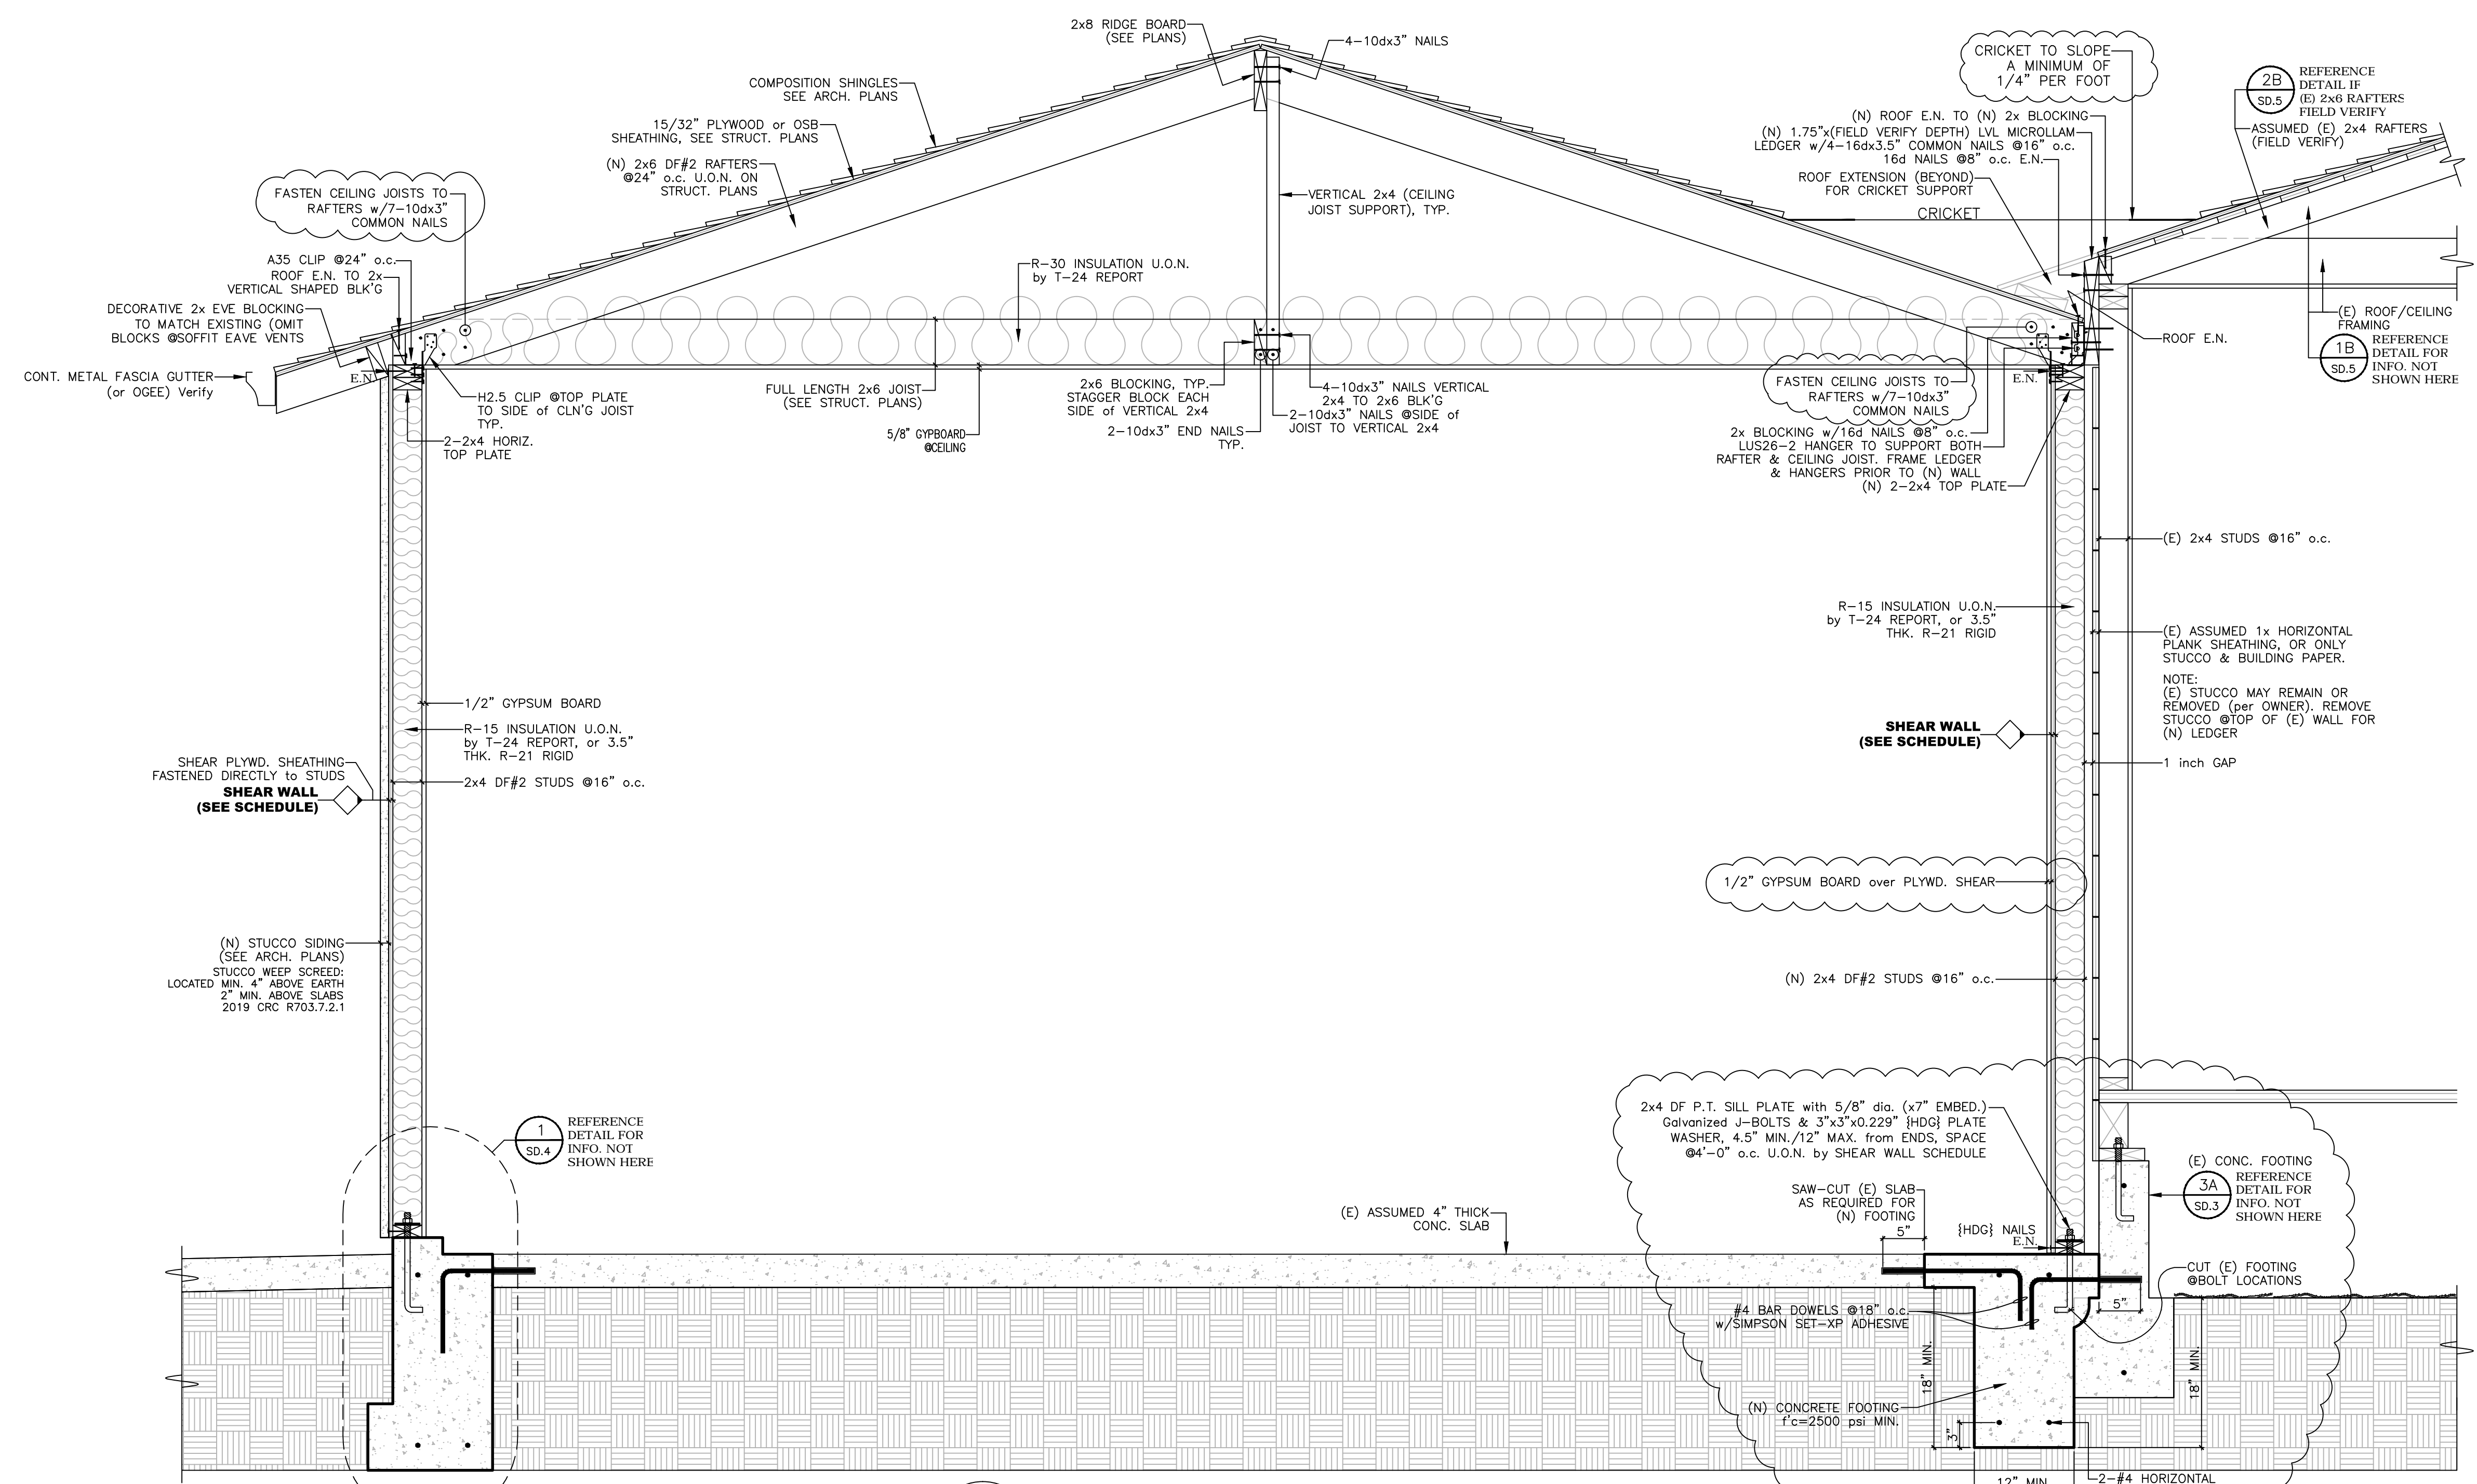

A Cross Section
 1"=1'-0"

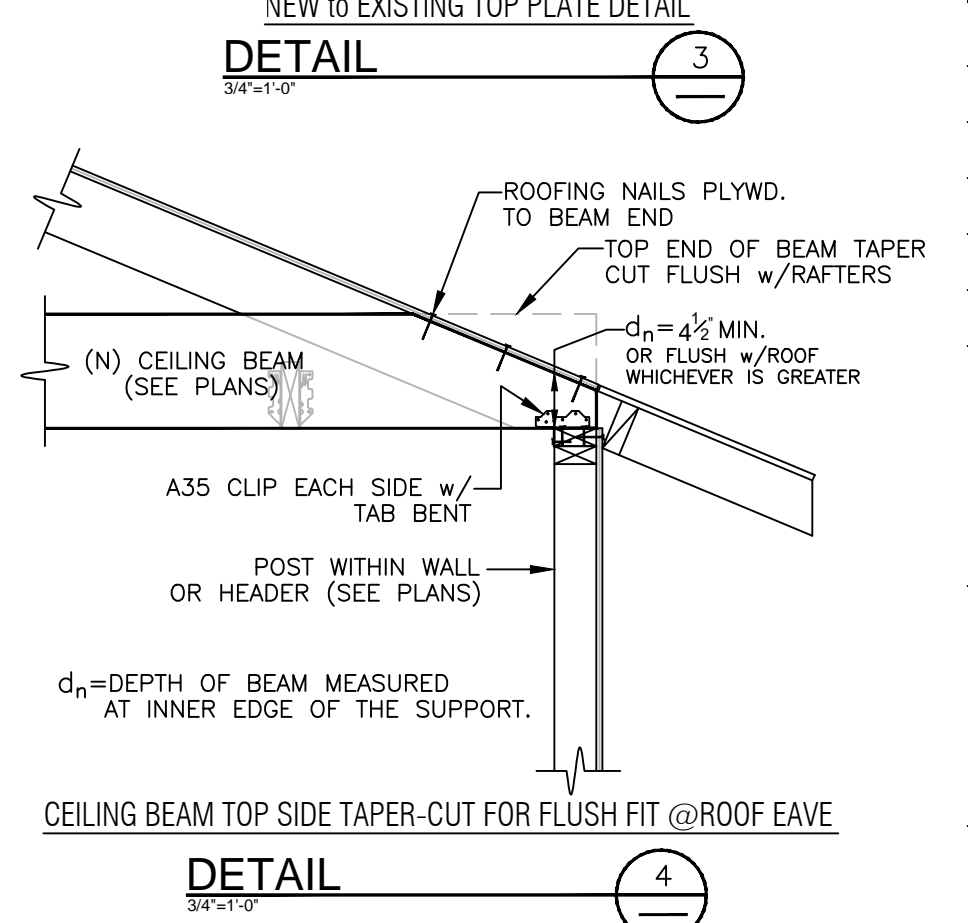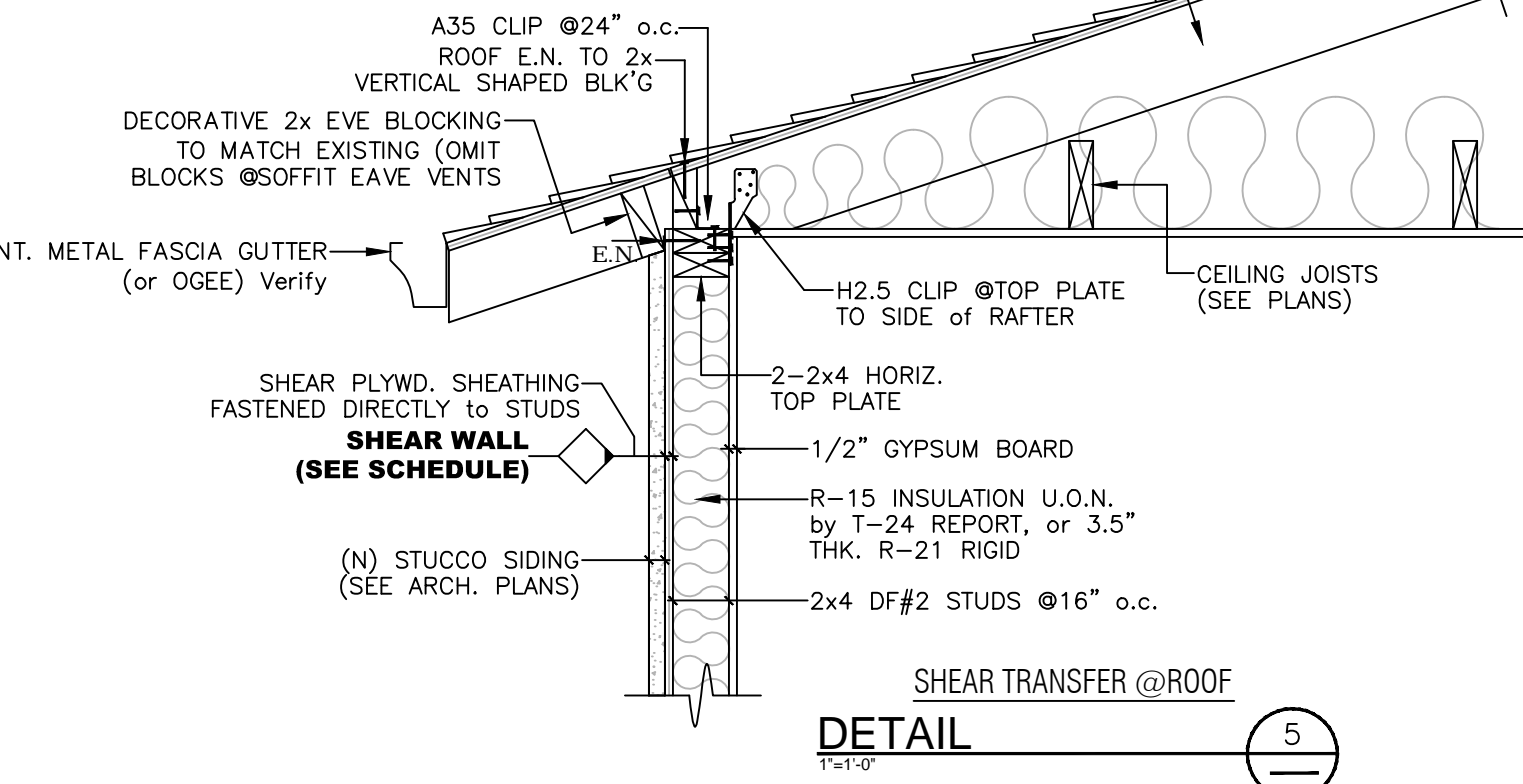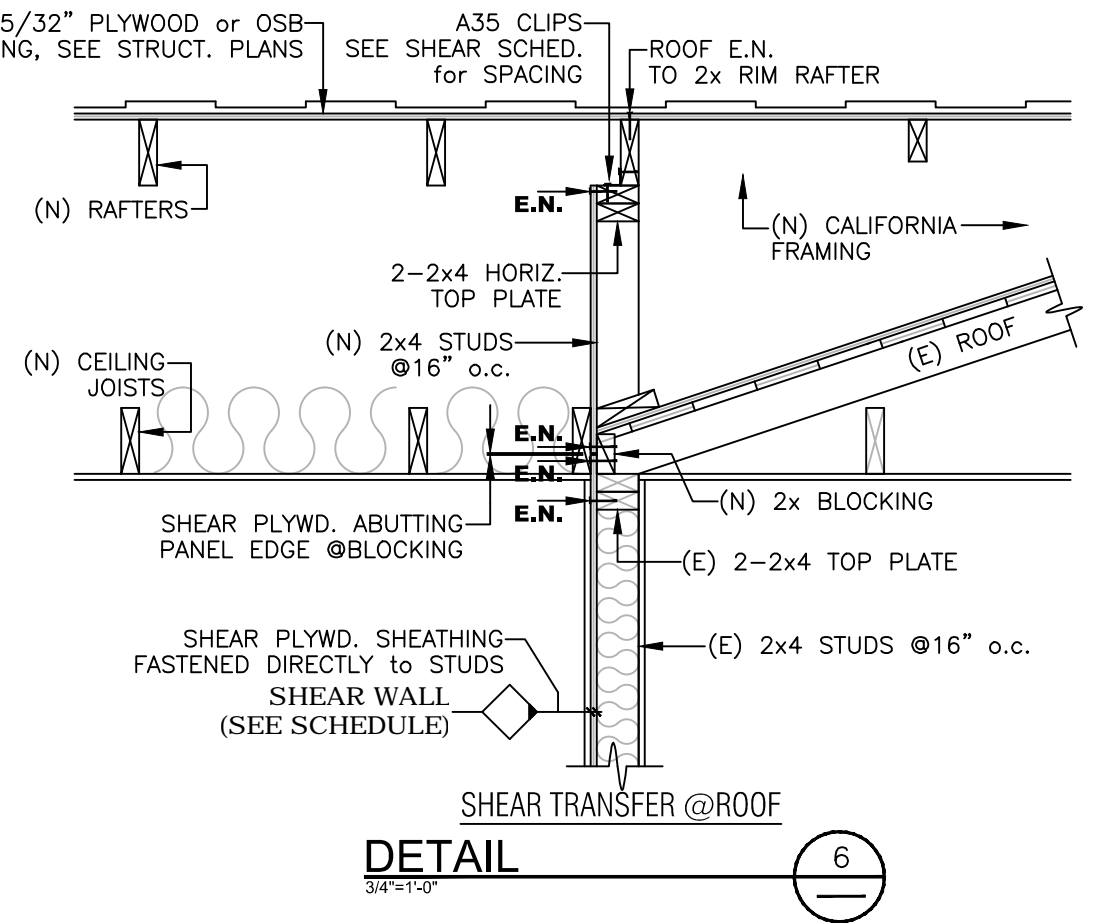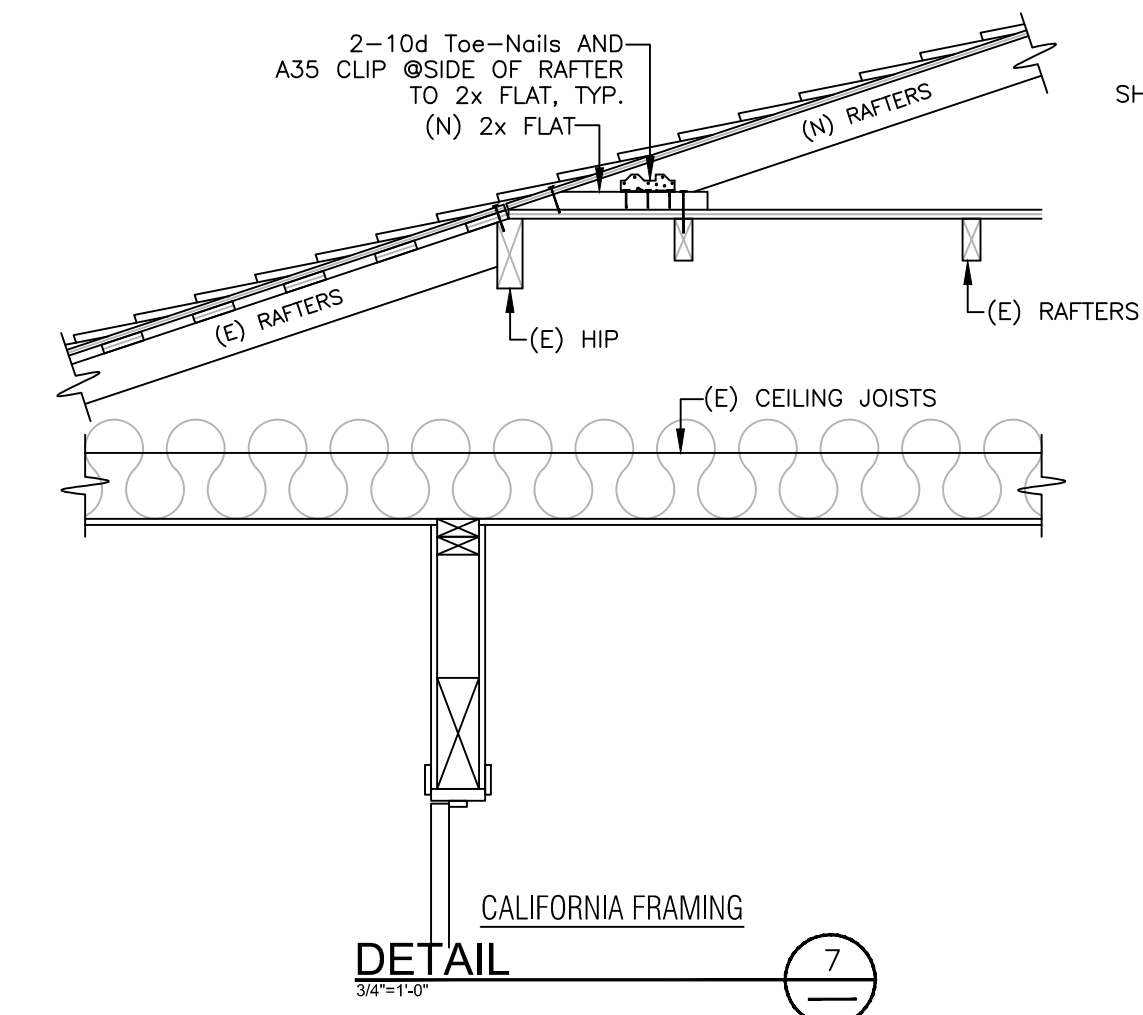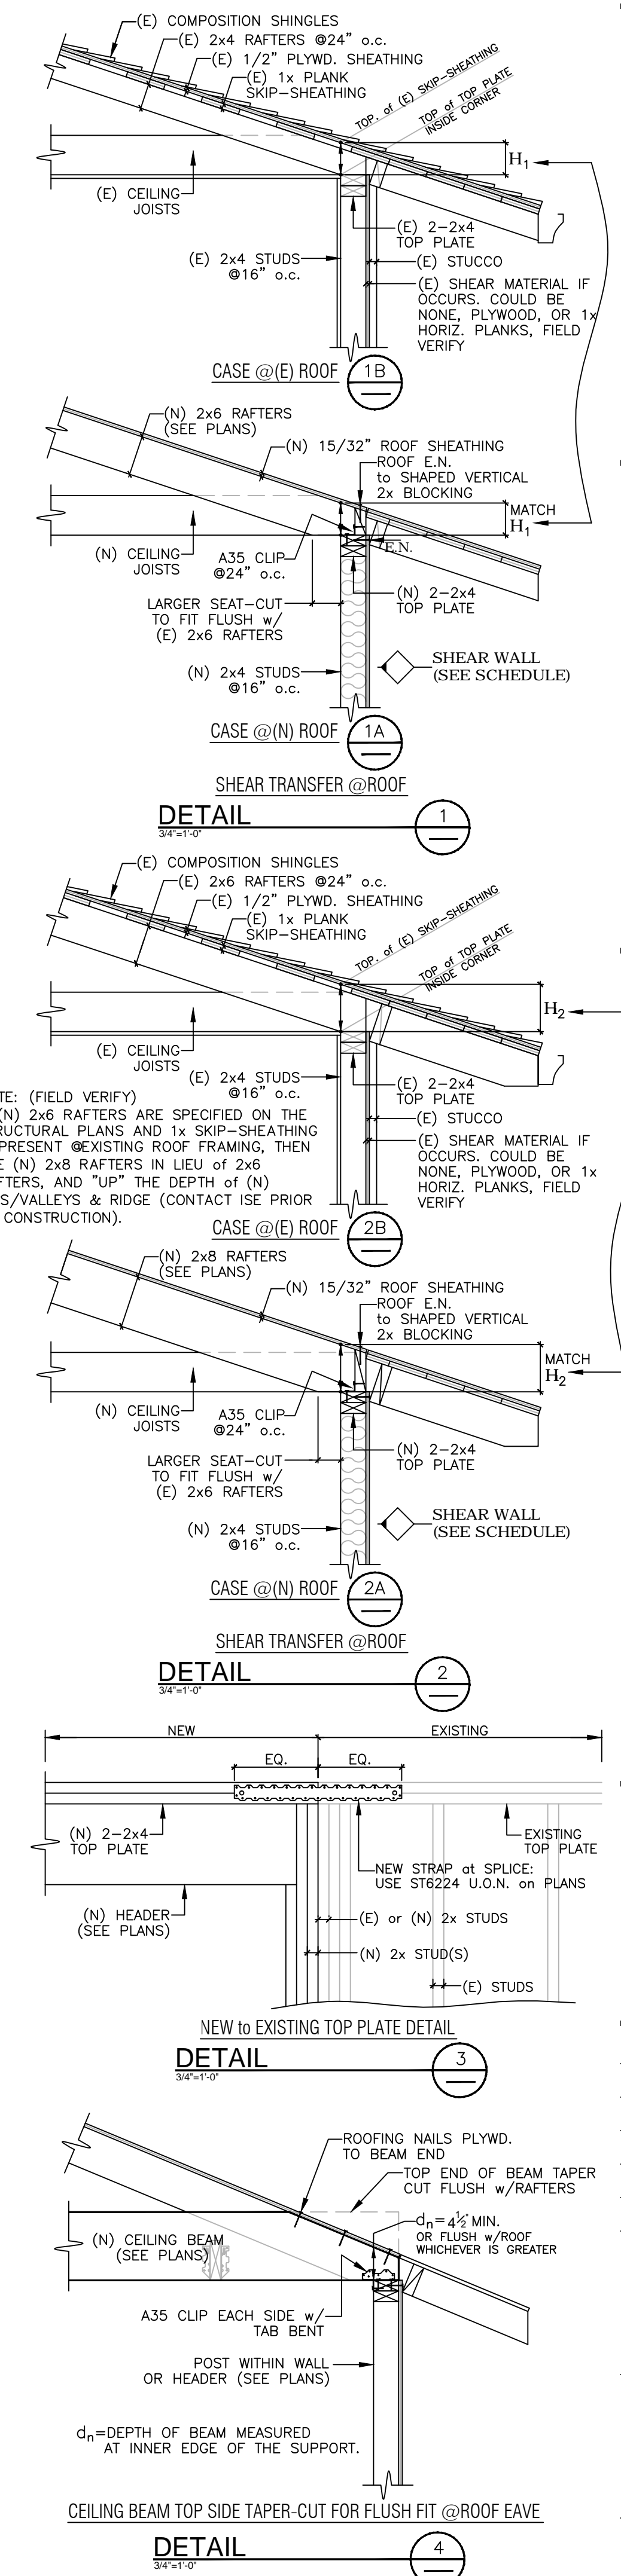

PROJECT # 824 SCALE: 1/4"=1'-0"
 DRAWN BY: YI, JI
 PROJECT MANAGER: JI
 ENGINEERED BY: JI
 REVIEWED BY: JI